Date Issued 3/24/26


C of A (s) No ~~78554~~ 54266

T C No

MECKLENBURG COUNTY HEALTH DEPARTMENT

ENVIRONMENTAL HEALTH DIVISION

PLOT PLAN SHEET

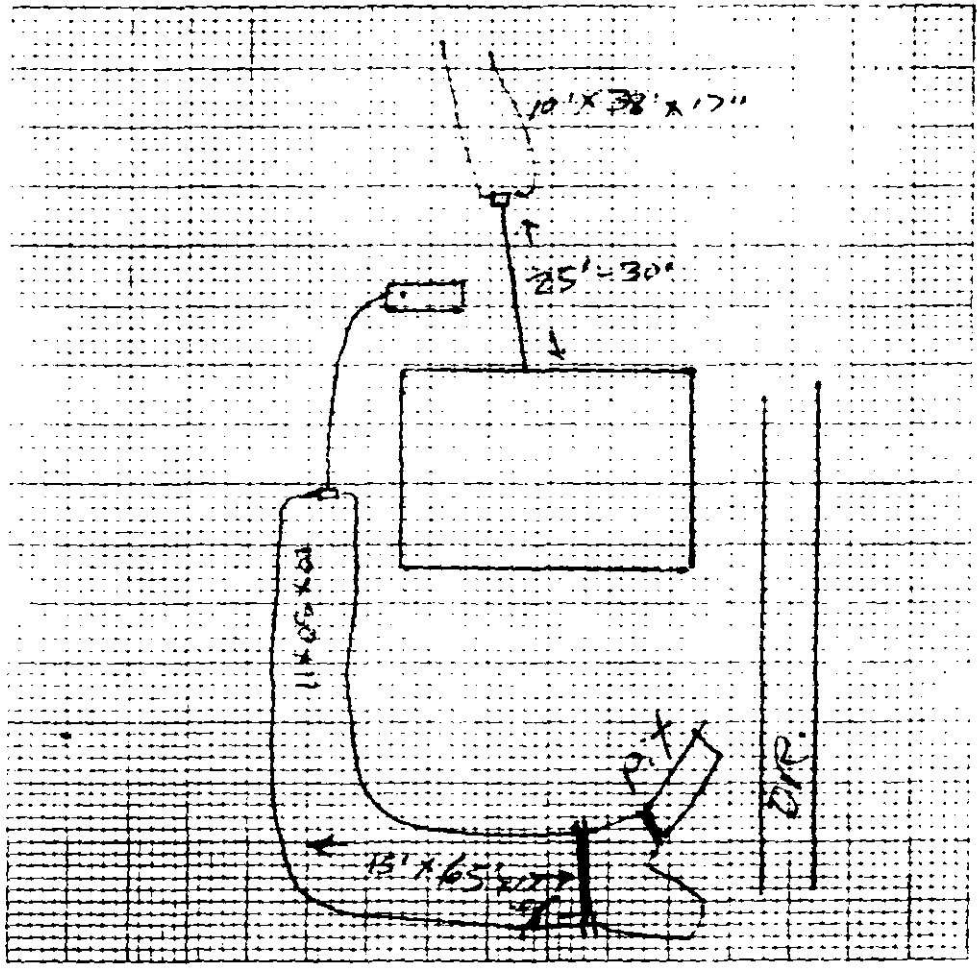

PLOT PLAN

ACCURATE DIAGRAM OF SYSTEM AS INSTALLED

L B Burleson

Environmentalist

FORM NO E-7-7-1-70

HEALTH DEPARTMENT'S COPY

Serial No. 6777

C of A (s) No. 5474

Date Issued 3/26/76

T C No 137-07[illegible]29

Map Date 9-5-23

CERTIFICATE OF COMPLETION

MECKLENBURG COUNTY HEALTH DEPARTMENT

ENVIRONMENTAL HEALTH DIVISION

CERTIFICATE OF APPROVAL

(Individual Septic Tank System with Subsurface, Soil Absorption, Effluent Discharge)

Name of Owner FREELAND (LAST) ROBT. M. (FIRST) (FOR SALE) (MIDDLE)

Location of Property 8600 Will[illegible] Rd.

Application Number ~~7324~~ 5474

Permit Number ~~5474~~

Inspection Date:

Liquid Capacity of Tank ~~1000 gal~~ 3T 1000 gal

Tank Material ~~PC~~ 3T PVC

Total Length of Drain Tile ~~600~~ 150

Number of Lines 6 4

Depth of Filter Material 12"

Cover Depth 2'

Water Supply Source ~~[illegible]~~

Distance from Water Source —

Excavation Inspected 3-26-76 (DATE)

Tank Inspected 3-26-76 (DATE)

Nitrification Field Inspected 3-26-76 (DATE)

Washing Machine Line Inspected, If Applicable 3-26-76 (DATE)

This [illegible] Septic Tank System with subsurface soil absorption effluent [illegible] and has been X installed or constructed in accordance with the permit issued and the regulations of the Mecklenburg County Board of Health at the date of issuance of the permit. The issuance of this Certificate of Approval is evidence that the system will operate properly and relieves any person from or holds harmless any person owning such system from any liability resulting from the failure of the system to operate properly. This Certificate of Approval is issued subject to those restrictions and conditions appearing on the permit in addition to those listed below under comments. This Certificate of Approval shall be void and of no effect if any information contained in the application is untrue or if any additions are made to the property which would increase the requirements for said system.

Comments Permit changed because of unknown spoil pit on side of house.

[signature] Sanitarian

Environmentalist

FORM NO E-6-9-1-72

[illegible] DEPARTMENT