

12/20/2007

duponbj

Groundwater and Wastewater Services File Imaging Project

May 2007

Barcode Font = IDAutomationHC39M

FEE: 100.00
DATE: 4/1/96
Chk #266

APPLICATION FOR IMPROVEMENT PERMIT FOR RESIDENTIAL SITE INDIVIDUAL WATER AND WASTEWATER SYSTEMS PROGRAM

[ ] CRT

TYPE APPLICATION: ✓ NEW SYSTEM ___ EXPANSION/ ALTERATION OF EXISTING SYSTEM ___ REPAIR OF EXISTING SYSTEM

NORTH CAROLINA
DEPARTMENT OF ENVIRONMENT,
HEALTH, AND NATURAL RESOURCES
DIVISION OF ENVIRONMENTAL HEALTH
ON-SITE WASTEWATER SECTION

FILE #: 12328B

PROPERTY INFORMATION (FROM ENGINEERING FORM) FOR JOB LOCATION:

TAX/PARCEL NUMBER: Part of 13-161-01

STREET ADDRESS: Stephens Road

SUBDIVISION OR MOBILE HOME PARK NAME: Shenan Lea

LOT NUMBER: 17

TYPE OF BUILDING (CHECK ONE):

___ SINGLE MOBILE HOME(S)
___ DOUBLE WIDE (D)
___ HOUSE (H)
___ MODULAR HOME (M)
___ MULTIPLE FAMILY (U)
___ OTHER (O)

TOWNSHIP (CHECK ONE):

✓ 0 MECKLENBURG
___ 1 CHARLOTTE
___ 2 DAVIDSON
___ 3 CORNELIUS
___ 4 PINEVILLE
___ 5 MATTHEWS
___ 6 HUNTERSVILLE
___ 7 MINT HILL

HEATED SQUARE FOOTAGE:

NUMBER OF BEDROOMS: 4 NUMBER OF OCCUPANTS: 8

FOUNDATION FOR RESIDENCE:

✓ WITHOUT BASEMENT
✓ ON SLAB
✓ CRAWL SPACE
___ WITH BASEMENT /PLUMBING
___ WITH BASEMENT /NO PLUMBING

IF EXPANSION/ALTERATION OF EXISTING SYSTEM, DESCRIBE THE PROPOSED BUILDING ADDITION: None

WILL THERE BE A HOME BUSINESS IN THE RESIDENCE: ___ YES ✓ NO TYPE: _____

WATER SUPPLY (CHECK ONE):

___ COMMUNITY (C)
___ MUNICIPAL (M)
✓ PRIVATE WELL (P)
___ SHARED WELL (S)
___ OTHER 'SPRINGS' (O)

IF ANY OF THE FOLLOWING ARE LOCATED ON THE PROPERTY, PLEASE SHOW LOCATION ON PLAT:

BURIED CABLES, LANDFILLS, STUMPHOLES ___ YES ✓ NO
EXISTING WASTEWATER SYSTEMS ___ YES ✓ NO
EASTMENTS OR RIGHT-OF-WAYS (As shown) ✓ YES ___ NO
WELL, SPRINGS OR WATERLINES ___ YES ✓ NO
DESIGNATED WETLANDS ___ YES ✓ NO

PROPERTY OWNER: Shenan Lea LLC

NAME: (LAST) McLeod (FIRST) Steve (MI)

ADDRESS: 19701-D Hwy 73

CITY: Davidson STATE: NC ZIP: 28036

DAYTIME PHONE: (704) 896-5552

LEGAL AGENT FOR PROPERTY OWNER, IF APPLICABLE:

NAME: (LAST) Jacobs (FIRST) Tony (MI) C


DAYTIME PHONE: 704 633-6905

WHAT DATE WAS THE PROPERTY ORIGINALLY DEEDED AND RECORDED? Spring 96


An Improvement Permit is subject to suspension or revocation if site plans or the intended use change or if information submitted in this application is falsified or changed. The undersigned, owner, or legal agent for the owner, of the property described above as the "Job Location" has read the foregoing application, acknowledges that the contents of same are true, and authorizes agents of the Mecklenburg County Health Department to enter onto the property for the purpose of processing this request.

SIGNED: Tony C Jacobs, CPSS DATE: 3/28/96

MECKLENBURG COUNTY HEALTH DEPARTMENT
ENVIRONMENTAL HEALTH DIVISION
c/o HAL MARSHALL CTR., SUITE 211, 700 N. TRYON ST., CHARLOTTE, N.C. 28202., (704) 336-5102

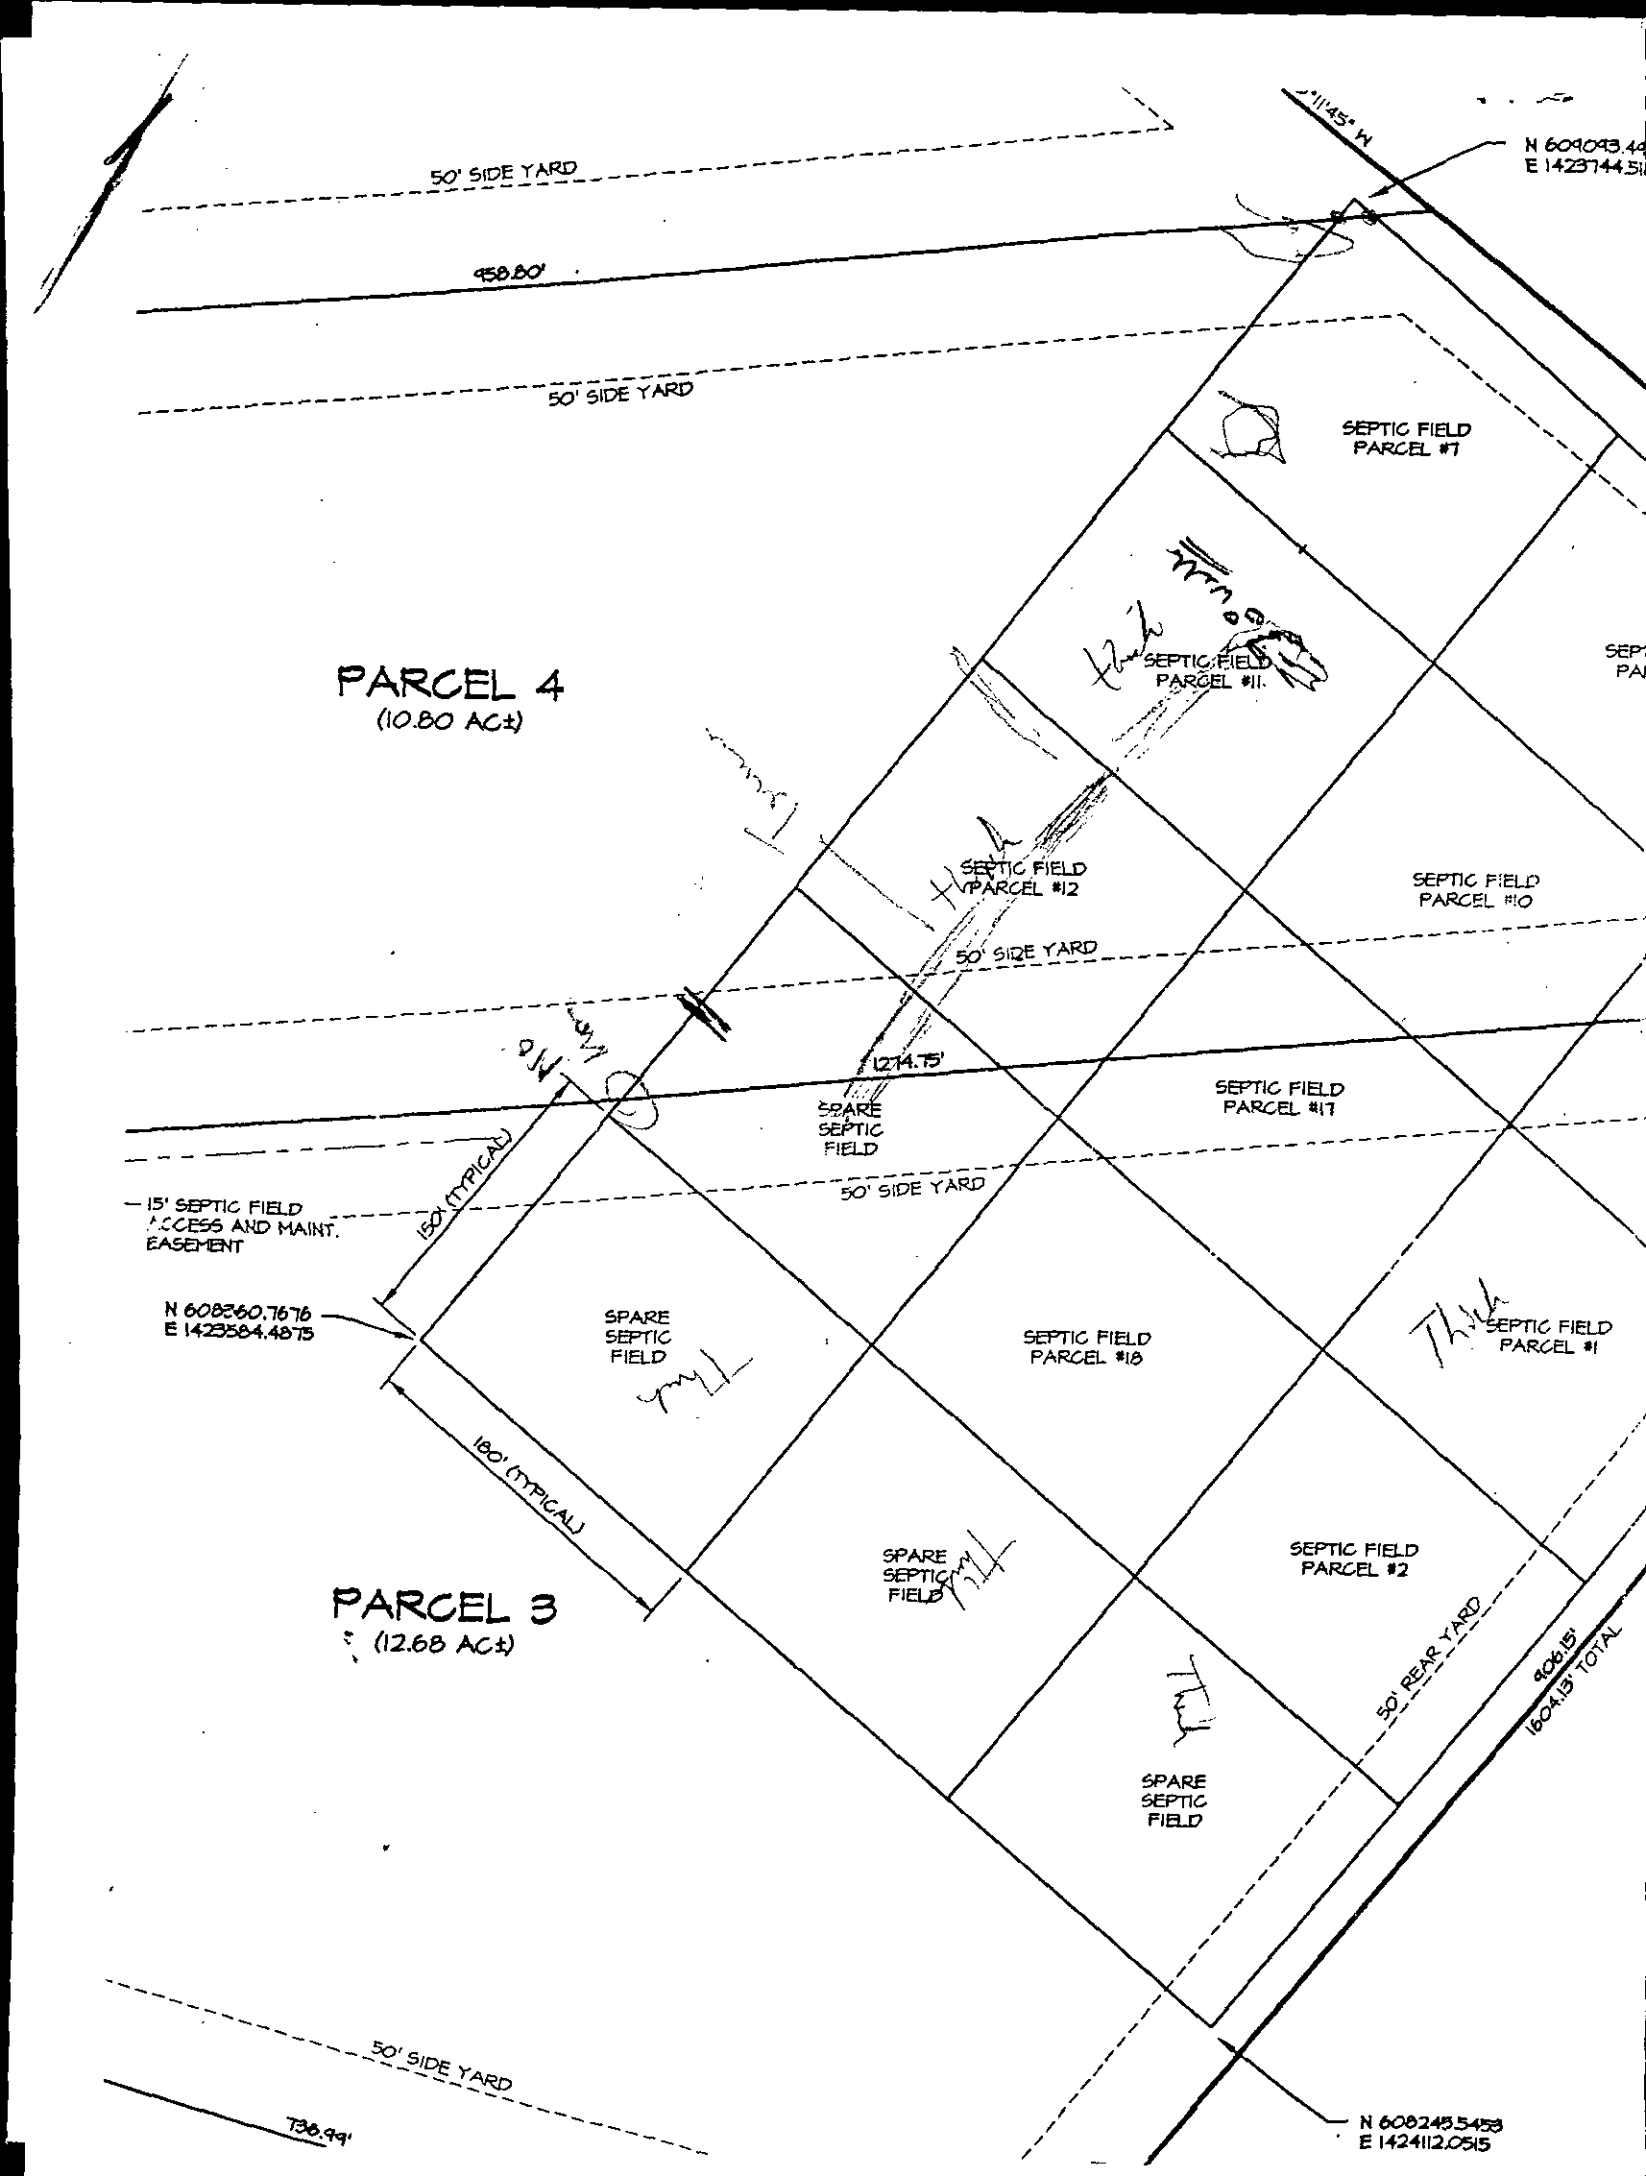
50' SIDE YARD
50' SIDE YARD
N 609093.44
E 1423744.51
SEPTIC FIELD PARCEL #7
PARCEL 4
(10.80 AC±)
SEPTIC FIELD PARCEL #11
SEPTIC FIELD PARCEL #12
SEPTIC FIELD PARCEL #10
50' SIDE YARD
1274.75'
SPARE SEPTIC FIELD
SEPTIC FIELD PARCEL #17
50' SIDE YARD
15' SEPTIC FIELD ACCESS AND MAINT. EASEMENT
150' (TYPICAL)
N 608360.7676
E 1423584.4875
SPARE SEPTIC FIELD
SEPTIC FIELD PARCEL #18
SEPTIC FIELD PARCEL #1
180' (TYPICAL)
SPARE SEPTIC FIELD
SEPTIC FIELD PARCEL #2
PARCEL 3
(12.68 AC±)
50' REAR YARD
1604.13' TOTAL
SPARE SEPTIC FIELD
50' SIDE YARD
736.99'
N 608245.5458
E 1424112.0515

STEPHENS ROAD PROPERTY
SEPTIC FIELD STAKING PLAN
SCALE: 1" = 100'
SHEET 1 OF 2
H2595 3.16.96

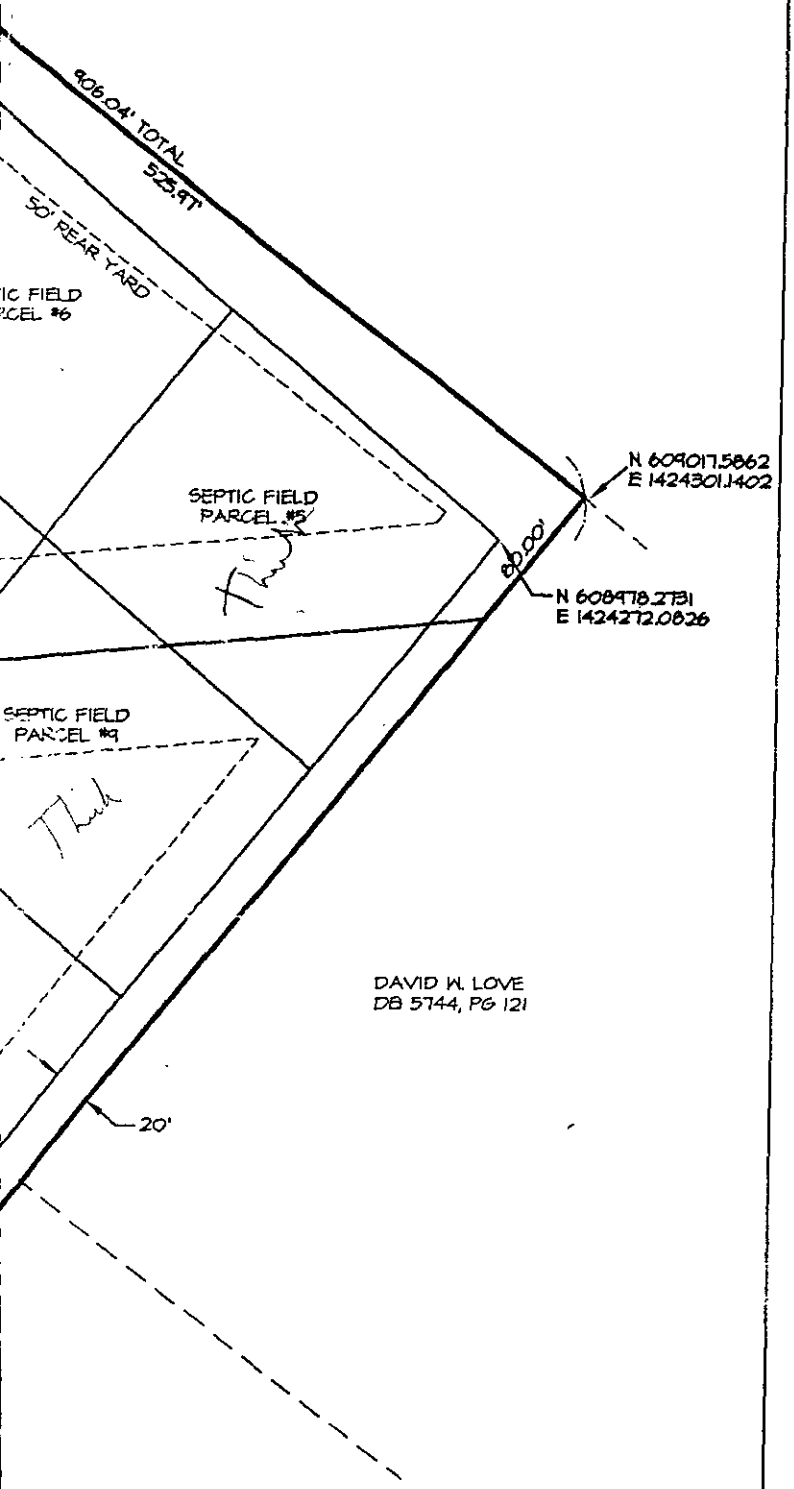

DEPARTMENT OF ENVIRONMENT, HEALTH, AND NATURAL RESOURCES
DIVISION OF ENVIRONMENTAL HEALTH
ON-SITE WASTEWATER SECTION

Sheet ___ of ___
PROPERTY ID #: ___
COUNTY: ___

SOIL/SITE EVALUATION for ON-SITE WASTEWATER SYSTEM

#1 1328B
PO 013-161-01
L17

OWNER: Sherman Lee, Steve McLeod APPLICANT: ___
ADDRESS: 19701-D Highway 73, Davidson APPLICATION DATE: ___ DATE EVALUATED: ___
PROPOSED FACILITY: residence PROPOSED DESIGN FLOW (.1949): 440gpd PROPERTY SIZE: .61 ac
LOCATION OF SITE: off Stephens Road PROPERTY RECORDED: ___
WATER SUPPLY: ☑ Private ☐ Public ☐ Well ☐ Spring ☐ Other ___
EVALUATION METHOD: ☑ Auger Boring ☐ Pit ☐ Cut
TYPE OF WASTEWATER: ☑ Sewage ☐ Industrial Process ☐ Mixed

PROFILE #	1940 LAND-SCAPE POSITION/ SLOPE % (Slopes 3-10%)	HORI-ZON DEPTH (IN.)	SOIL MORPHOLOGY (.1941) STRUCTURE/ TEXTURE	SOIL MORPHOLOGY (.1941) CONSISTENCE/ MINERALOGY	OTHER PROFILE FACTORS .1942 SOIL WETNESS/ COLOR	.1943 SOIL DEPTH	.1956 SAPRO CLASS	.1944 RESTR HORIZ	PROFILE CLASS & LTAR
1	LS	0-4"	gr/cl	Fr/SEXP/SS/SP	>46" to chroma 2 MoHles	46"	N/A	None	PS IV .3gal/ft2
		4-24"	SBK/c	Fr-Fi/SEXP/SP					
		24-46"	SBK/cl	Fr/SEXP/SS/SP					
2	LS	0-3"	gr/cl	Fr/SEXP/SS/SP	>46" to chroma 2 MoHles	46"	N/A	None	PS IV .3gal/ft2
		3-29"	SBK/c	Fr-Fi/SEXP/SP					
		29-46"	SBK/cl	Fr/SEXP SS/SP					
3	LS	0-10"	gr/cl	Fr/SEXP/SS/SP	>46" to chroma 2 MoHles	46"	N/A	None	PS IV .3gal/ft2
		10-46"	SBK/c	Fr-Fi/SEXP/SP					
4	LS	0-6"	gr/cl	Fr/SEXP/SS/SP	>46" to chroma 2 MoHles	46"	N/A	None	PS IV .3gal/ft2
		6-27"	SBK/c	Fr-Fi/SEXP/SP					
		27-46"	SBK/cl	Fr/SEXP/SS/SP					

DESCRIPTION	INITIAL SYSTEM	REPAIR SYSTEM
Available Space (.1945)	PS	OS
System Type(s)		

OTHER FACTORS (.1946): ___
SITE CLASSIFICATION (.1948): Provisionally Suitable
EVALUATED BY: William R. Marsh 4-26-94
OTHER(S) PRESENT: ___

OMMENTS: 100% Repair - would be pumped to mound
site offset

LEGEND

use the following standard abbreviations


ANDSCAPE POSITION	GROUP	SOIL TEXTURE	CONVENTIONAL .1955 LTAR	LPP .1957 LTAR	MINERALOGY/ CONSISTENCE	STRUCTURE
C (Concave Slope) V (Convex Slope) (Drainage Way) S (Debris Slump) P (Flood Plain) S (Foot Slope) (Head Slope) (Linear Slope) (Nose Slope) (Ridge) (Shoulder Slope) (Terrace)	I	S (Sand) LS (Loamy Sand)	1.2 - 0.8	0.6 - 0.4	NEXP (Non-expansive) SEXP (Slightly Expansive) EXP (Expansive)	G (Single Grain) M (Massive) CR (Crumb) GR (Granular) SBK (Subangular Blocky) ABK (Angular Blocky) PL (Platy) PR (Prismatic)
	II	SL (Sandy Loam) L (Loam)	0.8 - 0.6	0.4 - 0.3		
	III	SI (Silt) SICL (Silty Clay Loam) CL (Clay Loam) SCL (Sandy Clay Loam) SLC (Silt Loam Clay)	0.6 - 0.3	0.3 - 0.15		
					MOIST	WET
	IV	SC (Sandy Clay) SIC (Silty Clay)	0.4 - 0.1	0.2 - 0.05	VFR (Very Friable) FR (Friable) FI (Firm) VFI (Very Firm v. Very Sticky) EFI (Extremely Firm)	NS (Non-sticky) SS (Slightly Sticky) S (Sticky) VS (Very Sticky) NP (Non-plastic) SP (Slightly Plastic) P (Plastic) VP (Very Plastic)
		O (Organic)	None			

OTES

ORIZON DEPTH	In inches below natural soil surface
EPTH OF FILL	In inches from land surface
ESTRUCTIVE HORIZON	Thickness and depth from land surface
IPROLITE	S(suitable) or U(unsuitable)
OIL WETNESS	Inches from land surface to free water or inches from land surface to soil colors with chroma 2 or less - record Munsell color chip designation
LASSIFICATION	S (Suitable), PS (Provisionally Suitable), or U (Unsuitable)

valuation of saprolite shall be by pits.
ong-term Acceptance Rate (LTAR): gal/day/ft²

Show profile locations and other site features (dimensions, reference or benchmark, and North).

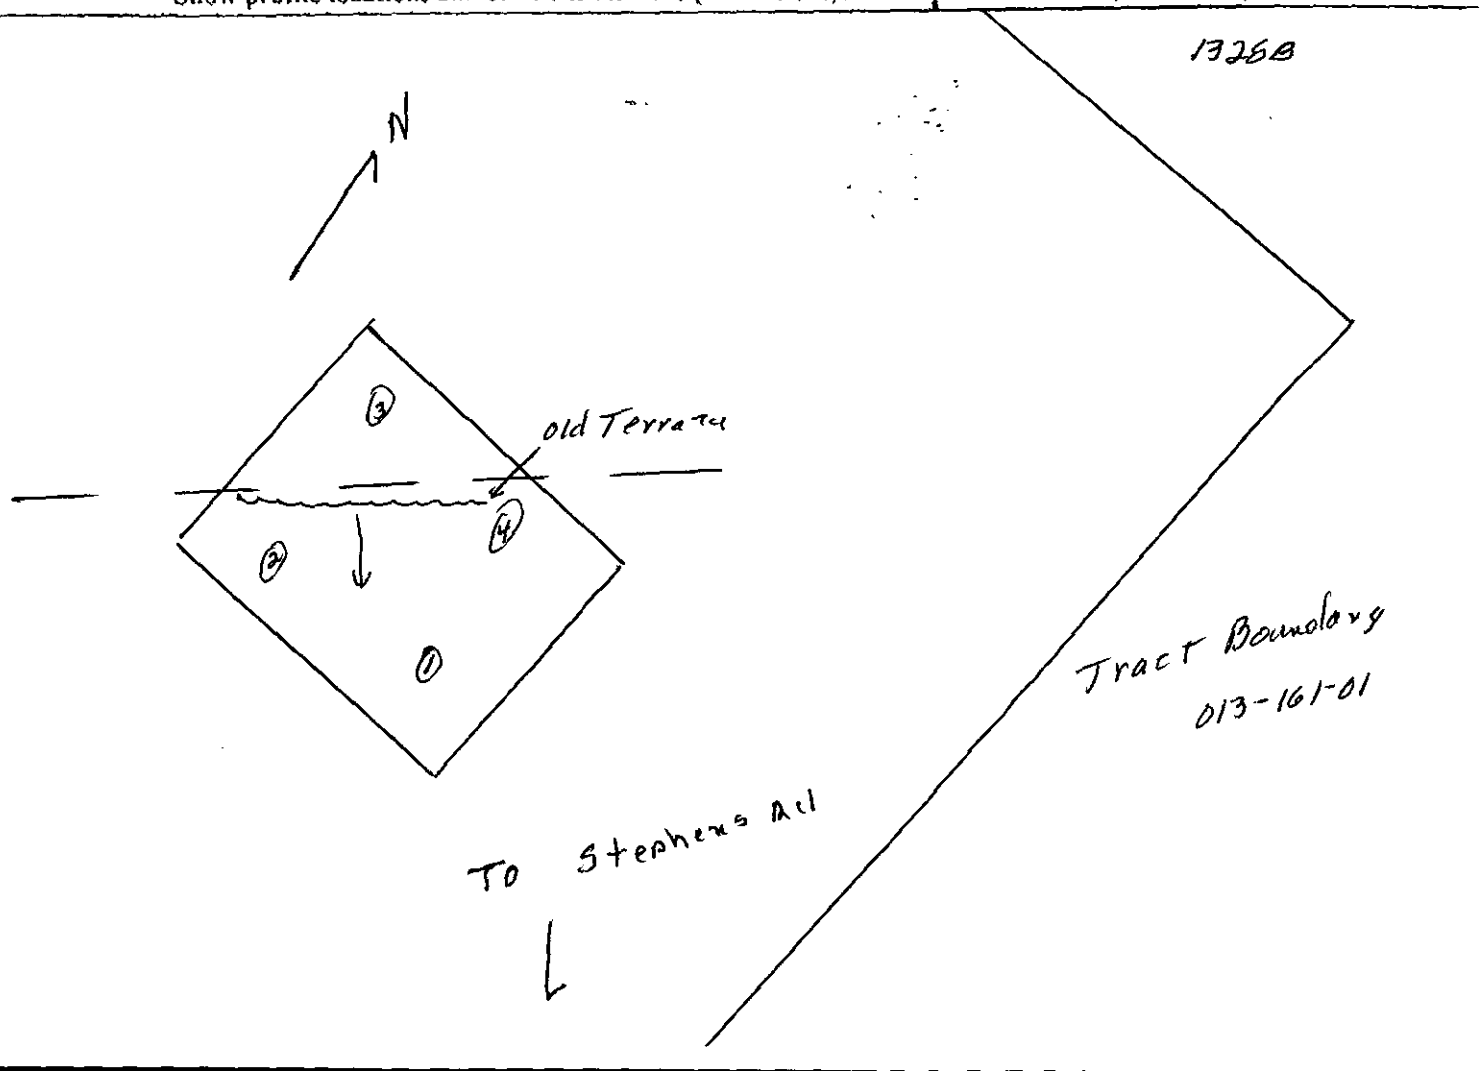

FEE: 100.00
DATE: 4/1/96
check #266

APPLICATION FOR IMPROVEMENT PERMIT FOR RESIDENTIAL SITE INDIVIDUAL WATER AND WASTEWATER SYSTEMS PROGRAM

[ ] CRT

TYPE APPLICATION: ✓ NEW SYSTEM __ EXPANSION/ ALTERATION OF EXISTING SYSTEM __ REPAIR OF EXISTING SYSTEM

NORTH CAROLINA
DEPARTMENT OF ENVIRONMENT,
HEALTH, AND NATURAL RESOURCES
DIVISION OF ENVIRONMENTAL HEALTH
ON-SITE WASTEWATER SECTION

FILE #: 13288

PROPERTY INFORMATION (FROM ENGINEERING FORM) FOR JOB LOCATION:

TAX/PARCEL NUMBER: Part of 13-161-01

STREET ADDRESS: Stephens Road

SUBDIVISION OR MOBILE HOME PARK NAME: Shenan Lea

LOT NUMBER: 17

TYPE OF BUILDING (CHECK ONE):

__ SINGLE MOBILE HOME(S) __ MODULAR HOME (M)
__ DOUBLE WIDE (D) __ MULTIPLE FAMILY (U)
__ HOUSE (H) __ OTHER (O)

TOWNSHIP (CHECK ONE):

✓ 0 MECKLENBURG __ 4 PINEVILLE
__ 1 CHARLOTTE __ 5 MATTHEWS
__ 2 DAVIDSON __ 6 HUNTERSVILLE
__ 3 CORNELIUS __ 7 MINT HILL

HEATED SQUARE FOOTAGE:

NUMBER OF BEDROOMS: 4 NUMBER OF OCCUPANTS: 8

FOUNDATION FOR RESIDENCE:

✓ WITHOUT BASEMENT
✓ ON SLAB
✓ CRAWL SPACE
__ WITH BASEMENT /PLUMBING
__ WITH BASEMENT /NO PLUMBING

COPY

IF EXPANSION/ALTERATION OF EXISTING SYSTEM, DESCRIBE THE PROPOSED BUILDING ADDITION: None

WILL THERE BE A HOME BUSINESS IN THE RESIDENCE: __ YES ✓ NO TYPE: _____

WATER SUPPLY (CHECK ONE):

__ COMMUNITY (C) __ MUNICIPAL (M) ✓ PRIVATE WELL (P)
__ SHARED WELL (S) __ OTHER 'SPRINGS' (O)

IF ANY OF THE FOLLOWING ARE LOCATED ON THE PROPERTY, PLEASE SHOW LOCATION ON PLAT:

BURIED CABLES, LANDFILLS, STUMPHOLES __ YES ✓ NO
EXISTING WASTEWATER SYSTEMS __ YES ✓ NO
EASTMENTS OR RIGHT-OF-WAYS (as shown) ✓ YES __ NO
WELL, SPRINGS OR WATERLINES __ YES ✓ NO
DESIGNATED WETLANDS __ YES ✓ NO

PROPERTY OWNER: Shenan Lea LLC

NAME: (LAST) McLeod (FIRST) Steve (MI)

ADDRESS: 19701-D Hwy 73

CITY: Davidson STATE: NC ZIP: 28036

DAYTIME PHONE: (704) 896-5552

LEGAL AGENT FOR PROPERTY OWNER, IF APPLICABLE:

NAME: (LAST) Jacobs (FIRST) Tonya (MI) C

DAYTIME PHONE: 704 633-6905

WHAT DATE WAS THE PROPERTY ORIGINALLY DEEDED AND RECORDED? Spring 96

An Improvement Permit is subject to suspension or revocation if site plans or the intended use change or if information submitted in this application is falsified or changed. The undersigned, owner, or legal agent for the owner, of the property described above as the "Job Location" has read the foregoing application, acknowledges that the contents of same are true, and authorizes agents of the Mecklenburg County Health Department to enter onto the property for the purpose of processing this request.

SIGNED: Tonya C Jacobs, CPSS DATE: 3/28/96

MECKLENBURG COUNTY HEALTH DEPARTMENT
ENVIRONMENTAL HEALTH DIVISION
c/o HAL MARSHALL CTR., SUITE 211, 700 N. TRYON ST., CHARLOTTE, N.C. 28202., (704) 336-5102

1-0-411-1

4-24"C

24-46"C1

2-0-3"C1

3-29"C

29-46 C1

3-0-10-C1

10-46 C

4-0-6-C1

6-27"C

27-46-C1