## Groundwater & Wastewater Services
### Septic Project File & Data Review Worksheet

GWS File #: 7167B WASPS App #: _____

Primary ES assigned to project: Jeremy Michael

Secondary ES assigned to project: Brad Hellman

Project Type: New System ☐ Alteration ☐ Repair ☐ Modified Plot Plan ☐

**I. File Review:**

| Rule or Law | Permit Application | | | |
|---|---|---|---|---|
| .1937(d) | Is the Application complete | Yes ☑ | No ☐ | N/A ☐ |
| .1937(d) | Is there a Site plan/Plat with application | Yes ☐ | No ☐ | N/A ☑ |
| .1937(d) | Is the Facility shown? | Yes ☐ | No ☐ | N/A ☑ |
| .1937(d) | Are appurtenances shown | Yes ☐ | No ☐ | N/A ☑ |
| | **Site Evaluation Information** | | | |
| .1939 (a)(1) | Topography and Landscape Position Recorded? | Yes ☐ | No ☐ | N/A ☐ |
| .1940 (a-g) | Slope % Recorded? | Yes ☐ | No ☐ | N/A ☐ |
| .1939 (a)(2) | Texture Class Recorded? Used original Soil Report | Yes ☐ | No ☐ | N/A ☐ |
| .1939 (a)(2) | Structure type Recorded? | Yes ☐ | No ☐ | N/A ☐ |
| .1939 (a)(2) | Consistence Recorded? | Yes ☐ | No ☐ | N/A ☐ |
| .1939 (a)(2) | Mineralogy Recorded? | Yes ☐ | No ☐ | N/A ☐ |
| .1939 (a)(3) | Soil Wetness Condition Recorded? | Yes ☐ | No ☐ | N/A ☐ |
| .1939 (a)(4) | Soil Depth to Rock or Parent Material Recorded When Encountered | Yes ☐ | No ☐ | N/A ☐ |
| .1939 (a)(5) | Depth to Restrictive Horizons Recorded When Encountered? | Yes ☐ | No ☐ | N/A ☐ |
| .1939 (a)(6) | Sufficient Available Space Recorded? | Yes ☐ | No ☐ | N/A ☐ |
| .1937(m) | Are the Profile Locations Shown? | | | |
| .1939(a) | Are the S/PS Profiles in system & in repair area? | Yes ☐ | No ☐ | N/A ☐ |
| & .1945(b) | Number of auger borings made: 4 | | | |
| | Were sufficient auger borings made? | Yes ☐ | No ☐ | N/A ☐ |
| .1939(d), .1955, .1956, .1957 | LTAR | Yes ☐ | No ☐ | N/A ☐ |
| | **Improvement Permit/Construction Authorization** | | | |
| .1937(g) 130A-336(a) | Proposed System Type stated-Initial | Yes ☑ | No ☐ | N/A ☐ |
| .1945(b) | Proposed System Type stated-Repair | Yes ☑ | No ☐ | N/A ☐ |
| 130A-336 (a)(3) | System location identifiable by setbacks - Initial | Yes ☑ | No ☐ | N/A ☐ |
| .1937(g) .1945(b) | System components shown – Initial | Yes ☑ | No ☐ | N/A ☐ |
| .1945(b) | Repair area shown | Yes ☑ | No ☐ | N/A ☐ |
| .1937 (f)(g) | Does System design match facility, flow & WWcharacteristics? | Yes ☑ | No ☐ | N/A ☐ |
| .1937 (f)(g) | Is System design consistent with soil/site conditions? | Yes ☑ | No ☐ | N/A ☐ |
| .1937 (f)(g) | Is the System located in the approved area? | Yes ☑ | No ☐ | N/A ☐ |
| 130A-336(a) | Is the Design flow (gpd) indicated? | Yes ☑ | No ☐ | N/A ☐ |

| | | | | |
|---|---|---|---|---|
| 130A-336(a) | Number of Bedrooms, employees, seats, etc. indicated? | Yes ☑ | No ☐ | N/A ☐ |
| .1937(g) | Trench depth indicated? | Yes ☑ | No ☐ | N/A ☐ |
| .1937(g) | Trench width indicated? | Yes ☑ | No ☐ | N/A ☐ |
| .1937(g) | Trench length indicated? | Yes ☑ | No ☐ | N/A ☐ |
| 130A-336(a)(1) | Proposed/existing well shown? | Yes ☐ | No ☐ | N/A ☑ |
| 130A-336(a)(1) | Property line lengths shown? | Yes ☑ | No ☐ | N/A ☑ Existing |
| 130A-336(a) | Facility/appurtenance setbacks shown from fixed points? | Yes ☐ | No ☐ | N/A ☑ |
| | **Operation Permit** | | | |
| .1937(i) | System type as described in table V(a) of rule .1961 | Yes ☑ | No ☐ | N/A ☐ |
| .1937(i) | Conditions for system performance, operation, maintenance, monitoring and reporting. | Yes ☑ | No ☐ | N/A ☐ |

**II. WASPS Review:**

| | | | |
|---|---|---|---|
| Construction authorization issued | Yes ☐ | No ☐ | N/A ☐ |
| Installation approval issued | Yes ☐ | No ☐ | N/A ☐ |
| Operation permit issued | Yes ☐ | No ☐ | N/A ☐ |
| Other related documentation | Yes ☐ | No ☐ | N/A ☐ |

# Items requiring correction/modification: _____

Comments:

_____

_____

_____

_____

_____

IA issued date: _____

OP issued date: _____

Review performed by: JAM Date performed: 8/10/15

MECKLENBURG COUNTY
HEALTH DEPARTMENT

# APPLICATION FOR A RESIDENTIAL SITE IMPROVEMENT PERMIT/ CONSTRUCTION AUTHORIZATION FOR AN ON-SITE WASTEWATER SYSTEM, NEW WELL INSTALLATION, OR REPAIR OF EXISTING WELL

1. SEPTIC / TYPE APPLICATION: ○ N/A ○ NEW SYSTEM ○ ALTERATION ● REPAIR ○ MODIFIED PLOT PLAN

2. WELL / TYPE APPLICATION: ● N/A ○ NEW WELL ○ MAJOR REPAIR ○ ABANDONMENT

3. JOB LOCATION INFORMATION:
TAX PARCEL NUMBER: 197-221-47
STREET ADDRESS: 8528 Rolling Fields Rd.
CITY: Charlotte
STATE: NC ZIP: 28227
SUBDIVISION NAME: Plantation Falls
LOT #: 32 LOT SIZE (acres): .72
TOWNSHIP:
○ MECKLENBURG ○ CORNELIUS ○ HUNTERSVILLE
○ DAVIDSON ● CHARLOTTE ○ PINEVILLE
○ MATTHEWS ○ MINT HILL

4. BUILDING INFORMATION:
BUILDING TYPE:
○ SINGLE MOBILE HOME ○ MODULAR HOME
○ DOUBLE WIDE ○ MULTIPLE FAMILY
● HOUSE ○ OTHER _____
HEATED SQUARE FOOTAGE: _____
NUMBER OF BEDROOMS: 5
NUMBER OF OCCUPANTS: _____
FOUNDATION TYPE:
○ CONCRETE SLAB ○ BASEMENT WITH PLUMBING
● CRAWL SPACE ○ BASEMENT WITH NO PLUMBING

5. IF PLANNING TO EXPAND OR ALTER THE EXISTING SEPTIC SYSTEM PLEASE COMPLETE THE FOLLOWING SECTION: ☑ N/A

NUMBER OF BEDROOMS TO BE ADDED: _____ NUMBER OF ADDITIONAL OCCUPANTS IN THE RESIDENCE: _____

6. WATER SUPPLY: ● MUNICIPAL ○ PRIVATE WELL ○ PUBLIC WELL ○ SHARED WELL ○ OTHER _____

7. PROPOSED USE OF WELL: ● N/A ○ IRRIGATION ○ POTABLE (DRINKING WATER) ○ OTHER _____

8. PLEASE INDICATE AND RANK DESIRED SEPTIC SYSTEM TYPE(S) IN ORDER OF PREFERENCE *(1-MOST DESIRED 5-LEAST DESIRED)*:

☐ N/A ☐ ANY TYPE ☐ CONVENTIONAL ☑ ACCEPTED ☐ INNOVATIVE ☐ ALTERNATIVE ☐ OTHER _____

8A. RANK: ____ ____ ____ ____ ____

9. DO ANY OF THE FOLLOWING APPLY TO THE PROPERTY IN QUESTION? IF "YES" PLEASE ATTACH SUPPORTING DOCUMENTATION.

| | | | |
|---|---|---|---|
| BURIED CABLES, LANDFILLS, STUMPHOLES | ○ YES ● NO | GRADING/SOIL REMOVAL PERFORMED | ○ YES ● NO |
| EXISTING WASTEWATER (SEPTIC) SYSTEMS | ● YES ○ NO | JURISDICTIONAL WETLANDS | ○ YES ● NO |
| WELLS, SPRINGS, OR WATER LINES | ● YES ○ NO | APPROVAL REQUIRED BY ANY OTHER PUBLIC AGENCY | ○ YES ● NO |
| EASEMENTS OR RIGHT-OF-WAYS | ○ YES ● NO | WASTEWATER OTHER THAN DOMESTIC SEWAGE | ○ YES ● NO |
| CHEMICAL/PETROLEUM STORAGE TANKS | ○ YES ● NO | KNOWN UNDERGROUND CONTAMINATION | ○ YES ● NO |
| WASTE STORAGE | ○ YES ● NO | GROUNDWATER USE RESTRICTIONS/VARIANCES | ○ YES ● NO |

10. WHAT DATE WAS THE PROPERTY ORIGINALLY DEEDED AND RECORDED? 2007 ☐ UNKNOWN

11. WHAT IS THE ANTICIPATED CLOSING DATE FOR THIS PROPERTY? _____ ☑ N/A

12. PROPERTY OWNER:
NAME: James Bryan Turner
ADDRESS: 8528 Rolling Fields Rd.
CITY: Charlotte
STATE: NC ZIP: 28227
WORK PHONE: _____
MOBILE PHONE: 704-400-1465
FAX: _____
E-MAIL: _____

13. OWNER'S LEGAL REPRESENTATIVE, IF APPLICABLE:
NAME: _____
ADDRESS: _____
CITY: _____
STATE: _____ ZIP: _____
WORK PHONE: _____
MOBILE PHONE: _____
FAX: _____
E-MAIL: _____



MECKLENBURG COUNTY – GROUNDWATER & WASTEWATER SERVICES
700 N. TRYON ST. SUITE 211 CHARLOTTE, NC 28202, OFFICE: 704-336-5103, FAX: 704-336-6894

Revised on: 12/15/10

**14. SEPTIC SYSTEM PERMIT APPLICATION:**

If the information in this application is falsified, changed, or the site is altered, then the Improvement Permit and Authorization to Construct shall become invalid. I have read this application and certify that the information provided herein is true, complete and correct. Authorized county and state officials are granted right of entry to conduct necessary inspections to determine compliance with applicable laws and rules. I understand that I am solely responsible for the proper identification and labeling of all property lines and corners and making the site accessible so that a complete site evaluation can be performed. *The permit is valid for either sixty (60) months or is non-expiring depending upon the documentation submitted: complete site plan =* 60 months, complete plat = non-expiring.

BI (Initial here for septic system applications)

**15. WELL PERMIT APPLICATION:**

If the information in this application is falsified, changed, or the site is altered, then the Well Permit shall become invalid. I have read this application and certify that the information provided herein is true, complete and correct. Authorized county and state officials are granted right of entry to conduct necessary inspections to determine compliance with applicable laws and rules. I understand that I am solely responsible for the proper identification and labeling of all property lines and corners and making the site accessible so that a complete site evaluation can be performed. The permit is valid for a period of twelve (12) months from the date of issuance.

_____ *(Initial here for well applications)*

**16. APPLICATION SIGNATURE SECTION:**

**ONLY COMPLETE APPLICATIONS WILL BE PROCESSED**. A proper signature is required in order to process your application. Please review the application carefully and sign in the space provided below. A PROPOSED PLOT PLAN is required to be submitted with each application.

_____ _____

Property Owner's or Owner's Legal Representative Signature Date

---

*OFFICE USE ONLY*

○ SURVEY PLAT TO SCALE SUBMITTED ○ SCALED SITE PLAN SUBMITTED ○ UN-SCALED SITE PLAN SUBMITTED

SEPTIC APPLICATION FEE RECEIVED: $ _____ DATE FEE RECEIVED: _____

WELL APPLICATION FEE RECEIVED: $ _____ DATE FEE RECEIVED: _____

APPLICATION PROCESSED BY: _____

GWS FILE NUMBER ASSIGNED: _____

APPLICATION ID NUMBER ASSIGNED: _____

COMMENTS:



MECKLENBURG COUNTY – GROUNDWATER & WASTEWATER SERVICES
700 N. TRYON ST. SUITE 211 CHARLOTTE, NC 28202, OFFICE: 704-336-5103, FAX: 704-336-6894

Revised on: 12/15/10

Mecklenburg County Groundwater & Wastewater Services
700 N. Tryon St., Suite 211 Charlotte, NC 28202
Phone: (704) 336-5103 Fax: (704) 336-6894

NC DHHS
Division of Environmental Health
On-Site Wastewater Section

# IMPROVEMENT PERMIT/CONSTRUCTION AUTHORIZATION
## for an ON-SITE WASTEWATER TREATMENT & DISPOSAL SYSTEM

File #: 7167B Permit #: _____ Tax Parcel #: 197-221-47

Property Owner: James Bryan Turner

Job Location Address: 8528 Rolling Fields Rd.

City: Charlotte State: NC Zip Code: 28227

**Improvement Permit Issuance Date:** 7/30/2015 **Construction Authorization Issuance Date** 7/30/2015

Permission is hereby given to ☐ install ☐ alter ☑ repair an on-site wastewater treatment & and disposal system, with subsurface soil absorption and effluent discharge, as specified herein at the described location. This permit is granted based upon the application information submitted to our office. This permit expires 5 years from the date it was issued. The system shall meet all of the construction requirements of 15A NCAC 18A. 1900 which are in effect on the date of granting this approval. An **Operation Permit** must be obtained from the Mecklenburg County Health Department before any system can be covered up or placed into service. The issuance of this permit does not in any way guarantee that the system anticipated to be constructed will operate properly, or relieve any person now of hereafter owning, controlling or using such system from any liability resulting from the failure of the system to operate properly.

***NOTICE: This system shall not be installed while soils are in a wet condition.**

Permitted Design Flow: 600 GPD

Site LTAR: 0.275 GPD/ft² (For new installations only.)

Liquid Capacity of Septic Tank: Existing gallons

Liquid Capacity of Dosing Tank: N/A gallons

Drainfield Design ☐ N/A

Trench Depth: 36 inches

Trench Width: 3 feet

Line Spacing: 9 feet (O.C.)

Total line length: 120 feet

# of Lines: 2 @ _____ feet (1)@50 (1)@70

Depth of Media: 12 inches (Type) 25% Reduction

Distribution Device: D-BOX

Bed Design *(For Repair Installations ONLY.)* ☑ N/A

Bed Depth: _____ inches

Bed Width: _____ feet

Total line length: _____ feet

# of Lines: _____ @ _____ feet

Depth of Media: _____ inches (Type) _____

Distribution Device: _____

Water Supply Source

☑ Municipal ☐ Private Well ☐ Community Well

☐ Other _____


Minimum System Setbacks

Distance from Building Foundation: 10 feet

Distance from Property Line: 10 feet

Distance from Water Supply Source: 10 feet

SKETCH OF SYSTEM LAYOUT
(Proposed Layout)

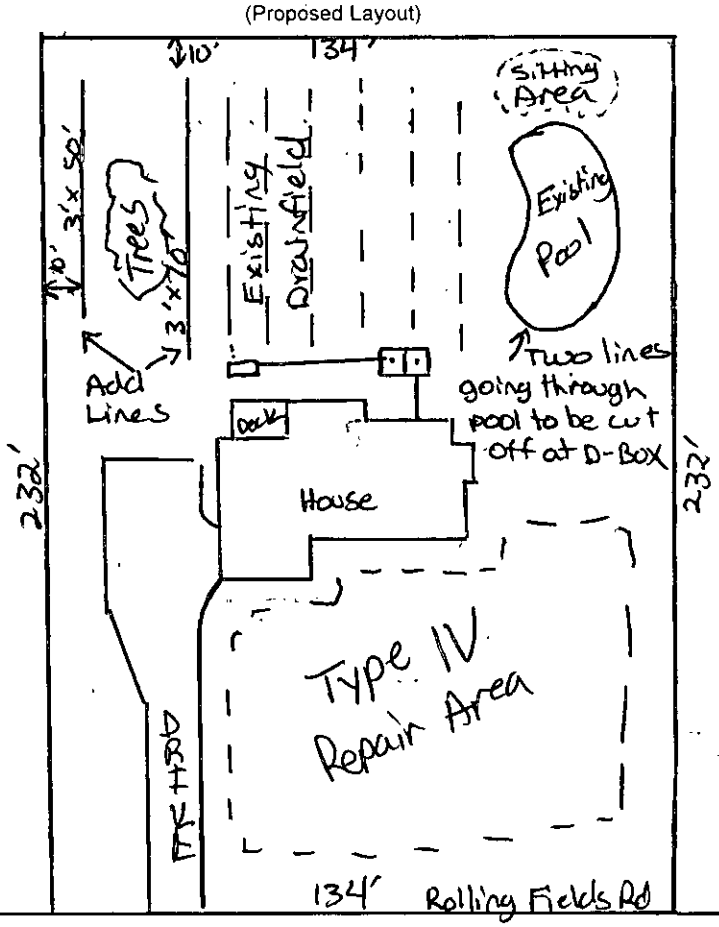


Comments: System Classification & Type: IIIg

Authorized Agent: Jeremy Michael Signature: Jeremy Michael REHS

Owner Signature: _____ Date: _____

Mecklenburg County Groundwater & Wastewater Services
700 N. Tryon St., Suite 211 Charlotte, NC 28202
Phone: (704) 336-5103 Fax: (704) 336-6894

NC DHHS
Division of Environmental Health
On-Site Wastewater Section

# OPERATION PERMIT for an ON-SITE WASTEWATER TREATMENT & DISPOSAL SYSTEM

File #: ~~7736~~ 7167B Permit #: _____ Tax Parcel #: 197-221-47

Property Owner: James Bryan Turner

Job Location Address: 8528 Rolling Fields Rd

City: Charlotte State: NC Zip Code: 28227

**Operation Permit Issuance Date:** 8/5/15 Contractor Name: RCS

Permitted Design Flow: 600 GPD Liquid Capacity of Dosing Tank: NA gallons

Liquid Capacity of Septic Tank: Existing gallons Manufacture _____ Effluent Pump Model: NA

Drainfield Installation ☐ N/A

Trench Depth: 36' inches

Trench Width: 3 feet

Line Spacing: 9 feet (O.C.)

Total line length: 120 feet

# of Lines: 2 @ 60' feet

Depth of Media: 12" inches (Type) IIIg

Depth of Cover: 12"+ inches

Distribution Device: D-Box

Bed Installation *(For Repair Installations ONLY.)* ☒ N/A

Bed Depth: _____ inches

Bed Width: _____ feet

Total line length: _____ feet

# of Lines: _____ @ _____ feet

Depth of Media: _____ inches (Type) _____

Depth of Cover: _____ inches

Distribution Device: _____

Water Supply Source

☒ Municipal ☐ Private Well ☐ Community Well

☐ Other _____

System Installation Setbacks

Distance from Building Foundation: 10'+ feet

Distance from Property Line: 10'+ feet

Distance from Water Supply Source: 10'+ feet


Inspection Dates

Tank(s) Inspected: Existing

Excavation Inspected: 8/5/14

Pump & Controls Inspected: NA

SKETCH OF SYSTEM INSTALLATION (As-Built Drawing)

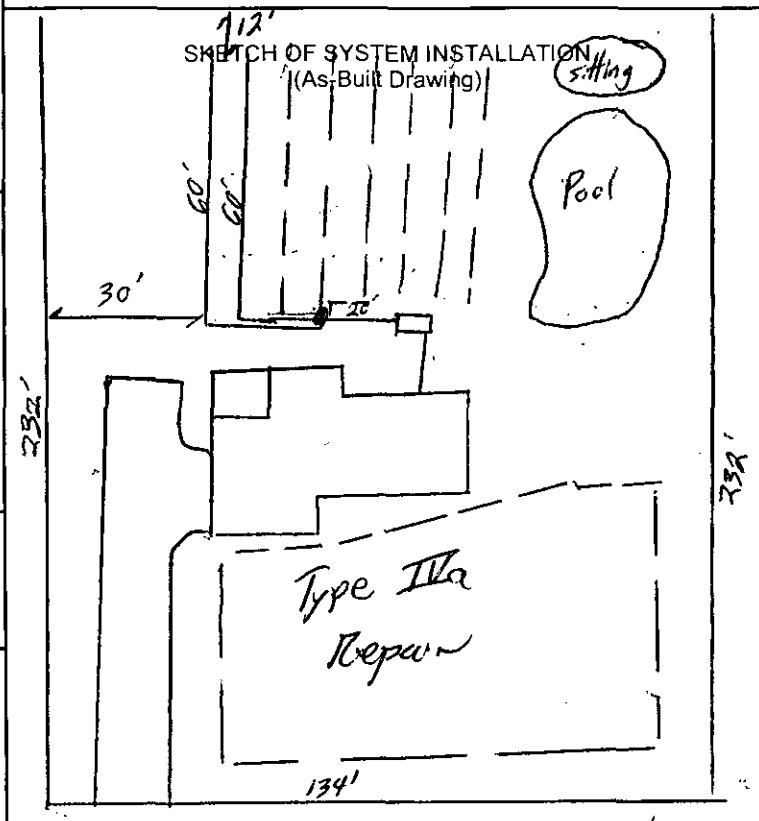


*The undersigned has inspected the Septic Tank System described above, and certifies it has been* ☐ *installed* ☒ *altered* ☑ *repaired* ☑ *as detailed in the plot above* ☐ *in accordance with the permit issued and meets the provisions of 15A NCAC 18A. 1900, "Laws and Rules for Sewage Treatment and Disposal Systems" in effect on the date of issuance of the permit. The issuance of this Operation Permit does not in any way guarantee that the system will operate properly or relieve any person now or hereafter owning, controlling, or using such system from any liability resulting from the failure of the system to operate properly. This document is issued subject to those restrictions and conditions shown on the permit(s) and the provisions of 15A NCAC 18A. 1900 in addition to those listed below under "Comments." This document shall be null and void if any information contained in the application is untrue or if any additions are made to the property which would increase the requirements for said system.*

**Notice: Disturbance of the designated repair area may result in the Suspension or Revocation of this permit.**

Comments: System Classification & Type: Arc 36 / G / NA / NA

DENR Authorized Agent: Bradley W. Ballman Signature: _____

Mecklenburg County Groundwater & Wastewater Services
700 N. Tryon St., Suite 211 Charlotte, NC 28202
Phone: (704) 336-5103 Fax: (704) 336-6894

NC DENR
Division of Environmental Health
On-Site Wastewater Section

**OPERATION PERMIT for an**
**ON-SITE WASTEWATER TREATMENT & DISPOSAL SYSTEM**

File #: 71673 Permit #: _____ Tax Parcel #: 197-221-47

Property Owner: James B. Turner

Job Location Address: 8528 Rolling Fields Rd

City: Charlotte State: NC Zip Code: 28227

**OPERATION PERMIT CONDITIONS:**

I. Performance: System shall perform in accordance with 15A NCAC 18A .1961.

II. Monitoring: System shall be monitored as required by 15A NCAC 18A .1961.

III. Maintenance: Ground absorption sewage treatment and disposal systems shall be checked, and the contents of the septic tank removed, periodically from all compartments, to ensure proper operation of the system. The contents shall be pumped whenever the solids level is found to be more than 1/3 of the liquid depth in any compartment.

IV. Operation: System shall be operated in accordance with 15A NCAC 18A .1961.

System Classification: IIIg

*Operation Permits for Type V and VI systems expire five (5) years from the date of issuance (in accordance with Table V(a)). The system owner must contact GWS six (6) months prior to expiration for permit renewal.

Subsurface system operator required: Yes ☐ No ☑

☐ This type of system requires the system owner to maintain a contract with a certified operator to perform system inspection, maintenance, and reporting as required in 15A NCAC 18A .1961. and Table V(a). The system owner is responsible for all fees associated with these services.

☒ System does not require inspection by GWS on a routine frequency.

☐ System requires inspection by GWS once every five (5) years. The system owner is responsible for all fees associated with the inspection.

☐ System requires inspection by GWS once every three (3) years. The system owner is responsible for all fees associated with the inspection.

☐ System requires inspection by GWS once every twelve (12) months. The system owner is responsible for all fees associated with the inspection.

☐ System requires inspection by GWS once every six (6) months. The system owner is responsible for all fees associated with the inspection.

V. Other:

_____

_____

_____

_____

DENR Authorized Agent: Bradley W. Hellman Date: 5/5/15

Signature: _____

Mecklenburg County Groundwater & Wastewater Services
700 N. Tryon St., Suite 211 Charlotte, NC 28202
Phone: (704) 336-5103 Fax: (704) 336-6894

NC DENR
Division of Environmental Health
On-Site Wastewater Section

# OPERATION PERMIT for an ON-SITE WASTEWATER TREATMENT & DISPOSAL SYSTEM

File #: 7167B Permit #: 30002370 Tax Parcel #: 197-221-47

Property Owner: THE HOME GROUP LOT 32 PLANTATION Falls

Job Location Address: 8528 ROLLING FIELDS RD.

City: Charlotte State: NC Zip Code: 28227

**Operation Permit Issuance Date:** 10-16-07 Contractor Name: RCS

Permitted Design Flow: 600 GPD

Liquid Capacity of Septic Tank: 1500 gallons JES 9-26-07

Liquid Capacity of Dosing Tank: N/A gallons

Effluent Pump Model: N/A

Drainfield Installation ☐ N/A

Trench Depth: 30-36 inches

Trench Width: 3 feet

Line Spacing: 9 feet (O.C.)

Total line length: 545 feet

# of Lines: 7 @ 70 feet 1 @ 55'

Depth of Media: 12 inches (Type) E2 Flow

Depth of Cover: 24 inches

Distribution Device: D-Box

Inspection Dates

Tank(s) Inspected: 10-16-07

Excavation Inspected: 10-16-07

Pump & Controls Inspected: N/A

Bed Installation *(For Repair Installations ONLY.)* ☒ N/A

Bed Depth: _____ inches

Bed Width: _____ feet

Total line length: _____ feet


# of Lines: _____ @ _____ feet

Depth of Media: _____ inches (Type) _____

Depth of Cover: _____ inches

Distribution Device: _____

SKETCH OF SYSTEM INSTALLATION
(As-Built Drawing)

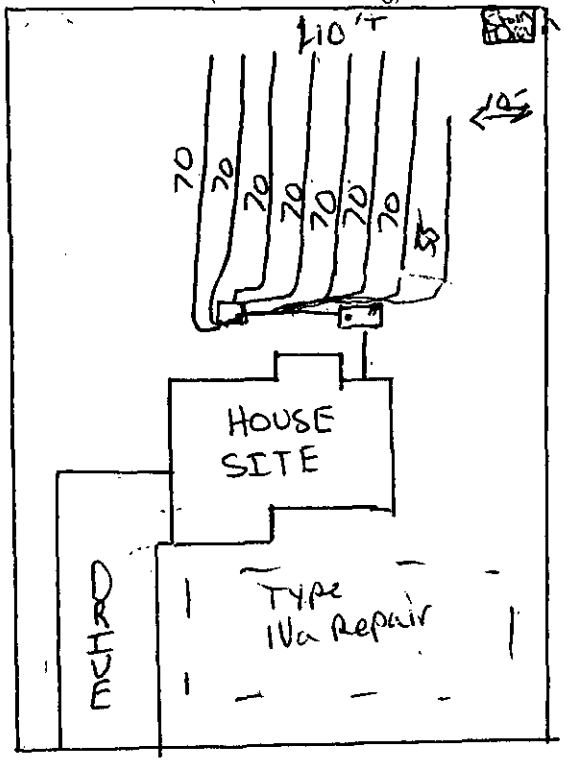


Water Supply Source

☒ Municipal ☐ Private Well ☐ Community Well

☐ Other _____

System Installation Setbacks

Distance from Building Foundation: 10 feet

Distance from Property Line: 10 feet

Distance from Water Supply Source: 10 feet

The undersigned has inspected the Septic Tank System described above, and certifies it has been ☒ installed ☐ altered ☐ repaired ☒ as detailed in the plot above ☐ in accordance with the permit issued and meets the provisions of 15A NCAC 18A. 1900, "Laws and Rules for Sewage Treatment and Disposal Systems" in effect on the date of issuance of the permit. The issuance of this Operation Permit does not in any way guarantee that the system will operate properly or relieve any person now or hereafter owning, controlling, or using such system from any liability resulting from the failure of the system to operate properly. This document is issued subject to those restrictions and conditions shown on the permit(s) and the provisions of 15A NCAC 18A. 1900 in addition to those listed below under "Comments." This document shall be null and void if any information contained in the application is untrue or if any additions are made to the property which would increase the requirements for said system.

**Notice: Disturbance of the designated repair area may result in the Suspension or Revocation of this permit.**

Comments: System Classification & Type: III g

DENR Authorized Agent: Jeremy Michael Signature: Jeremy Michael

Mecklenburg County Groundwater & Wastewater Services
700 N. Tryon St., Suite 211 Charlotte, NC 28202
Phone: (704) 336-5103 Fax: (704) 336-6894

NC DENR
Division of Environmental Health
On-Site Wastewater Section

**OPERATION PERMIT for an**
**ON-SITE WASTEWATER TREATMENT & DISPOSAL SYSTEM**

File #: 7167 B Permit #: 30002370 Tax Parcel #: 197-221-47

Property Owner: THE HOME GROUP LOT 32 PLANTATION FALLS

Job Location Address: 8528 ROLLING FIELDS RD.

City: CHARLOTTE State: NC Zip Code: 28227

**OPERATION PERMIT CONDITIONS:**

I. Performance: System shall perform in accordance with 15A NCAC 18A .1961.

II. Monitoring: System shall be monitored as required by 15A NCAC 18A .1961.

III. Maintenance: Ground absorption sewage treatment and disposal systems shall be checked, and the contents of the septic tank removed, periodically from all compartments, to ensure proper operation of the system. The contents shall be pumped whenever the solids level is found to be more than 1/3 of the liquid depth in any compartment.

IV. Operation: System shall be operated in accordance with 15A NCAC 18A .1961.

System Classification: IIIg

*Operation Permits for Type V and VI systems expire five (5) years from the date of issuance (in accordance with Table V(a)). The system owner must contact GWS six (6) months prior to expiration for permit renewal.

Subsurface system operator required: Yes ☐ No ☒

☐ This type of system requires the system owner to maintain a contract with a certified operator to perform system inspection, maintenance, and reporting as required in 15A NCAC 18A .1961. and Table V(a). The system owner is responsible for all fees associated with these services.

☒ System does not require inspection by GWS on a routine frequency.

☐ System requires inspection by GWS once every five (5) years. The system owner is responsible for all fees associated with the inspection.

☐ System requires inspection by GWS once every three (3) years. The system owner is responsible for all fees associated with the inspection.

☐ System requires inspection by GWS once every twelve (12) months. The system owner is responsible for all fees associated with the inspection.

☐ System requires inspection by GWS once every six (6) months. The system owner is responsible for all fees associated with the inspection.

V. Other:

DENR Authorized Agent: Jeremy Michael Date: 10-16-07

Signature: Jeremy Michael




8528 ROLLING FIELDS RD

19722147

1/11/2008

duponbj

Groundwater and Wastewater Services File Imaging Project
May 2007
*Barcode Font = IDAutomationHC39M*

Groundwater & Wastewater Services
Septic Project File & Data Review Worksheet

GWS File #: 7167B WASPS App #: 2370

Primary ES assigned to project:

Secondary ES assigned to project:

Project Type: New System ☑ Alteration ☐ Repair ☐ Modified Plot Plan ☐

I. File Review:

| Rule or Law | | | | |
|---|---|---|---|---|
| | **Permit Application** | | | |
| .1937(d) | Is the Application complete | Yes ☑ | No ☐ | N/A ☐ |
| .1937(d) | Is there a Site plan/Plat with application | Yes ☑ | No ☐ | N/A ☐ |
| .1937(d) | Is the Facility shown? | Yes ☑ | No ☐ | N/A ☐ |
| .1937(d) | Are appurtenances shown | Yes ☑ | No ☐ | N/A ☐ |
| | **Site Evaluation Information** | | | |
| .1939 (a)(1) | Topography and Landscape Position Recorded? | Yes ☑ | No ☐ | N/A ☐ |
| .1940 (a-g) | Slope % Recorded? | Yes ☑ | No ☐ | N/A ☐ |
| .1939 (a)(2) | Texture Class Recorded? | Yes ☑ | No ☐ | N/A ☐ |
| 1939 (a)(2) | Structure type Recorded? | Yes ☑ | No ☐ | N/A ☐ |
| 1939 (a)(2) | Consistence Recorded? | Yes ☑ | No ☐ | N/A ☐ |
| .1939 (a)(2) | Mineralogy Recorded? | Yes ☑ | No ☐ | N/A ☐ |
| .1939 (a)(3) | Soil Wetness Condition Recorded? | Yes ☐ | No ☐ | N/A ☑ |
| .1939 (a)(4) | Soil Depth to Rock or Parent Material Recorded When Encountered | Yes ☐ | No ☐ | N/A ☑ |
| .1939 (a)(5) | Depth to Restrictive Horizons Recorded When Encountered? | Yes ☐ | No ☐ | N/A ☑ |
| .1939 (a)(6) | Sufficient Available Space Recorded? | Yes ☑ | No ☐ | N/A ☐ |
| .1937(m) | Are the Profile Locations Shown? | | | |
| .1939(a) | Are the S/PS Profiles in system & in repair area? | Yes ☑ | No ☐ | N/A ☐ |
| & 1945(b) | Number of auger borings made: 4 Were sufficient auger borings made? | Yes ☑ | No ☐ | N/A ☐ |
| .1939(d), .1955, .1956, .1957 | LTAR .275 | Yes ☐ | No ☐ | N/A ☐ |
| | **Improvement Permit/Construction Authorization** | | | |
| .1937(g) 130A-336(a) | Proposed System Type stated-Initial | Yes ☑ | No ☐ | N/A ☐ |
| .1945(b) | Proposed System Type stated-Repair | Yes ☑ | No ☐ | N/A ☐ |
| 130A-336 (a)(3) | System location identifiable by setbacks - Initial | Yes ☑ | No ☐ | N/A ☐ |
| .1937(g) .1945(b) | System components shown – Initial | Yes ☑ | No ☐ | N/A ☐ |
| .1945(b) | Repair area shown | Yes ☑ | No ☐ | N/A ☐ |
| .1937 (f)(g) | Does System design match facility, flow & WWcharacteristics? | Yes ☑ | No ☐ | N/A ☐ |
| 1937 (f)(g) | Is System design consistent with soil/site conditions? | Yes ☑ | No ☐ | N/A ☐ |
| .1937 (f)(g) | Is the System located in the approved area? | Yes ☑ | No ☐ | N/A ☐ |
| 130A-336(a) | Is the Design flow (gpd) indicated? | Yes ☐ | No ☐ | N/A ☐ |

| | | | | |
|---|---|---|---|---|
| 130A-336(a) | Number of Bedrooms, employees, seats, etc. indicated? | Yes ☐ | No ☐ | N/A ☐ |
| .1937(g) | Trench depth indicated? | Yes ☑ | No ☐ | N/A ☐ |
| .1937(g) | Trench width indicated? | Yes ☑ | No ☐ | N/A ☐ |
| .1937(g) | Trench length indicated? | Yes ☑ | No ☐ | N/A ☐ |
| 130A-336(a)(1) | Proposed/existing well shown? | Yes ☑ | No ☐ | N/A ☐ |
| 130A-336(a)(1) | Property line lengths shown? | Yes ☐ | No ☐ | N/A ☑ |
| 130A-336(a) | Facility/appurtenance setbacks shown from fixed points? | Yes ☑ | No ☐ | N/A ☐ |
| | **Operation Permit** | | | |
| .1937(i) | System type as described in table V(a) of rule .1961 | Yes ☑ | No ☐ | N/A ☐ |
| .1937(i) | Conditions for system performance, operation, maintenance, monitoring and reporting. | Yes ☑ | No ☐ | N/A ☐ |

II. WASPS Review:

| | | | |
|---|---|---|---|
| Construction authorization issued | Yes ☐ | No ☐ | N/A ☐ |
| Installation approval issued | Yes ☐ | No ☐ | N/A ☐ |
| Operation permit issued | Yes ☐ | No ☐ | N/A ☐ |
| Other related documentation | Yes ☐ | No ☐ | N/A ☐ |

*# Items requiring correction/modification:* _____

Comments:

_____

_____

_____

_____

_____

IA issued date: 10.2.07

OP issued date: 10/16/07

Review performed by: ICR

Date performed: 6-6-07

Mecklenburg County Groundwater & Wastewater Services
700 N. Tryon St., Suite 211 Charlotte, NC 28202
Phone: (704) 336-5103 Fax: (704) 336-6894

NC DENR
Division of Environmental Health
On-Site Wastewater Section

# INSTALLATION APPROVAL for an ON-SITE WASTEWATER TREATMENT & DISPOSAL SYSTEM

File #: 7162B Permit #: 30002370 Tax Parcel #: 197-221-47

Property Owner: Home Group Lot 32 Plantation Falls

Job Location Address: 9528 Rolling Fields Rd. Lot # 32

City: Mint Hill State: NC Zip Code: _____

**Installation Approval Issuance Date:** 10-2-07

Permission is hereby given to ☒ install ☐ alter ☐ repair an on-site wastewater treatment & and disposal system, with subsurface soil absorption and effluent discharge, as specified herein at the described location. This approval is granted based upon the application information submitted to our office. All work shall be completed on or before 11-2-07, after which date this approval shall be null and void. The system shall meet all of the construction requirements of 15A NCAC 18A. 1900 which are in effect on the date of granting this approval. An **Operation Permit** must be obtained from the Mecklenburg County Health Department before any system can be covered up or placed into service. The issuance of this permit does not in any way guarantee that the system anticipated to be constructed will operate properly, or relieve any person now of hereafter owning, controlling or using such system from any liability resulting from the failure of the system to operate properly.

***NOTICE: This system shall not be installed while soils are in a wet condition.**

Permitted Design Flow: 600 GPD

Site LTAR: .275 GPD/ft² (For new installations only.)

Liquid Capacity of Septic Tank: 1500 gallons

Liquid Capacity of Dosing Tank: 1500 gallons

Drainfield Design ☐ N/A

Trench Depth: 30-36 inches

Trench Width: 3 feet

Line Spacing: 9 feet (O.C.)

Total line length: 545 feet

# of Lines: 7 @ 78 feet

Depth of Media: 12 inches (Type) 25% Red

Distribution Device: Pressure Manifold

Bed Design *(For Repair Installations ONLY.)* ☒ N/A

Bed Depth: _____ inches

Bed Width: _____ feet

Total line length: _____ feet

# of Lines: _____ @ _____ feet

Depth of Media: _____ inches (Type) _____

Distribution Device: _____

Water Supply Source

☒ Municipal ☐ Private Well ☐ Community Well

☐ Other _____


Minimum System Setbacks

Distance from Building Foundation: 5 feet

Distance from Property Line: 10 feet


Distance from Water Supply Source: 10 feet

SKETCH OF SYSTEM LAYOUT
(Proposed Layout)

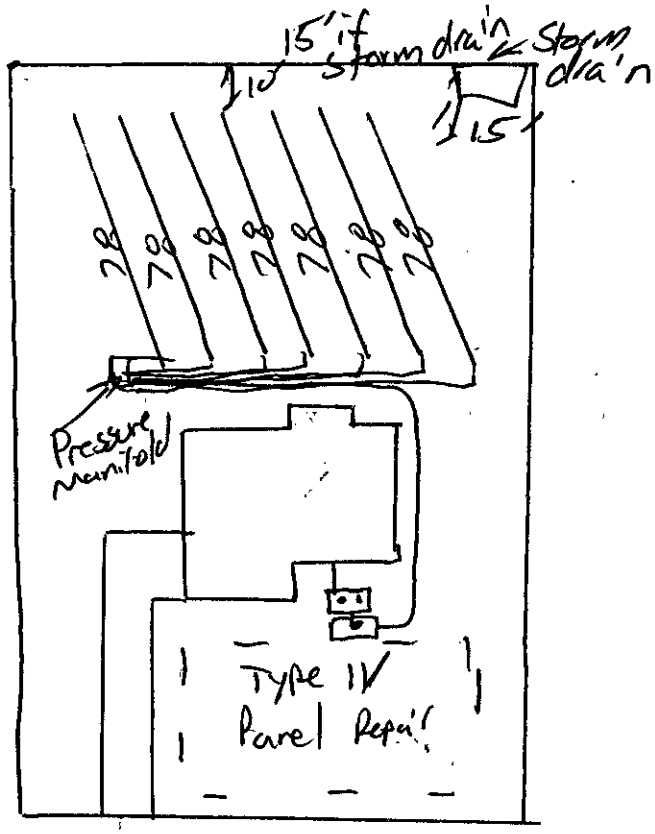


Comments: System Classification & Type: Type III bg

DENR Authorized Agent: Jeremy Mitchell Signature: Jeremy Mitchell

 

Mecklenburg County Groundwater & Wastewater Services
700 N. Tryon St, Suite 211 Charlotte, NC 28202
Phone: (704) 336-5103 Fax: (704) 336-6894

NC DENR
Division of Environmental Health
On-Site Wastewater Section

AD 234390

# IMPROVEMENT PERMIT for a RESIDENTIAL ON-SITE WASTEWATER TREATMENT & DISPOSAL SYSTEM

Permit #: 30002370 GWS File #: 7167B Tax Parcel #: 197-221-47

- This IMPROVEMENT PERMIT is subject to revocation if site plans or the intended use change. There is to be NO *grading, filling, or disturbance of the soil in the area of the septic tank system or repair area.*
- CONSTRUCTION AUTHORIZATION must be obtained prior to receiving a Building Permit. The Construction Authorization is NOT transferable. Do not clear, grade, fill or disturb soil prior to obtaining a Construction Authorization.
- Domestic-type wastewater only. No industrial process wastewater may be discharged into the system.

**I. This Improvement Permit Shall:** Expire in Five (5) Years **Expiration Date (If Applicable):** 6/6/2012

Type of Installation: Residential - New System Lot Number: 32

Structure Type: HOUSE Size ($ft^2$): 4579 # Bedrooms: 5 # Occupants: 4

Building Foundation: Crawl Space Water Supply: Municipal

**II. Initial System Type:** Innovative **System Classification:** IIIg

Initial System Specifications:

Design Flow (gpd): 600 LTAR (gpd/$ft^2$): 0.275 Septic Tank Size (gal): 1500 Pump Tank Size (gal)*: N/A

Trench Width (ft): 3 Trench Spacing (ft): 9 Absorption Area ($ft^2$): 1638 Total Trench Length (ft): 545

Maximum Trench Depth (in): 30 Depth of Media (in): 12 Distribution Device: Drop Tees

**III. Repair System Type:** PPBPS (pressurized) **System Classification:** IVa

Repair System Specifications:

Design Flow (gpd): 600 LTAR (gpd/$ft^2$): 0.275 Septic Tank Size (gal): 1500 Pump Tank Size (gal): 1000

Trench Width (ft): 3 Trench Spacing (ft): 9 Absorption Area ($ft^2$): 1091 Total Trench Length (ft): 364

Maximum Trench Depth (in): 30 Depth of Media (in): N/A Distribution Device: Pressure Manifold

**IV. Permit Conditions/Comments:**

*(Please See the Following Page for Permit Conditions.)*

The undersigned, an authorized agent of the MECKLENBURG COUNTY HEALTH DEPARTMENT, certifies that the Department is issuing an IMPROVEMENT PERMIT for the above referenced property. This permit is being issued in accordance with the *Laws and Rules For Sewage Treatment, and Disposal Systems* and is subject to the following provisions:

- No work shall be conducted on the septic system until an INSTALLATION APPROVAL is granted by the Department.
- The septic system installer shall be a registered septic contractor with Mecklenburg County Health Department.
- The permitted system shall be installed in accordance with the included PLOT PLAN.
- This IMPROVEMENT PERMIT is transferable.

DENR Authorized Agent: David Cornelius

Signature: [signature] RS

Date Issued: 6/6/2007

Owner/Legal Agent: KENNETH TURULL
Print Name

Signature: [signature] 6.18.07

Mecklenburg County Groundwater & Wastewater Services
700 N. Tryon St, Suite 211 Charlotte, NC 28202
Phone: (704) 336-5103 Fax: (704) 336-6894

NC DENR
Division of Environmental Health
On-Site Wastewater Section

## IMPROVEMENT PERMIT for a RESIDENTIAL ON-SITE WASTEWATER TREATMENT & DISPOSAL SYSTEM

Permit #: 30002370 GWS File #: 7167B

**IV. Permit Conditions/Comments:**

- All components of the septic system must be installed in accordance with the required setbacks listed on *the corresponding plot plan.*

*The undersigned, an authorized agent of the* MECKLENBURG COUNTY HEALTH DEPARTMENT, *certifies that* the Department is issuing an IMPROVEMENT PERMIT for the above referenced property. This permit is being issued in accordance with the *Laws and Rules For Sewage Treatment and Disposal Systems* and is subject to the following provisions:

- No work shall be conducted on the septic system until an INSTALLATION APPROVAL is granted by the Department.
- The septic system installer shall be a registered septic contractor with Mecklenburg County Health Department.
- The permitted system shall be installed in accordance with the included PLOT PLAN.
- This IMPROVEMENT PERMIT is transferable.

DENR Authorized Agent: David Cornellus

Signature: [signature] RS

Date Issued: 6/6/2007

Owner/Legal Agent: KENNETH TURNER 6-18-07
*Print Name*

Signature: [signature]

Mecklenburg County Groundwater & Wastewater Services
700 N. Tryon St, Suite 211 Charlotte, NC 28202
Phone: (704) 336-5103 Fax: (704) 336-6894

NC DENR
Division of Environmental Health
On-Site Wastewater Section

# IMPROVEMENT PERMIT for a RESIDENTIAL ON-SITE WASTEWATER TREATMENT & DISPOSAL SYSTEM

Permit #: 30002370 GWS File #: 7167B Tax Parcel #: 197-221-47

- This IMPROVEMENT PERMIT is subject to revocation if site plans or the intended use change. There is to be **NO** grading, filling, or disturbance of the soil in the area of the septic tank system or repair area.
- CONSTRUCTION AUTHORIZATION must be obtained prior to receiving a Building Permit. The Construction Authorization is **NOT** transferable. Do not clear, grade, fill or disturb soil prior to obtaining a Construction Authorization.
- Domestic-type wastewater only. No industrial process wastewater may be discharged into the system.

**I. This Improvement Permit Shall:** Expire in Five (5) Years **Expiration Date (If Applicable):** 6/6/2012

Type of Installation: Residential - New System Lot Number: 32

Structure Type: HOUSE Size ($ft^2$): 4579 # Bedrooms: 5 # Occupants: 4

Building Foundation: Crawl Space Water Supply: Municipal

**II. Initial System Type:** Innovative **System Classification:** IIIg

Initial System Specifications:

Design Flow (gpd): 600 LTAR (gpd/$ft^2$): 0.275 Septic Tank Size (gal): 1500 Pump Tank Size (gal): N/A

Trench Width (ft): 3 Trench Spacing (ft): 9 Absorption Area ($ft^2$): 1636 Total Trench Length (ft): 545

Maximum Trench Depth (in): 30 Depth of Media (in): 12 Distribution Device: Drop Tees

**III. Repair System Type:** PPBPS (pressurized) **System Classification:** IVa

Repair System Specifications:

Design Flow (gpd): 600 LTAR (gpd/$ft^2$): 0.275 Septic Tank Size (gal): 1500 Pump Tank Size (gal): 1000

Trench Width (ft): 3 Trench Spacing (ft): 9 Absorption Area ($ft^2$): 1091 Total Trench Length (ft): 364

Maximum Trench Depth (in): 30 Depth of Media (in): N/A Distribution Device: Pressure Manifold

**IV. Permit Conditions/Comments:**

*(Please See the Following Page for Permit Conditions.)*

The undersigned, an authorized agent of the MECKLENBURG COUNTY HEALTH DEPARTMENT, certifies that the Department is issuing an IMPROVEMENT PERMIT for the above referenced property. This permit is being issued in accordance with the *Laws and Rules For Sewage Treatment, and Disposal Systems* and is subject to the following provisions:

- No work shall be conducted on the septic system until an INSTALLATION APPROVAL is granted by the Department.
- The septic system installer shall be a registered septic contractor with Mecklenburg County Health Department.
- The permitted system shall be installed in accordance with the included PLOT PLAN.
- This IMPROVEMENT PERMIT is transferable.

DENR Authorized Agent: David Cornelius Owner/Legal Agent: _____
Print Name

Signature: _____ Signature: _____

Date Issued: 6/6/2007

Mecklenburg County Groundwater & Wastewater Services
700 N. Tryon St, Suite 211 Charlotte, NC 28202
Phone: (704) 336-5103 Fax: (704) 336-6894

NC DENR
Division of Environmental Health
On-Site Wastewater Section

## IMPROVEMENT PERMIT for a RESIDENTIAL ON-SITE WASTEWATER TREATMENT & DISPOSAL SYSTEM

Permit #: 30002370 GWS File #: 7167B

**IV. Permit Conditions/Comments:**

- All components of the septic system must be installed in accordance with the required setbacks listed on the corresponding plot plan.

The undersigned, an authorized agent of the MECKLENBURG COUNTY HEALTH DEPARTMENT, certifies that the Department is issuing an IMPROVEMENT PERMIT for the above referenced property. This permit is being issued in accordance with the *Laws and Rules For Sewage Treatment and Disposal Systems* and is subject to the following provisions:

- No work shall be conducted on the septic system until an INSTALLATION APPROVAL is granted by the Department.
- The septic system installer shall be a registered septic contractor with Mecklenburg County Health Department.
- The permitted system shall be installed in accordance with the included PLOT PLAN.
- This IMPROVEMENT PERMIT is transferable.

DENR Authorized Agent: David Cornelius

Signature: _____

Date Issued: 6/6/2007

Owner/Legal Agent: _____
Print Name

Signature: _____

# PROPOSED PLOT PLAN

1" = 40'


HEALTH DEPARTMENT
ENVIRONMENTAL HEALTH DIVISION
700 NORTH TRYON ST., SUITE 211
CHARLOTTE, NC 28202
PHONE (704) 336-5103

PLANTATION FALLS LOT #32

FILE: 7167B

TC: 197-221-47

Draw in and name all roads adjoining the property. Draw in and accurately dimension the lot concerned. Accurately indicate property boundaries proposed and/or existing structures and driveways, underground utilities, and wells and springs within 100 feet of the proposed building or drainfield.

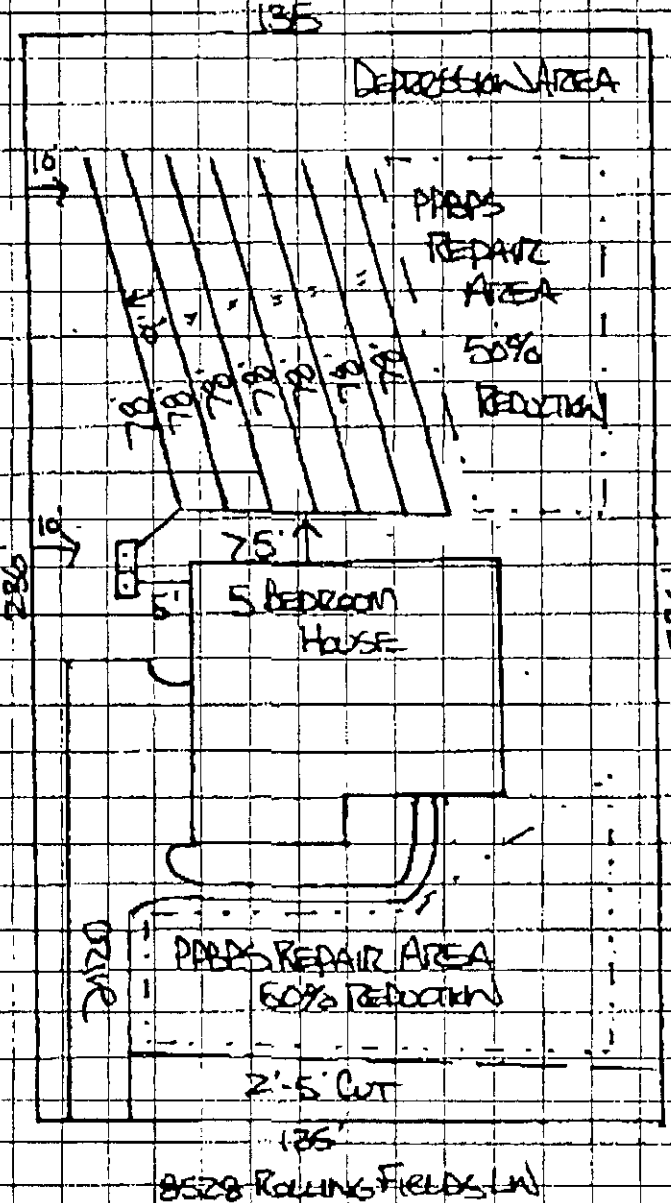


- SEPTIC DESIGN FOR A 5 BEDROOM HOUSE
- 600 GAL/DAY MAX
- LTAR = 0.275 GAL/SQ FT
- INITIAL SYSTEM, INNOVATIVE 25% REDUCTION, THEN 50%
- INSTALL 7 LINES @ 78' EA. PLACE LINES LEVEL ON CONTOUR & ON 9' CENTERS
- 1500 GAL SEPTIC TANK DROP T DISTRIBUTION

SETBACKS:
>10' FROM PROPERTY LINE
>5' FROM HOUSE
>15' FROM 2' CUT

PPBPS REPAIR AREA

OWNER/AGENT SIGNATURE

DATE 6.18.07

APPROVAL DATE

RS

# PROPOSED PLOT PLAN

1"=40'


HEALTH DEPARTMENT
ENVIRONMENTAL HEALTH DIVISION
700 NORTH TRYON ST., SUITE 211
CHARLOTTE, NC 28202
PHONE (704) 336-5103

PLANTATION FALLS LOT #32

FILE: 7167B

TC: 197-221-47

Draw in and name all roads adjoining the property. Draw in and accurately dimension the lot concerned. Accurately indicate property boundaries proposed and/or existing structures and driveways, underground utilities, and wells and springs within 100 feet of the proposed building or drainfield.

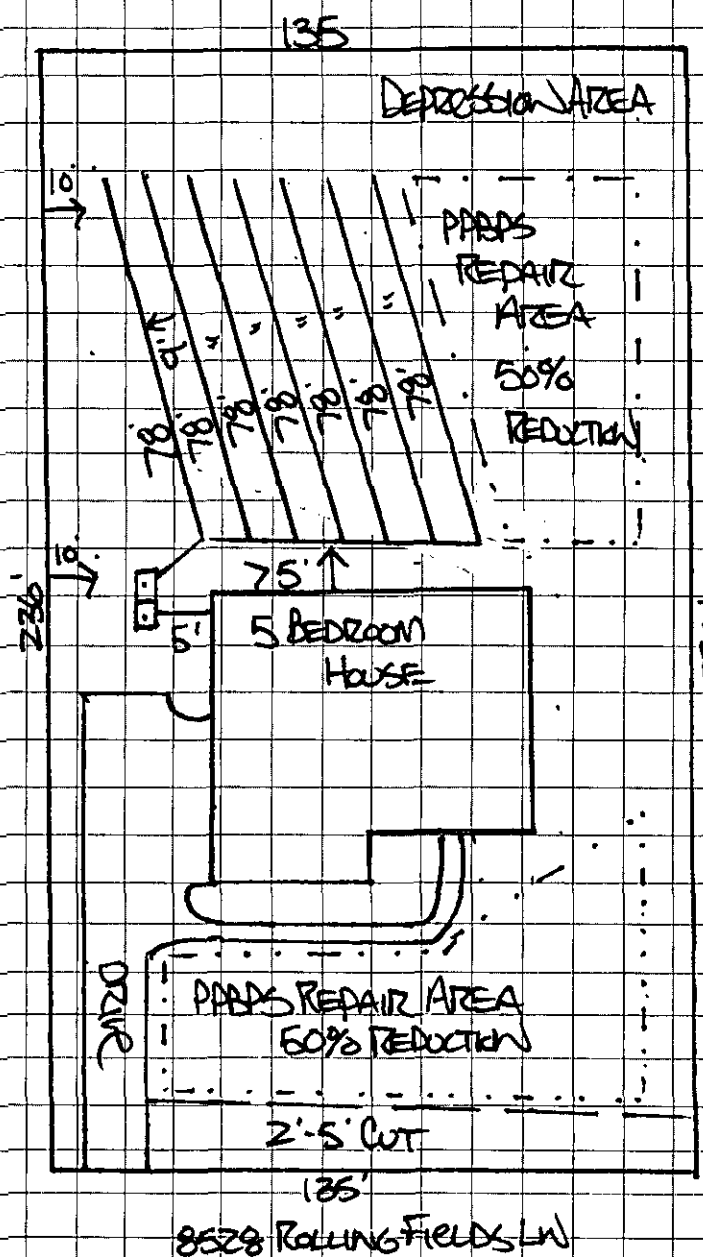


- SEPTIC DESIGN FOR A 5 BEDROOM HOUSE
- 600 GAL/DAY MAX
- LTAR = 0.275 GAL/DAY/FT²
- INITIAL SYSTEM, INNOVATIVE 25% REDUCTION, TYPE II TRENCHING
- INSTALL 7 LINES @ 78' EA. PLACE LINES LEVEL, ON CONTOUR & ON 9' CENTERS.
- 1500 GAL SEPTIC TANK
- DROP T DISTRIBUTION

SETBACKS:
>10' FROM PROPERTY LINE
>5' FROM HOUSE
>15' FROM 2' CUT

PPBPS REPAIR AREA

OWNER/AGENT SIGNATURE

DATE

APPROVAL DATE

White - Health Department's Copy  Canary - E.H.S. Copy  Pink - Owner's Copy

*MECKLENBURG COUNTY*
*LAND USE AND ENVIRONMENTAL SERVICES*
***Payment Receipt***

**Receipt Information**

| | | | |
|---|---|---|---|
| **Date:** | 06/08/07 | **Amount:** | 150.00 |
| **Receipt #:** | 51173 | **Tendered:** | 0.00 |
| **Check / Auth #:** | CHARGE | **Returned:** | 0.00 |
| **Received By:** | AIDOOJK | | |

**Account Information**

**Account #:** X31095
**Contractor:** HOME GROUP IN THE
**Attn:**
**Address:** 3070 SENNA DR
**Address:** STE A
**City/State/Zip:** MATTHEWS, NC 28105

| Item | Description | Permit# | Quantity | Unit Price | Total Price |
|---|---|---|---|---|---|
| 0734 | Auth for Waste Wtr Sys Constr<br>8528 ROLLING FIELDS RD | | 1 | 150.00 | 150.00 |

**Outstanding Balances**

| Month-To-Date | Prior Month | 30 Days | 60 Days | 90 Days | Balance |
|---|---|---|---|---|---|
| 350.00 | 3,963.16 | 2,241.80 | | | |

*MECKLENBURG COUNTY*
*LAND USE AND ENVIRONMENTAL SERVICES*
*Payment Receipt*

**Receipt Information**

| | | | |
|---|---|---|---|
| **Date:** | 06/08/07 | **Amount:** | 150.00 |
| **Receipt #:** | 51174 | **Tendered:** | 0.00 |
| **Check / Auth #:** | CHARGE | **Returned:** | 0.00 |
| **Received By:** | AIDOOJK | | |

**Account Information**

**Account #:** X31095
**Contractor:** HOME GROUP IN THE
**Attn:**
**Address:** 3070 SENNA DR
**Address:** STE A
**City/State/Zip:** MATTHEWS, NC 28105

| Item | Description | Permit# | Quantity | Unit Price | Total Price |
|---|---|---|---|---|---|
| 0703 | Installation/Final Approval<br>8528 ROLLING FIELDS RD | | 1 | 150.00 | 150.00 |

**Outstanding Balances**

| Month-To-Date | Prior Month | 30 Days | 60 Days | 90 Days | Balance |
|---|---|---|---|---|---|
| 500.00 | 3,963.16 | 2,241.80 | | | |

Department of Environment, Health, and Natural Resources
Division of Environmental Health
On-site Wastewater Section

Sheet: 1 of 2
Property ID: 197-221-47
Lot #: 32
File #: 7167B
AppID: 2370

# SOIL/SITE EVALUATION for ON-SITE WASTEWATER SYSTEM

Owner: The Home Group, Inc. — Applicant:
Address: 3070-A Senna Drive, Matthews, N. C. 28705 — Date Evaluated: 6/5/07
Proposed Facility: Residence — Design Flow (.1949): 600gpd — Property Size: .72a
Location of Site: 8528 Rolling Fields Road — Property Recorded:
Water Supply: [ x ] Public [ ] Individual [ ] Well [ ] Spring [ ] Other
Evaluation Method: [ x ] Auger Boring [ ] Pit [ ] Cut
Type of Wastewater: [ x ] Sewage [ ] Industrial Process [ ] Mixed

| PROFILE # | 1940 Landscape Position/ Slope% | Horizon Depth (IN.) | SOIL MORPHOLOGY 1941 — 1941 Structure/ Texture | 1941 Consistence Mineralogy | PROFILE FACTORS — 1942 Soil Wetness/ Color | 1943 Soil Depth (IN.) | 1956 Sapro Class | 1944 Restr. Horiz. | Profile Class & LTAR |
|---|---|---|---|---|---|---|---|---|---|
| 1 | LS, 6 | 0-3 | GR/CL | FR/SEXP/SS/SP | >46" TO SOIL WETNESS | 46 | N/A | NONE | PS, IV |
| | | 3-27 | ABK/SBK/C | FI/SEXP/S/P | | | | | .275GPD/FT$^2$ |
| | | 27-46 | SBK/ABK/SICL | FR/SEXP/SS/SP | | | | | |
| 2 | " | 0-4 | GR/CL | " | " | " | " | " | " |
| | | 4-31 | ABK/SBK/C | FI/SEXP/S/P | | | | | |
| | | 31-46 | SBK/ABK/SICL | FR/SEXP/SS/SP | | | | | |
| 3 | " | 0-5 | GR/CL | " | " | " | " | " | " |
| | | 5-27 | ABK/SBK/C | FI/SEXP/S/P | | | | | |
| | | 27-46 | SBK/ABK/SICL | FR/SEXP/SS/SP | | | | | |
| 4 | " | 0-3 | GR/CL | " | " | " | " | " | " |
| | | 3-28 | ABK/SBK/C | FI/SEXP/S/P | | | | | |
| | | 28-46 | SBK/ABK/SICL | FR/SEXP/SS/SP | | | | | |
| | | | | | SITE LTAR .275GPD/FT$^2$ | | | | |

| Description | Initial System | Repair System |
|---|---|---|
| Available Space (.1945) | PS | PS |
| System Type(s) | IIIg | Iva |
| Site LTAR | 0.275 | 0.275 |

Other Factors (.1946):
Soil Evaluation By: W. R. Marlin, LSS, 6/5/2007
Others Present:
Site Classification (.1948): Provisionally Suitable
Site Evaluation By: David Cornelius, RS
Others Present:


David Cornelius, RS

**COMMENTS:**
100% repair

| Landscape Position | Group | Texture | .1955 LTAR | Structure |
|---|---|---|---|---|
| R-Ridge | I | S-Sand | 1.2 - 0.8 | SG-Single Grain |
| SS-Shoulder Slope | | LS-Loamy Sand | | M-Massive |
| LS-Linear Slope | | | | CR-Crumb |
| FS-Foot Slope | II | SL-Sandy Loam | 0.8 - 0.6 | GR-Granular |
| NS-Nose Slope | | L-Loam | | SBK-Subangular Blocky |
| HS-Head Slope | | | | ABK-Angular Blocky |
| CC-Concave Slope | III | SI-Silt | 0.6 - 0.3 | PL-Platy |
| CV-Convex Slope | | SICL-Silty Clay Loam | | PR-Prismatic |
| T-Terrace | | | | |
| FP-Flood Plain | | CL-Clay Loam | | |
| | | SCL-Sandy Clay Loam | | |
| | IV | SC-Sandy Clay | 0.4 - 0.1 | |
| | | SIC-Silty Clay | | |
| | | C-Clay | | |

| Consistence Moist | Consistence Wet | Mineralogy |
|---|---|---|
| VFR-Very Friable | NS-Non-Sticky | SEXP-Slightly Expansive |
| FR-Friable | SS-Slightly Sticky | EXP-Expansive |
| FI-Firm | S-Sticky | |
| VFI-Very Firm | VS-Very Sticky | |
| EFI-Extremely Firm | NP-Non-Plastic | |
| | SP-Slightly Plastic | |
| | P-Plastic | |
| | VP-Very Plastic | |

**Sketch of Soil Evaluation Locations**

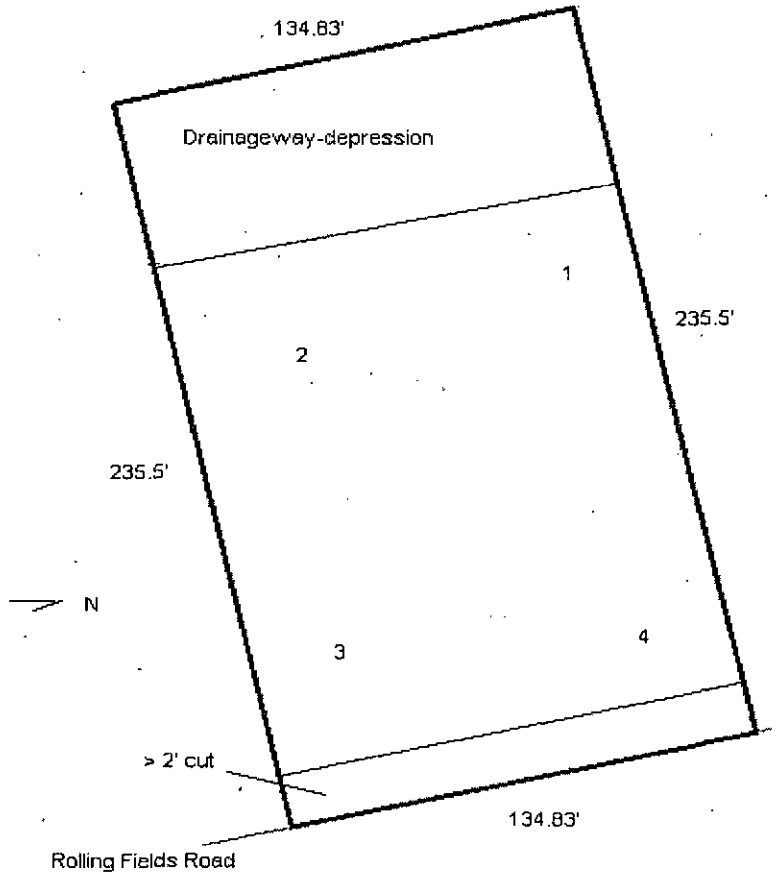

FILE NUMBER: 7167B

SEPTIC FEE: 200 cc
DATE: 6/5/07

Revised On: January 3, 2007

APPLICATION NUMBER: _____

MECKLENBURG COUNTY GROUNDWATER & WASTEWATER SERVICES
APPLICATION FOR A RESIDENTIAL SITE IMPROVEMENT PERMIT/ CONSTRUCTION AUTHORIZATION FOR AN ON-SITE WASTEWATER SYSTEM, NEW WELL INSTALLATION, OR REPAIR OF EXISTING WELL

WELL FEE: _____
DATE: _____

1. SEPTIC / TYPE APPLICATION: ☐ NONE ☒ NEW SYSTEM ☐ ALTERATION ☐ REPAIR ☐ MODIFIED PLOT PLAN

2. WELL / TYPE APPLICATION: ☒ NONE ☐ NEW WELL ☐ MAJOR REPAIR ☐ ABANDONMENT

3. JOB LOCATION INFORMATION:
TAX PARCEL NUMBER: 197-221-47
STREET ADDRESS: 8528 ROLLING FIELDS RD
CITY: MINT HILL
STATE: NC ZIP: 28227
SUBDIVISION NAME: PLANTATION FALLS ESTATES
LOT #: 32 LOT SIZE (acres): 0.72
TOWNSHIP:
☐ 0-MECKLENBURG ☐ 3-CORNELIUS ☐ 6-HUNTERSVILLE
☐ 1-CHARLOTTE ☐ 4-PINEVILLE ☒ 7-MINT HILL
☐ 2-DAVIDSON ☐ 5-MATTHEWS

4. BUILDING INFORMATION:
BUILDING TYPE:
☐ SINGLE MOBILE HOME ☐ MODULAR HOME
☐ DOUBLE WIDE ☐ MULTIPLE FAMILY
☒ HOUSE ☐ OTHER _____
HEATED SQUARE FOOTAGE: 4579
NUMBER OF BEDROOMS: 5
NUMBER OF OCCUPANTS: 4.
FOUNDATION TYPE:
☐ CONCRETE SLAB ☐ BASEMENT WITH PLUMBING
☒ CRAWL SPACE ☐ BASMENT WITH NO PLUMBING

5. IF PLANNING TO EXPAND OR ALTER THE EXISTING SYSTEM PLEASE COMPLETE THE FOLLOWING SECTION: ☒ N/A
NUMBER OF BEDROOMS TO BE ADDED: _____ NUMBER OF ADDITIONAL OCCUPANTS IN THE RESIDENCE: _____

6. WATER SUPPLY: ☒ MUNICIPAL ☐ PUBLIC WELL ☐ PRIVATE WELL ☐ SHARED WELL ☐ SPRING

7. PROPOSED USE OF WELL: ☒ N/A ☐ IRRIGATION ☐ POTABLE ☐ GEOTHERMAL ☐ OTHER

9. PLEASE INDICATE AND RANK DESIRED SEPTIC SYSTEM TYPE(S) IN ORDER OF PREFERENCE *(1-MOST DESIRED 5-LEAST DESIRED)*:

☐ ANY TYPE ☒ CONVENTIONAL ☒ ACCEPTED ☐ INNOVATIVE ☐ ALTERNATIVE ☐ OTHER _____
8A. RANK: 1 2 ____ ____ ____

9. DO ANY OF THE FOLLOWING APPLY TO THE PROPERTY IN QUESTION? IF "YES" PLEASE ATTACH SUPPORTING DOCUMENTATION.

| | | | |
|---|---|---|---|
| BURIED CABLES, LANDFILLS, STUMPHOLES | ☐ YES ☒ NO | GRADING/SOIL REMOVAL PERFORMED | ☐ YES ☒ NO |
| EXISTING WASTEWATER SYSTEMS | ☐ YES ☒ NO | JURISDICTIONAL WETLANDS | ☐ YES ☒ NO |
| WELLS, SPRINGS, OR WATER LINES | ☐ YES ☒ NO | APPROVAL REQUIRED BY ANY OTHER PUBLIC AGENCY | ☐ YES ☒ NO |
| EASEMENTS OR RIGHT-OF-WAYS | ☐ YES ☒ NO | WASTEWATER OTHER THAN DOMESTIC SEWAGE | ☐ YES ☒ NO |

10. PROPERTY OWNER:
NAME: THE HOMEGROUP INC
ADDRESS: 3070-A SENNA DR
CITY: MATTHEWS
STATE: NC ZIP: 28105
HOME PHONE: — WORK PHONE: 704 841 3074
MOBILE PHONE: — FAX: 704 841 2084

11. OWNER'S LEGAL REPRESENTATIVE, IF APPLICABLE:
NAME:
ADDRESS:
CITY:
STATE: ZIP:
HOME PHONE: WORK PHONE:
MOBILE PHONE: FAX:

12. WHAT DATE WAS THE PROPERTY ORIGINALLY DEEDED AND RECORDED? _____
13 WHAT IS THE ANTICIPATED CLOSING DATE FOR THIS PROPERTY? MAY 15, 2007

14. SEPTIC SYSTEM PERMIT APPLICATION SIGNATURE SECTION:
If the information in this application is falsified, changed, or the site is altered, then the Improvement Permit and Authorization to Construct shall become invalid. I have read this application and certify that the information provided herein is true, complete and correct. Authorized county and state officials are granted right of entry to conduct necessary inspections to determine compliance with applicable laws and rules. I understand that I am solely responsible for the proper identification and labeling of all property lines and corners and making the site accessible so that a complete site evaluation can be performed. The permit is valid for either 60 months or is non-expiring depending upon the documentation submitted: complete site plan = 60 months, complete plat = non-expiring.

Edwin Hoke 5/2/07
Property Owner's or Owner's Legal Representative Signature Date

15. WELL PERMIT APPLICATION SIGNATURE SECTION:
If the information in this application is falsified, changed, or the site is altered, then the Well Permit shall become invalid. I have read this application and certify that the information provided herein is true, complete and correct. Authorized county and state officials are granted right of entry to conduct necessary inspections to determine compliance with applicable laws and rules. I understand that I am solely responsible for the proper identification and labeling of all property lines and corners and making the site accessible so that a complete site evaluation can be performed. The permit is valid for a period of 12 months from the date of issuance.

_____
Property Owner's or Owner's Legal Representative Signature Date

☐ SURVEY PLAT TO SCALE SUBMITTED ☒ SCALED SITE PLAN SUBMITTED ☐ UN-SCALED SITE PLAN SUBMITTED

MECKLENBURG COUNTY-GROUNDWATER & WASTEWATER SERVICES
700 N. TRYON ST., SUITE 211, CHARLOTTE, NC 28202 PHONE: (704) 336-5103 FAX: (704) 336-6894


06/05/2007 12:52 TEL 7048412084 THE HOKE GROUP ☒002

# THE HOME GROUP

THE HOME GROUP, INC
Homes Uniquely Designed For Your Lifestyle

# PLANTATION FALLS ESTATES
# LOT 32 - FOWLER

0.72 ACRE
8528 ROLLING FIELDS RD
MINT HILL, NC 28227

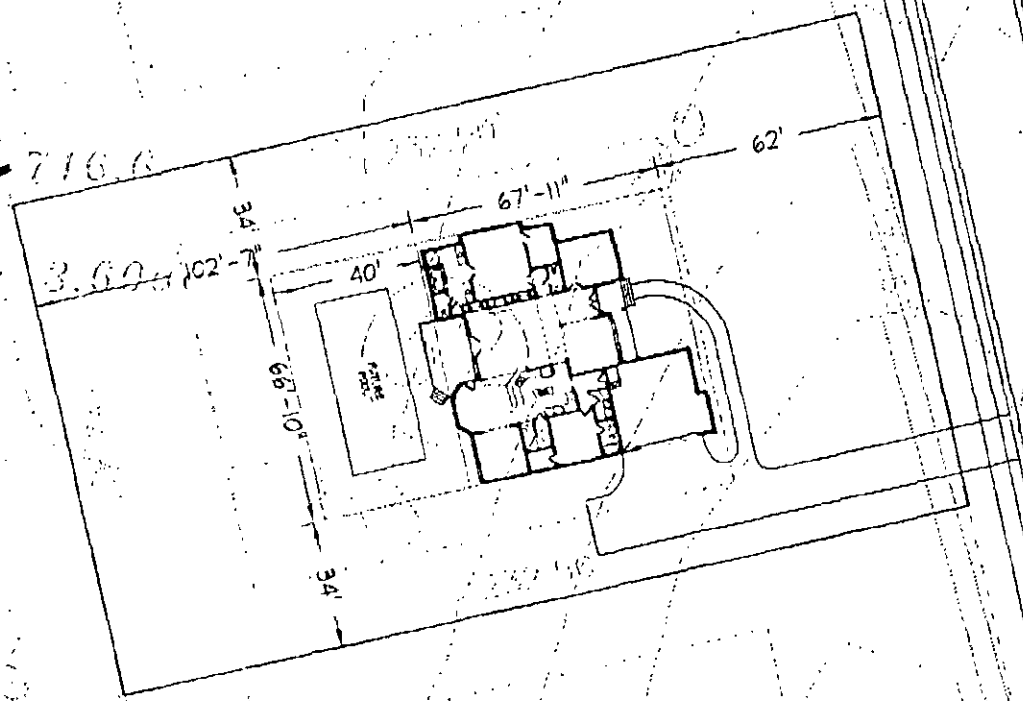


ROLLING FIELDS ROAD - 60' R/W

1" = 50'-0"

## SITE PLAN - LOT 32

PLAN DESIGN • BUILDING • REAL-ESTATE

3070 SENNA DRIVE, MATTHEWS, NC 28105 P-704.841.2074 F-704.841.2084

06/05/2007 12:52 TEL 7048412084 THE HOME GROUP 003

*MECKLENBURG COUNTY*
*LAND USE AND ENVIRONMENTAL SERVICES*
***Payment Receipt***

**Receipt Information**

| | | | |
|---|---|---|---|
| **Date:** | 06/05/07 | **Amount:** | 200.00 |
| **Receipt #:** | 51096 | **Tendered:** | 0.00 |
| **Check / Auth #:** | CHARGE | **Returned:** | 0.00 |
| **Received By:** | CRAIGGY | | |

**Account Information**

| | |
|---|---|
| **Account #:** | X31095 |
| **Contractor:** | HOME GROUP IN THE |
| **Attn:** | |
| **Address:** | 3070 SENNA DR |
| **Address:** | STE A |
| **City/State/Zip:** | MATTHEWS, NC 28105 |

| Item | Description | Permit# | Quantity | Unit Price | Total Price |
|---|---|---|---|---|---|
| 0701 | Improvment Permit App-Residen<br>8528 Rolling Fields Rd./file 7167B | | 1 | 200.00 | 200.00 |

**Outstanding Balances**

| Month-To-Date | Prior Month | 30 Days | 60 Days | 90 Days | Balance |
|---|---|---|---|---|---|
| 200.00 | 3,963.16 | 2,241.80 | | | |