MECKLENBURG COUNTY
HEALTH DEPARTMENT

18093
#11842

5 JAN '21 AM 9:57

APPLICATION FOR A RESIDENTIAL SITE IMPROVEMENT PERMIT/ CONSTRUCTION AUTHORIZATION FOR AN ON-SITE WASTEWATER SYSTEM, NEW WELL INSTALLATION, OR REPAIR OF EXISTING WELL

1. **SEPTIC / TYPE APPLICATION:** ○ N/A ○ NEW SYSTEM ○ ALTERATION ● REPAIR ○ MODIFIED PLOT PLAN

2. **WELL / TYPE APPLICATION:** ⊙ N/A ○ NEW WELL ○ MAJOR REPAIR ○ ABANDONMENT

3. **JOB LOCATION INFORMATION:**

TAX PARCEL NUMBER: 01526403
STREET ADDRESS: 8809 Mt. Holly-Huntersville Road
CITY: Huntersville
STATE: NC **ZIP:** 28078
SUBDIVISION NAME: N/A
LOT #: 8809 **LOT SIZE (acres):** 0.49
TOWNSHIP:

○ MECKLENBURG ○ CORNELIUS ⊙ HUNTERSVILLE
○ DAVIDSON ○ CHARLOTTE ○ PINEVILLE
○ MATTHEWS ○ MINT HILL

4. **BUILDING INFORMATION:**

BUILDING TYPE:

○ SINGLE MOBILE HOME ○ MODULAR HOME
○ DOUBLE WIDE ○ MULTIPLE FAMILY
⊙ HOUSE ○ OTHER _____

HEATED SQUARE FOOTAGE: 1360
NUMBER OF BEDROOMS: 3
NUMBER OF OCCUPANTS: 2
FOUNDATION TYPE:

○ CONCRETE SLAB ○ BASEMENT WITH PLUMBING
⊙ CRAWL SPACE ○ BASEMENT WITH NO PLUMBING

5. **IF PLANNING TO EXPAND OR ALTER THE EXISTING SEPTIC SYSTEM PLEASE COMPLETE THE FOLLOWING SECTION:** ☑ N/A

NUMBER OF BEDROOMS TO BE ADDED: _____ NUMBER OF ADDITIONAL OCCUPANTS IN THE RESIDENCE: _____

6. **WATER SUPPLY:** ○ MUNICIPAL ⊙ PRIVATE WELL ○ PUBLIC WELL ○ SHARED WELL ○ OTHER _____

7. **PROPOSED USE OF WELL:** ⊙ N/A ○ IRRIGATION ○ POTABLE (DRINKING WATER) ○ OTHER _____

8. **PLEASE INDICATE AND RANK DESIRED SEPTIC SYSTEM TYPE(S) IN ORDER OF PREFERENCE** *(1-MOST DESIRED 5-LEAST DESIRED)*:

☐ N/A ☐ ANY TYPE ☑ CONVENTIONAL ☑ ACCEPTED ☑ INNOVATIVE ☑ ALTERNATIVE ☐ OTHER _____

8A. **RANK:** 1 2 3 4 ____

9. **DO ANY OF THE FOLLOWING APPLY TO THE PROPERTY IN QUESTION? IF "YES" PLEASE ATTACH SUPPORTING DOCUMENTATION.**

BURIED CABLES, LANDFILLS, STUMPHOLES	⊙ YES ○ NO	GRADING/SOIL REMOVAL PERFORMED	○ YES ⊙ NO
EXISTING WASTEWATER (SEPTIC) SYSTEMS	⊙ YES ○ NO	JURISDICTIONAL WETLANDS	○ YES ⊙ NO
WELLS, SPRINGS, OR WATER LINES	⊙ YES ○ NO	APPROVAL REQUIRED BY ANY OTHER PUBLIC AGENCY	○ YES ⊙ NO
EASEMENTS OR RIGHT-OF-WAYS	○ YES ⊙ NO	WASTEWATER OTHER THAN DOMESTIC SEWAGE	○ YES ⊙ NO
CHEMICAL/PETROLEUM STORAGE TANKS	○ YES ⊙ NO	KNOWN UNDERGROUND CONTAMINATION	⊙ YES ○ NO
WASTE STORAGE	○ YES ⊙ NO	GROUNDWATER USE RESTRICTIONS/VARIANCES	○ YES ⊙ NO

10. **WHAT DATE WAS THE PROPERTY ORIGINALLY DEEDED AND RECORDED?** 10/27/2017 ☐ UNKNOWN

11. **WHAT IS THE ANTICIPATED CLOSING DATE FOR THIS PROPERTY?** _____ ☑ N/A

12. **PROPERTY OWNER:**

NAME: Julia Vermeersch
ADDRESS: 8809 Mt. Holly-Huntersville Road
CITY: Huntersville
STATE: NC ZIP: 28078
WORK PHONE: _____
MOBILE PHONE: 9145527400
FAX: _____
E-MAIL: juliavermeersch@aol.com

13. **OWNER'S LEGAL REPRESENTATIVE, IF APPLICABLE:**

Owner's Authorization form is required if legal representative is submitting application

NAME: _____
ADDRESS: _____
CITY: _____
STATE: _____ ZIP: _____
WORK PHONE: _____
MOBILE PHONE: _____
FAX: _____
E-MAIL: _____

MECKLENBURG COUNTY – GROUNDWATER & WASTEWATER SERVICES
3205 Freedom Dr. Suite 8000, Charlotte, NC 28208 OFFICE: (980) 314-1680, FAX: 704-336-6894

Revised on: 03/27/19

14. SEPTIC SYSTEM PERMIT APPLICATION:

If the information in this application is falsified, changed, or the site is altered, then the Improvement Permit and Authorization to Construct shall become invalid. I have read this application and certify that the information provided herein is true, complete and correct. Authorized county and state officials are granted right of entry to conduct necessary inspections to determine compliance with applicable laws and rules. I understand that I am solely responsible for the proper identification and labeling of all property lines and corners and making the site accessible so that a complete site evaluation can be performed. The permit is valid for either sixty (60) months or is non-expiring depending upon the documentation submitted: complete site plan = 60 months, complete plat = non-expiring.

JV
_____ (Initial here for septic system applications)

15. WELL PERMIT APPLICATION:

If the information in this application is falsified, changed, or the site is altered, then the Well Permit shall become invalid. I have read this application and certify that the information provided herein is true, complete and correct. Authorized county and state officials are granted right of entry to conduct necessary inspections to determine compliance with applicable laws and rules. I understand that I am solely responsible for the proper identification and labeling of all property lines and corners and making the site accessible so that a complete site evaluation can be performed. The permit is valid for a period of twelve (12) months from the date of issuance.

_____ (Initial here for well applications)

16. APPLICATION SIGNATURE SECTION:

ONLY COMPLETE APPLICATIONS WILL BE PROCESSED. A proper signature is required in order to process your application. Please review the application carefully and sign in the space provided below. A PROPOSED PLOT PLAN is required to be submitted with each application.

_____ 01/05/2021

Property Owner's or Owner's Legal Representative Signature — Date

---

OFFICE USE ONLY

○ SURVEY PLAT TO SCALE SUBMITTED ○ SCALED SITE PLAN SUBMITTED ○ UN-SCALED SITE PLAN SUBMITTED

SEPTIC APPLICATION FEE RECEIVED: $ _____ DATE FEE RECEIVED: _____

WELL APPLICATION FEE RECEIVED: $ _____ DATE FEE RECEIVED: _____

APPLICATION PROCESSED BY: _____

GWS FILE NUMBER ASSIGNED: _____

APPLICATION ID NUMBER ASSIGNED: _____

COMMENTS:

_____

_____

_____

_____

_____

_____

_____

_____

_____

_____

MECKLENBURG COUNTY – GROUNDWATER & WASTEWATER SERVICES
3205 Freedom Dr. Suite 8000, Charlotte, NC 28208 OFFICE: (980) 314-1680, FAX: 704-336-6894

Revised on: 03/27/19


File #: _____

PROPOSED PLOT PLAN

A drawing showing the locations of the following items is required: existing and proposed property lines with dimensions, easements or right-of-ways, proposed building pad(s) or existing building footprint(s), all appurtenances (garage, driveway, deck, pool, etc.), location of existing or proposed well(s), location of existing or proposed sewer lines and sewage disposal systems, surface water bodies, and any aboveground or underground storage tanks. Provide names for all roads that adjoin the property.

Street Address: _____ Tax Parcel #: _____

Subdivision Name: _____ Lot #: _____

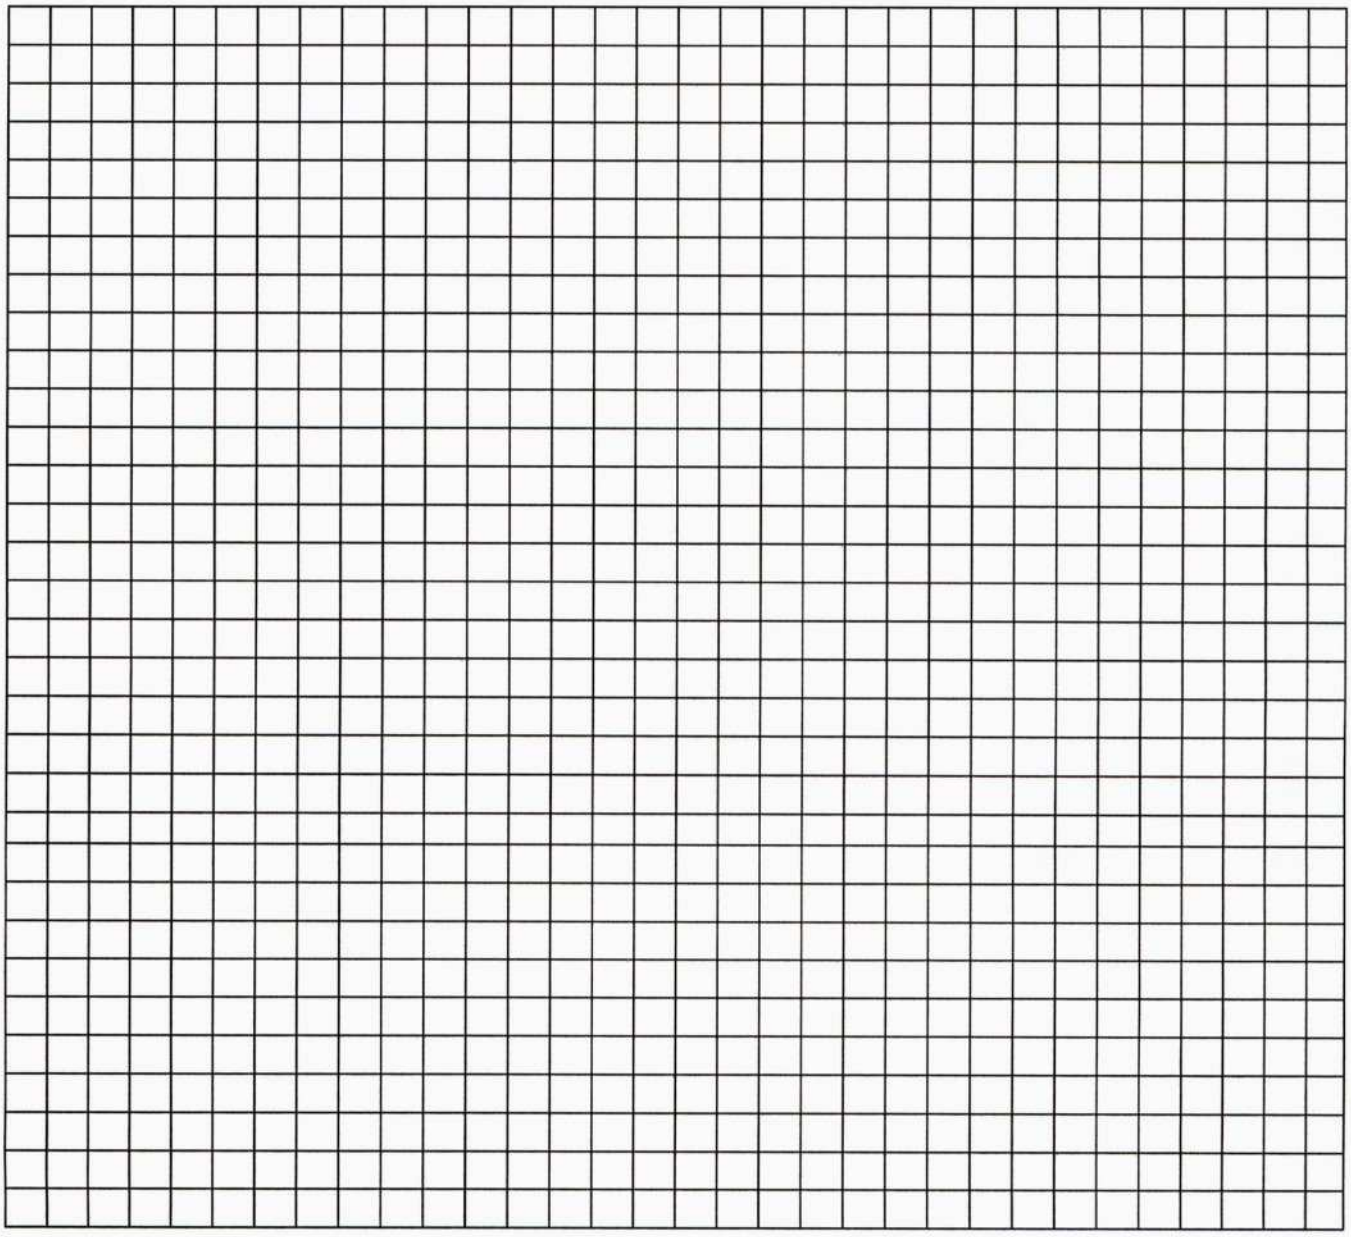

_____ _____

Property Owner's or Owner's Legal Representative Signature Date

MECKLENBURG COUNTY – GROUNDWATER & WASTEWATER SERVICES
3205 Freedom Dr. Suite 8000, Charlotte, NC 28208, OFFICE: (980) 314-1680, FAX: 704-336-6894

Revised on: 03/27/19

Mecklenburg County Groundwater & Wastewater Services
3205 Freedom Dr. Suite 8000 Charlotte, NC 28208
Phone: (980) 314-1680 Fax: (704) 336-6894

NC DHHS
Division of Environmental Health
On-Site Wastewater Section

IMPROVEMENT PERMIT/CONSTRUCTION AUTHORIZATION for REPAIRING an ON-SITE WASTEWATER TREATMENT & DISPOSAL SYSTEM

File #: 18093 Permit #: 11842 Tax Parcel #: 01526403

Property Owner: Julia Vermeersch

Job Location Address: 8809 Mt. Holly Huntersville Road

City: Huntersville State: NC Zip Code: 28078

Improvement Permit Issuance Date: _____ **Construction Authorization Issuance Date:** 1-7-2021

Permission is hereby given to **repair** an on-site wastewater treatment & and disposal system, with subsurface soil absorption and effluent discharge, as specified herein at the described location. This approval is granted based upon the application information submitted to our office. All work shall be completed on or before 1-8-21. The system shall meet all of the construction requirements of 15A NCAC 18A. 1900 which are in effect on the date of granting this approval. An **Operation Permit** must be obtained from the Mecklenburg County Health Department before any system can be covered up or placed into service. The issuance of this permit does not in any way guarantee that the system anticipated to be constructed will operate properly, or relieve any person now of hereafter owning, controlling or using such system from any liability resulting from the failure of the system to operate properly.

Permitted Design Flow: _____ GPD

Site LTAR: Na GPD/ft²

Liquid Capacity of Septic Tank: 1000 gallons

Liquid Capacity of Dosing Tank: Na gallons

Drainfield Design ☑ N/A

Trench Depth: _____ inches

Trench Width: _____ feet

Line Spacing: _____ feet (O.C.)

Total line length: _____ feet

# of Lines: _____ @ _____ feet

Depth of Media: _____ inches (Type) _____

Distribution Device: _____

Bed Design *(For Repair Installations ONLY.)* ☑ N/A

Bed Depth: _____ inches

Bed Width: _____ feet

Total line length: _____ feet

# of Lines: _____ @ _____ feet

Depth of Media: _____ inches (Type) _____

Distribution Device: _____

Tank Only

Water Supply Source

☐ Municipal ☑ Private Well ☐ Community Well

☐ Other _____


Minimum System Setbacks

Distance from Building Foundation: 5 feet

Distance from Property Line: 10 feet

Distance from Water Supply Source: 50' feet

SKETCH OF SYSTEM LAYOUT
(Proposed Layout)

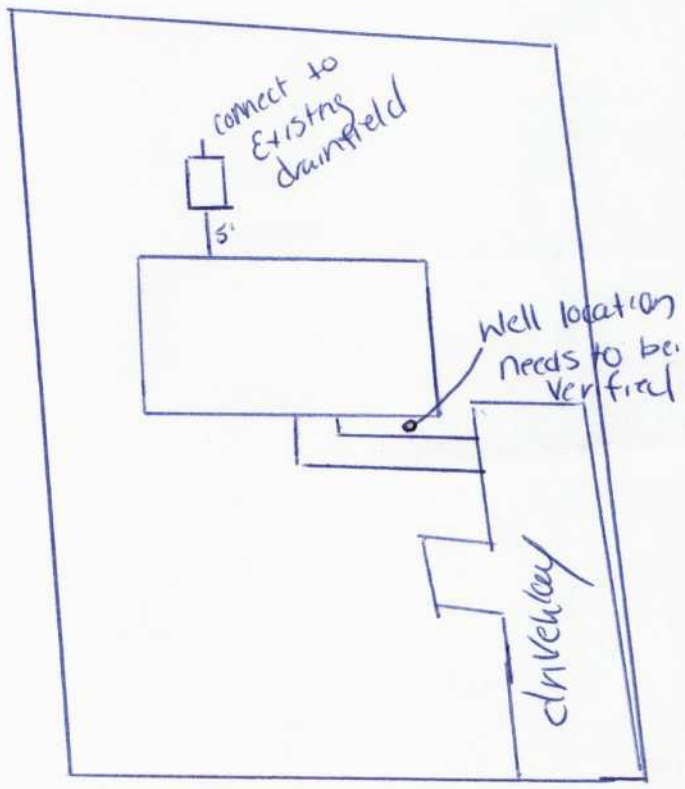

Comments: System Classification & Type: Tank Only. Preconstruction meeting required

Authorized Agent: Heather Ray Signature: Heather Ray

Owner Signature: _____ Date: _____