SEE INSTRUCTIONS ON BACK

Date Received 9-21-79

ICAR(S) Application No. 8735

T. C. No 219-082-18


Map Date

MECKLENBURG COUNTY
DEPARTMENT OF ENVIRONMENTAL HEALTH

Application for an
Installation, Construction, Alteration, and/or Repair Permit
(Individual Septic Tank System with Subsurface, Soil Absorption, Effluent Discharge)

The owner of that property described hereinafter hereby applies to the Mecklenburg County Department of Environmental Health for a permit to

1) ✓ Install or Construct 2) Alter or Repair an individual septic tank wastewater treatment system with a subsurface soil absorption effluent discharge

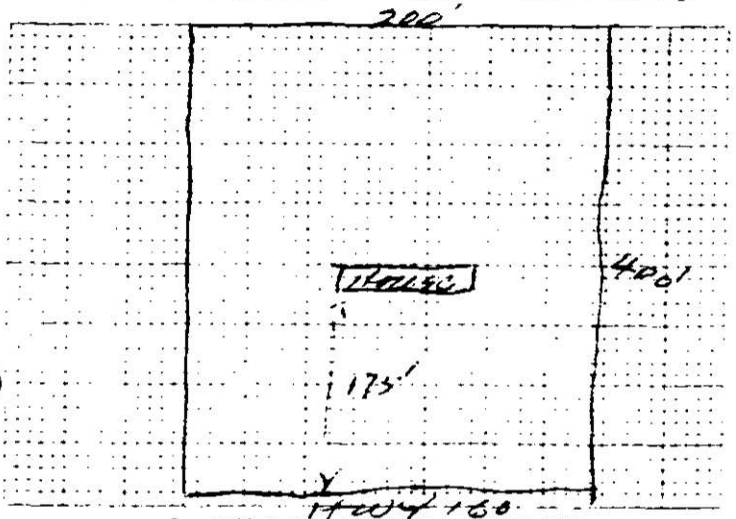

3) PLOT PLAN (ACCURATELY DIMENSIONED)

Mobile Home Yes ___ No
Fee Simple ✓ Yes ___ No
4) No. of Bedrooms 3
5) Business Use Yes No
Emp. Size ___
6) Washing Machine ✓ Yes ___ No
Sewage Disposal Yes ___ No
7) Dishwasher ___ Yes ___ No
8) Water Supply
A. Individual Well ✓
B. Governmental System ___
C. Community System
Well Source ___
2. Governmental Source ___
9) Sewage System
a. Is any supply well within 100 feet of proposed system? Yes ___ No
b. Is any public water supply well within 1000 feet of proposed system? ___ Yes ___ No
10) EHA Case No. ___
11) EHA Case No. ___

13) NAME OF OWNER Lawrence (LAST) Wade (FIRST) G (MIDDLE)

14) ADDRESS OF OWNER Rt 1 Box 48 Pineville N. C. 28134

15) PHONE NO. Home 588-0089 Office ___

16) LOCATION OF SYSTEM Hwy 160 (STREET OR COUNTY ROAD)

17) SUBDIVISION ___ Lot No ___ Block No ___

Map Book No ___ Page No ___

18) DEED REFERENCE — DEED BOOK ___ AT PAGE ___

19) HAS A SOIL INVESTIGATION BEEN RUN? ✓ YES NO DATE RUN ___

20) PTR NUMBER (See Instructions)

The undersigned person hereby agrees that he has read the foregoing application and that the contents of same are true. It is understood that any permit applied for herein shall be void and of no effect if any of the above facts are not true.

DATE OF APPLICATION 9-21-79

OWNER Wade G. Lawrence

EHD-5-76

ENVIRONMENTAL HEALTH DEPARTMENT'S COPY

Date Issued 9-21-79


Serial 3188

ICAR(S) Permit No. 8735 -
T C 19-082-18

Map Date

MECKLENBURG COUNTY
DEPARTMENT OF ENVIRONMENTAL HEALTH
INSTALLATION, CONSTUCTION, ALTERATION, AND/OR REPAIR PERMIT
(Individual Septic Tank System with Subsurface, Soil Absorption, Effluent Discharge)

Permission is hereby given to ✓ Install or Construct, __ Alter or Repair the individual septic tank wastewater treatment system with subsurface soil absorption effluent discharge as specified herein at the described location. This permit is granted based upon the information supplied in application 8735, dated 9-21-79 and this permit shall be void and of no effect if the information provided in the application is not true or is erroneous. All work shall be completed on or before 10-21-79, after which date this permit shall be null and void.

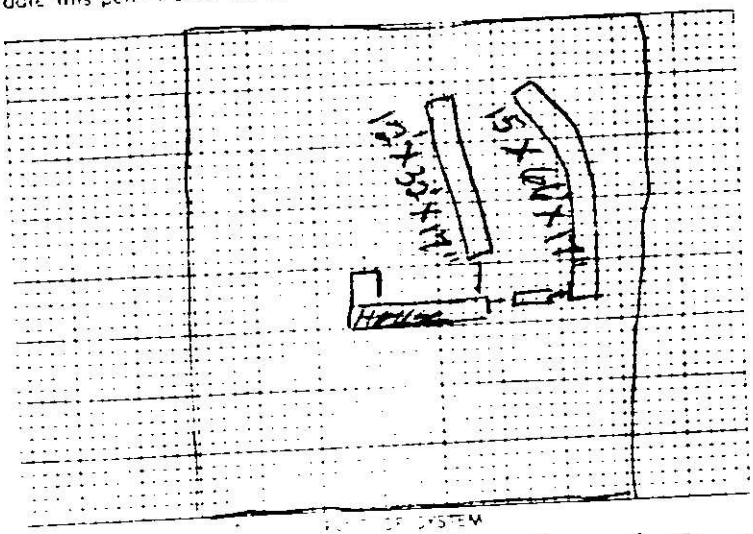

PLAN OF SYSTEM

Permeability Rate P/S

Liquid Capacity of Tank 1500

Tank Construction P/C

Absorption and or Nitrification Lines

Total Line Length 330' - 125'

Number of Lines 5 - 4

Distance from House 10'+

Distance from Property Line 10'+

Distance from Well 50'+

NAME OF OWNER Wade & Lawrence

LOCATION OF PROPERTY Hwy 160

The system shall meet all of the minimum requirements as set forth in the Regulations of the Mecklenburg County Health Commission and be in effect on the date of the granting of this permit. A certificate of approval must be issued by the Environmental Health Director before any system can be covered up or otherwise rendered uninspectable if it can be used. The issuance of this permit does not in any way guarantee that the system anticipated to be constructed will operate properly, or relieve any person now or hereafter owning or trafficking or using such system from any liability resulting from the failure of the system to operate properly.

Marshall Edwards
Environmentalist

Division or Section Head

* If this permit is for the installation or construction of a new system, it must be signed by the division or section head of the Department of Environmental Health in order to be valid. Only the signature of the Environmentalist is required where an existing system is being altered or repaired.

EHD-S-76

Environmental Health Department's Copy

C of A (s) No. 8235

Date Issued 30 Nov 1979 Serial 3289 T C No 219-082-12

MECKLENBURG COUNTY
DEPARTMENT OF ENVIRONMENTAL HEALTH
ENVIRONMENTAL HEALTH DIVISION

CERTIFICATE OF APPROVAL
(Individual Septic Tank System with Subsurface, Soil Absorption, Effluent Discharge)

Name of Owner Lawrence, Wade G (LAST, FIRST, MIDDLE)

Location of Property Hwy 160

Application Number _____ Permit Number 5935

Inspection Data:

Liquid Capacity of Tank 1000 gal Tank Material precast

Total Length of Drain Tile 330 @ 25 Number of Lines 5 @ 4

Depth of Filter Material 12" Cover Depth 15" to 20"

Water Supply Source well Distance from Water Source 50'+

Excavation Inspected — Tank Inspected 30 Nov 1979 (DATE)

Nitrification Field Inspected by M. Edwards (DATE)

Washing Machine Line Inspected If Applicable 30 Nov 1979 (DATE)

The undersigned has inspected the Individual Septic Tank System with subsurface, soil absorption, effluent discharge as described above and it has been ✓ installed constructed altered or repaired in accordance with the permit issued and the regulations of the Mecklenburg County Health Commission in effect on the date of issuance of the permit. The issuance of this Certificate of Approval does not in any way guarantee that the system will operate properly or relieve any person now or hereafter owning, controlling or using such system from any liability resulting from the failure of the system to operate properly. This Certificate of Approval is issued subject to those restrictions and conditions shown on the permit and in addition to those listed below under comments. This Certificate of Approval shall be null and void if any information contained in the application is untrue or if any additions are made to the property which would increase the requirements for said system.

Comments installed as permitted

John Richardson
Environmentalist

EHD-5-76

Environmental Health Department's Copy