

2508 WOOD STAR CT

19333422

5/30/08

marliwr

Groundwater and Wastewater Services File Imaging Project
May 2007
Barcode Font = IDAutomationHC39M

CERTIFICATE OF COMPLETION/OPERATION PERMIT

HEALTH DEPARTMENT
ENVIRONMENTAL HEALTH DIVISION
700 NORTH TRYON ST., SUITE 211
CHARLOTTE, NC 28202
PHONE (704) 336-5102

FILE: 7517 DATE: 2-10-98

TC: 193-334-22 ☒ L ☐ CRT

SERIAL Nº 17118

Name of Owner LEON THEAT Juris.:

Address of Property 2508 WOODSTAR COURT

Inspection Data:

Tank Material NA

Total Length of Drainfield 180

Number of Lines 1 @ 50 BED

Cover Depth 12" SOIL

Water Supply Source MUNICIPAL


Distance to Water Source 50'

Excavation Inspected 2-10-98

Tank(s) Inspected NA

Wash Line Inspected NA

High Water Alarm Inspected NA

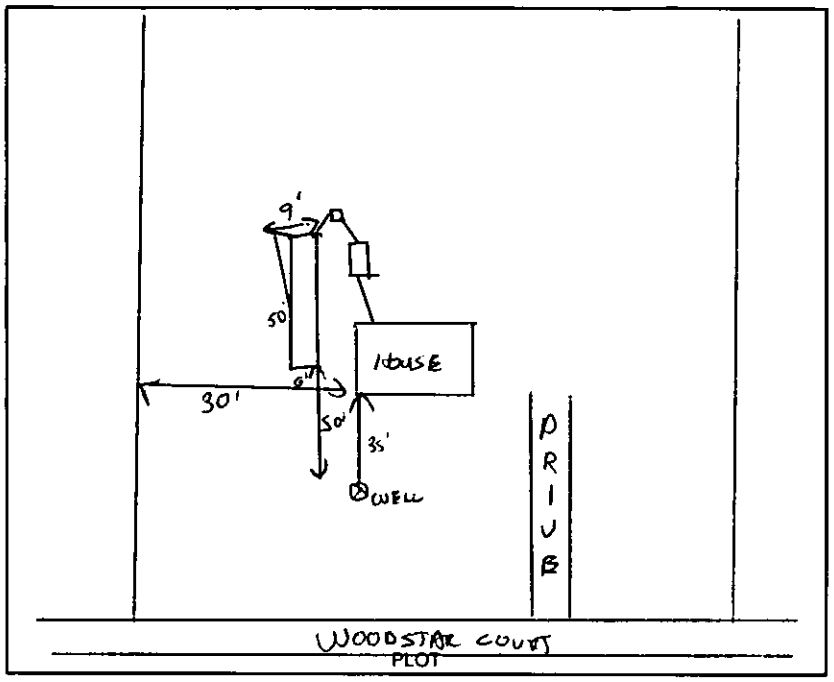

Design REPAIR - BED 7' WIDE, BY 50' LONG CTR# PERRY LANEY

The undersigned has inspected the Septic Tank System described above, and certifies it has been

☐ installed or constructed ☐ altered or repaired

☐ in accordance with the permit issued ☒ as detailed in the plot above

and meets the provisions of I5A NCAC 18A. 1900, "Laws And Rules For Sewage Treatment and Disposal Systems" in effect on the date of issuance of the permit. This issuance of this

☐ Certificate of Completion ☒ Operation Permit

does not in any way guarantee that the system will operate properly or relieve any person now or hereafter owning, controlling, or using such system from any liability resulting from the failure of the system to operate properly. This document is issued subject to those restrictions and conditions shown on the permit(s) and the provisions of I5A NCAC 18A. 1990 in addition to those listed below under "COMMENTS." This document shall be null and void if any information contained in the application is untrue or if any additions are made to the property which would increase the requirements for said system.

Notice: Disturbance of the designated repair area may result in the suspension/revocation of this permit.

COMMENTS: BED WAS EXPANDED TO 9' WIDE @ BEGINNING OF DRAINLINE TO KEEP DRAINFIELD 50' FROM WELL. TOTAL SQUARE FOOTAGE WAS INSTALLED OD < 1988

J Andrew Walker RS
Environmental Health Specialist

Mecklenburg County services are available without regard to ethnic origin, sex, or disability.

INSTALLATION, CONSTRUCTION, ALTERATION, AND/OR REPAIR APPROVAL


HEALTH DEPARTMENT
ENVIRONMENTAL HEALTH DIVISION
700 NORTH TRYON ST., SUITE 211
CHARLOTTE, NC 28202
PHONE (704) 336-5102

FILE: 7517 DATE: 2-5-98

TC: 193-334-22

SERIAL Nº 17378

Permission is hereby given to _____ Install or Construct, ✓ Alter or Repair the individual septic tank wastewater treatment system with subsurface, soil absorption, effluent discharge as specified herein at the described location. This permit is granted based upon the information supplied in the application dated 1-30-98. All work shall be completed on or before 3-5-98, after which date this permit shall be null and void. The system shall meet all of the construction requirements of 15A NCAC 18A. 1900 which are in effect on the date of the granting of this permit. A Certificate of Completion or an Operation Permit must be obtained from the Mecklenburg County Health Department before any system can be covered up or placed into service. The issuance of this permit does not in any way guarantee that the system anticipated to be constructed will operate properly, or relieve any person now or hereafter owning, controlling or using such system from any liability resulting from the failure of the system to operate properly.

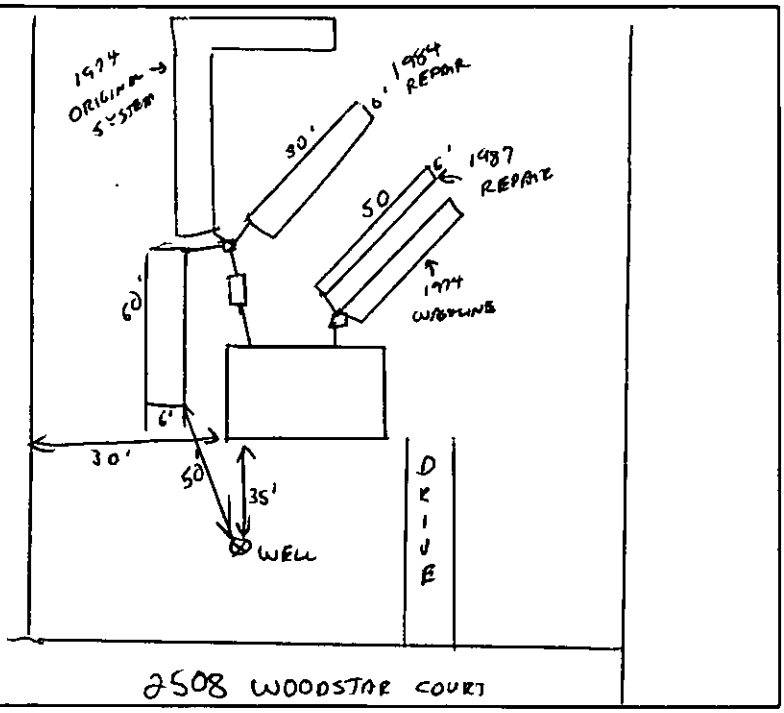

PLOT OF SYSTEM

Liquid Capacity of Septic Tank _____ gallons

Liquid Capacity of Dosing Tank NA gallons

Tank Construction PCC

Trench Depth 24"

Absorption and/or Nitrification Lines:

Trench Width 6' feet

Trench Walls Scored and Porous Yes

Total Line Length 180' feet

Number of Lines 1

Depth of Stone 18" inches

Distance from House 5' feet

Distance from Property Line 10' feet

Distance from Well 50' feet

NOTICE: This system shall not be installed while soils are in a wet condition.

NAME OF OWNER LEON THREATT

LOCATION OF PROPERTY 2508 WOODSTAR COURT

Comments: INSTALL NEW BED 6' WIDE, 60 FEET LONG, W/ 18" STONE. UTILIZE EXISTING DRAINFIELD. PLACE OUTLET LEADING INTO NEW DRAINFIELD HIGHER TO INSURE NEW DRAINFIELD WILL RECEIVE EFFLUENT OVERFLOW FROM OLD DRAINFIELD

J. Andrew Walker RS
Environmental Health Specialist

FEE: N/A
DATE: _____

APPLICATION FOR IMPROVEMENT PERMIT FOR RESIDENTIAL SITE INDIVIDUAL WATER AND WASTEWATER SYSTEMS PROGRAM

Repair

[ ] CRT

TYPE APPLICATION: ___ NEW SYSTEM ___ EXPANSION/ ALTERATION OF EXISTING SYSTEM ___ REPAIR OF EXISTING SYSTEM

NORTH CAROLINA
DEPARTMENT OF ENVIRONMENT,
HEALTH, AND NATURAL RESOURCES
DIVISION OF ENVIRONMENTAL HEALTH
ON-SITE WASTEWATER SECTION

FILE #: 7517

PROPERTY INFORMATION (FROM ENGINEERING FORM) FOR JOB LOCATION:

TAX/PARCEL NUMBER: 193 334 22

STREET ADDRESS: 2508 Woodstar Court

SUBDIVISION OR MOBILE HOME PARK NAME: Forest Ridge

LOT NUMBER:

TYPE OF BUILDING (CHECK ONE):

___ SINGLE MOBILE HOME(S)
___ DOUBLE WIDE (D)
___ HOUSE (H)
___ MODULAR HOME (M)
___ MULTIPLE FAMILY (U)
___ OTHER (O)

TOWNSHIP (CHECK ONE):

___ 0 MECKLENBURG
___ 1 CHARLOTTE
___ 2 DAVIDSON
___ 3 CORNELIUS
___ 4 PINEVILLE
___ 5 MATTHEWS
___ 6 HUNTERSVILLE
___ 7 MINT HILL

HEATED SQUARE FOOTAGE:

NUMBER OF BEDROOMS: 4 NUMBER OF OCCUPANTS: 4

CLOSING DATE _____

FOUNDATION FOR RESIDENCE:

___ WITHOUT BASEMENT
___ ON SLAB
___ CRAWL SPACE
___ WITH BASEMENT /PLUMBING
___ WITH BASEMENT /NO PLUMBING

IF EXPANSION/ALTERATION OF EXISTING SYSTEM, DESCRIBE THE PROPOSED BUILDING ADDITION:

WILL THERE BE A HOME BUSINESS IN THE RESIDENCE: ___ YES ___ NO TYPE: _____

WATER SUPPLY (CHECK ONE):

___ COMMUNITY (C)
✓ MUNICIPAL (M)
___ PRIVATE WELL (P)
___ SHARED WELL (S)
___ OTHER 'SPRINGS' (O)

IF ANY OF THE FOLLOWING ARE LOCATED ON THE PROPERTY, PLEASE SHOW LOCATION ON PLAT:

BURIED CABLES, LANDFILLS, STUMPHOLES ___ YES ___ NO
EXISTING WASTEWATER SYSTEMS ___ YES ___ NO
EASTMENTS OR RIGHT-OF-WAYS ___ YES ___ NO
WELL, SPRINGS OR WATERLINES ___ YES ___ NO
DESIGNATED WETLANDS ___ YES ___ NO

PROPERTY OWNER:

NAME: Threatt, Archie Leon
(LAST) (FIRST) (MI)

ADDRESS:

CITY: STATE: ZIP:

DAYTIME PHONE: ( ) —

LEGAL AGENT FOR PROPERTY OWNER, IF APPLICABLE:

NAME:
(LAST) (FIRST) (MI)

DAYTIME PHONE: ( ) —

WHAT DATE WAS THE PROPERTY ORIGINALLY DEEDED AND RECORDED? _____

An Improvement Permit is subject to suspension or revocation if site plans or the intended use change or if information submitted in this application is falsified or changed. The undersigned, owner, or legal agent for the owner, of the property described above as the "Job Location" has read the foregoing application, acknowledges that the contents of same are true, and authorizes agents of the Mecklenburg County Health Department to enter onto the property for the purpose of processing this request.

SIGNED: Archie Leon Threatt DATE: 30 Jan 98

MECKLENBURG COUNTY HEALTH DEPARTMENT
ENVIRONMENTAL HEALTH DIVISION
c/o HAL MARSHALL CTR., SUITE 211, 700 N. TRYON ST., CHARLOTTE, N.C. 28202., (704) 336-5102