Date Received Aug. 14, 1978 SEE INSTRUCTIONS ON BACK

14447

ICAR(S) Application No. 137-113-07

T C. No. ~~137-113-07~~


Map Date 4-23-78

MECKLENBURG COUNTY
DEPARTMENT OF ENVIRONMENTAL HEALTH

Application for an
Installation, Construction, Alteration, and/or Repair Permit
Individual Septic Tank System with Subsurface, Soil Absorption, Effluent Discharge

The owner of the property described hereinafter hereby, applies to the Mecklenburg County Department of Environmental Health for a permit to USE EXISTING SYSTEM Construct New House

1) ___ Construct 2) ✓ Alter or Repair an individual septic tank wastewater treatment ___ with ___ soil absorption, soil absorption effluent discharge.

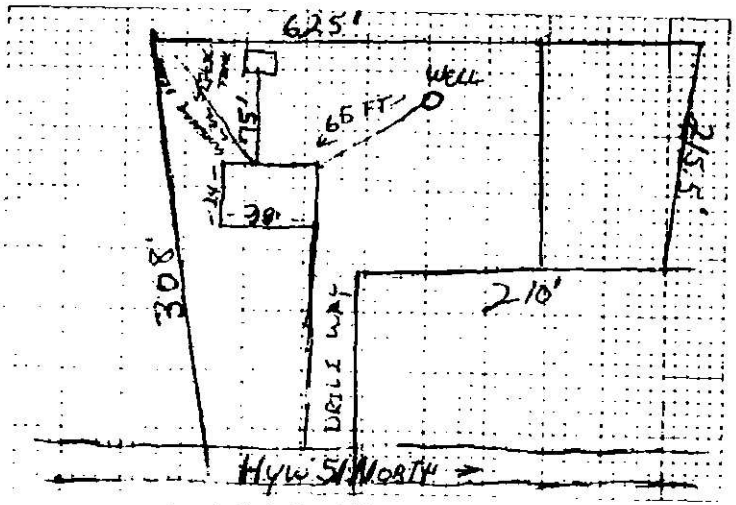

3) ___ NOT ACCURATELY DRAWN.

Mobile Home	Yes	No
Residence	✓ Yes	No
4) No. of Bedrooms	3	
5) Business Use - Max. No. Employees		
6 Washing Machine	✓ Yes	No
7 Garbage Disposal	Yes	No
8 Dishwasher	Yes	No
9 Water Supply		
A Individual Well	✓	
B Government System		
C Community System		
1 Well source		
2 Environmental source		
Sewage System		
House ___ feet of public sewer	Yes	No
House ___ feet of community sewer	Yes	✓ No
10) EHA Case No.		
11) LA Case No.		

12) NAME OF OWNER Hartsell (LAST) Vance (FIRST) C (MIDDLE)

13) ADDRESS OF OWNER 9113 Tyvola Road Charlotte N.C.

14) PHONE NO. Home 545-[illegible] Office 545 4082

15) LOCATION OF SYSTEM 9113 [illegible] Tyvola (STREET OR COUNTY ROAD) Charlotte, N.C.

16) SUBDIVISION ___ Lot No. ___ Block No 9113

Map Book No. ~~[illegible]~~ 2641 Page No ~~[illegible]~~ 563

17) PREVIOUS REFERENCE DEED BOOK [illegible] AT PAGE 326

18) [illegible] DATE RUN

19) [illegible]

The undersigned hereby agrees that he has read the foregoing application and that the contents thereof are true and it is understood that any permit applied for herein shall be void and of no effect if any of the above be false or not true.

8-12-78
DATE OF APPLICATION

Joyce W. Hartsell
OWNER

Environmental Health Department's Copy

Serial No. 2139

LA No. 14447

Date Issued August 17, 1978

T. C. No. 137-113-07

Map Date

MECKLENBURG COUNTY
DEPARTMENT OF ENVIRONMENTAL HEALTH

TO THE BUILDING INSPECTION DEPARTMENT

IMPROVEMENT PERMIT

APPROVAL OF LOT FOR INSTALLATION OF AN INDIVIDUAL SEPTIC TANK WITH SUBSURFACE, SOIL ABSORPTION, EFFLUENT DISCHARGE

NAME OF OWNER Hartsell (LAST) Vance (FIRST) C. (MIDDLE)

ADDRESS OF OWNER 9113 Blair Road, Charlotte, NC ZIP 28212

LOCATION OF LOT 9113 Blair Road (STREET OR COUNTY ROAD)

SUBDIVISION _____ LOT NO. _____ BLOCK NO. _____

MAP BOOK NO. _____ PAGE NO. _____

The above specified lot is approved by the Mecklenburg County Department of Environmental Health for the installation of an individual septic tank system with subsurface, soil absorption, effluent discharge based on the soil investigation, on an on-site inspection of the said lot, and upon the information supplied in the "Application for an Installation, Construction, Alteration, and/or Repair Permit", number 14447. This approval is subject to the following terms and conditions:

1. That the nitrification field be installed, constructed, altered and/or repaired in the same area where the soil investigation was run.
2. That an "Installation, Construction, Alteration, and/or Repair Permit" be issued and in full force and effect when the system is installed, constructed, altred, and/or repaired and that the system be installed in accordance with same.

This approval may be revoked and the building inspection department requested to revoke any building permit(s) which have been issued to authorize construction on the said lot if at any time it is determined that any information obtained in the "Application for an Installation, Construction, Alteration, and/or Repair Permit" is not correct or is untrue or that the septic tank system is not being installed, constructed, altered and/or repaired in accordance with a valid Installation, Construction, Alteration, and/or Repair Permit.

*Present residence to be removed upon completion of new construction.

Environmentalist

John R. Adkisson
Environmental Health Director, or Authorized Section Head

EHD 5-74

Environmental Health Department's Copy

Date Issued 17 Aug 1978

Serial No. 1852


ICAR(S) Permit No. 14447

T. C. No. 137-113-07

Map Date —

MECKLENBURG COUNTY
DEPARTMENT OF ENVIRONMENTAL HEALTH
INSTALLATION, CONSTUCTION, ALTERATION, AND/OR REPAIR PERMIT
(Individual Septic Tank System with Subsurface, Soil Absorption, Effluent Discharge)

Permission is hereby granted to ~~Install~~ or Construct, ✓ Alter or Repair the individual septic tank wastewater treatment system with subsurface, soil absorption, effluent discharge as specified herein at the described location. This permit is granted based upon the information supplied in application 14447, dated 12 Aug 78. ~~This~~ permit shall be void and of no effect if the information provided in the application is ~~or true~~ found to be false. All work shall be completed on or before 12 Sept 78, after which date this permit shall be null and void.

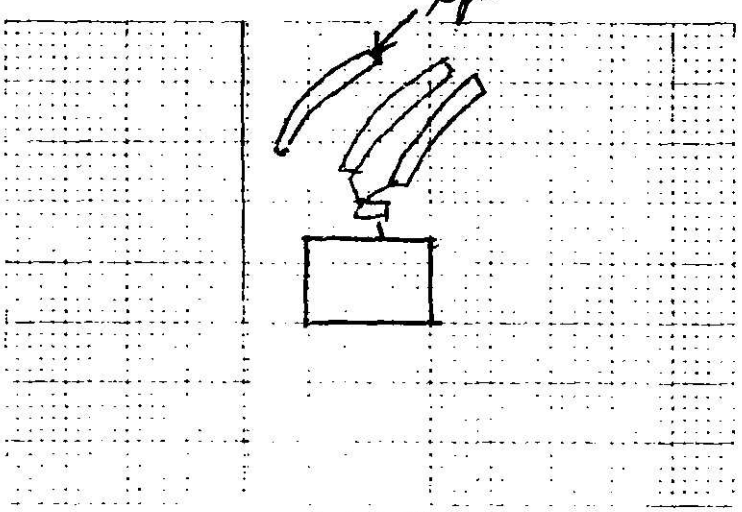

Permitted Use —

Expected Capacity of Bed Repair

Type of Construction —

Area per Lineal Foot of Distribution Line

Total Lineal Footage 100 l/ft

Number of Lines 2

Length of Lines 25' +

Trench Depth Required 10'

Distance from Well 50' +

SYSTEM

NAME OF OWNER Hartsell, Vance C.

LOCATION OF PROPERTY 9113 Blair Rd.

The system is to be installed as set forth in the Regulations of the Mecklenburg County Health Department governing the granting of this permit. A certificate of approval will be issued after the system has been inspected and before any system can be covered up or otherwise rendered inaccessible for inspection. **The issuance of this permit doesn't in any way guarantee that the system anticipated to be constructed will operate properly, or relieve any person [illegible] now or hereafter owning, controlling or using such system from any liability resulting from the failure of the system to operate properly.**

in bed 6'x25'x38" #4 stone

John R. Atkisson

Environmentalist

*If this permit is for the repair, alteration or reconstruction of a new system, it must be signed by the division or a section head of the Department of Environmental Health in order to be valid. Only the signature of the Environmentalist is required when an existing system is being altered or repaired.

EHC-5-76

Applicant's Copy

Date Issued Aug. 21, 1978 **Serial No. 1826** C of A (s) No. 14447

T C. No. 137-113-07

MECKLENBURG COUNTY
DEPARTMENT OF ENVIRONMENTAL HEALTH

ENVIRONMENTAL HEALTH DIVISION
CERTIFICATE OF COMPLETION
CERTIFICATE OF APPROVAL

(Individual Septic Tank System with Subsurface, Soil Absorption, Effluent Discharge)

Name of Owner Hartsell (LAST) Vance (FIRST) C. (MIDDLE)

Location of Property 9113 Blair Rd.

Application Number 14447 Permit Number 14447

Inspection Data:

Liquid Capacity of Tank — Tank Material —

Total Length of Drain Tile 100 Lft. Number of Lines 3

Depth of Filter Material 36" Cover Depth 18"

Water Supply Source Well Distance from Water Source 50'+

Excavation Inspected — (DATE) Tank Inspected — (DATE)

Nitrification Field Inspected 8-21-78 (DATE)

Washing Machine Line Inspected If Applicable — (DATE)

The undersigned has inspected the Individual Septic Tank System with subsurface, soil absorption, effluent discharge as described above and it has been ✓ installed or constructed, altered or repaired in accordance with the permit issued and the regulations of the Mecklenburg County Health Code in effect at the date of issuance of the permit. The issuance of this Certificate of Approval does not in any way guarantee that the system will operate properly or relieve any person now or hereafter owning, controlling, or using such system from any liability resulting from the failure of the system to operate properly. This Certificate of Approval is issued subject to those restrictions and conditions shown on the permit(s) in addition to those listed below under comments. This Certificate of Approval shall be null and void if any information contained in the application is untrue or if any additions are made to the property which would increase the requirements for said system.

Comments:

Environmentalist

EHD-5-76

Environmental Health Department's Copy