SUPERVISOR/ADMINISTRATIVE PROFESSIONAL CHECKLIST

☐ NEW SEPTIC ☐ REPAIR ☒ USE EXISTING ☐ MODIFIED PLOT PLAN ☐ ALTERATION

File Number: 1732B

Assigned Inspector: Kim Garrett

☐ IP $250.00: _____ Initial/Date

☐ IP Commercial $450.00: _____ Initial/Date

☐ CA & OP $400.00: _____ Initial/Date

☐ Alteration Fees $300: _____ Initial/Date

☐ Modified Plot Plan Fees $100.00: _____ Initial/Date

☒ Use Existing Fees $100.00: QO 9/7/23 Initial/Date

☒ Use Existing Approved ☐ Use Existing Denied

KSG — plz release hold

☐ Send IP permit for signature: _____ ☐ Signature received: _____

☐ Floor plans reviewed

☐ Generate CA ☐ Approve as Noted in Winchester

☐ This site is served by septic and well. Verify each is complete before final hold is released

☐ This septic system requires a certified operation contract before final hold is released

☐ Certified operator contract is on file: _____

☐ Septic file complete: _____

☐ Release final hold in Winchester: _____

Comments:

MECKLENBURG COUNTY
HEALTH DEPARTMENT

17328 / 14117

APPLICATION FOR APPROVAL TO USE AN EXISTING ON-SITE WASTEWATER TREATMENT & DISPOSAL SYSTEM / WATER SUPPLY WELL

APPLICATION TYPE: ○ SEPTIC ONLY ○ WELL ONLY ◉ SEPTIC & WELL
○ ADDITION OR RENOVATION WITH OCCUPANCY INCREASE
☒ ADDITION OR RENOVATION WITH NO OCCUPANCY INCREASE
○ EXCHANGE MOBILE HOME (SAME # BEDROOMS)
○ COMMERCIAL OR INDUSTRIAL

PERSON FILING APPLICATION:
NAME: Nicholas Howard
ADDRESS: 11525 Asbury Chapel Rd
CITY: Huntersville
STATE: NC ZIP: 28078
PHONE: 704 280 6230
ALTERNATE PHONE:
E-MAIL: lkn lawn medic @ gmail.com

PROPERTY OWNER: ☒ SAME AS PERSON FILING APPLICATION
NAME:
ADDRESS:
CITY:
STATE: ZIP:
PHONE:
ALTERNATE PHONE:
E-MAIL:

JOB LOCATION INFORMATION
TAX PARCEL #: 01935110
STREET ADDRESS: 11525 Asbury Chapel Rd
CITY: Huntersville
STATE: NC ZIP: 28078

SUBDIVISION OR MOBILE HOME PARK NAME:
LOT #:

WATER SUPPLY:
○ MUNICIPAL ☒ PRIVATE WELL ○ PUBLIC WELL ○ SHARED WELL ○ OTHER

RESIDENTIAL PROPERTY TYPE: ○ N/A
☒ HOUSE ○ MODULAR HOME ○ MULTIPLE FAMILY
○ SINGLE MOBILE HOME ○ DOUBLE WIDE
○ OTHER

OCCUPANCY (both fields are required):
NUMBER OF BEDROOMS: 4
NUMBER OF OCCUPANTS: 3

COMMERCIAL / INDUSTRIAL PROPERTY TYPE: ☒ N/A
TYPE OF BUSINESS:
EMPLOYEES PER SHIFT:
OF SHIFTS:
INDUSTRIAL WASTES? ○ YES ○ NO
UNDERGROUND STORAGE TANKS? ○ YES ○ NO

ADDITION/RENOVATION TYPE ATTACHED TO EXISTING STRUCTURE:
☐ BEDROOM ☐ BATHROOM ☐ KITCHEN ☐ DINING ROOM ☐ LIVING ROOM ☐ DEN
☐ GARAGE ☐ SUNROOM ☒ PORCH ☐ DECK ☐ OTHER

ADDITION/RENOVATION TYPE DETACHED FROM EXISTING STRUCTURE:
☐ DETACHED GARAGE ☐ DETACHED GARAGE WITH PLUMBING ☐ POOL HOUSE ☐ SHOP ☐ BARN
☐ STORAGE SHED ☐ DETACHED PORCH / DECK ☐ OTHER

*The undersigned, owner, or legal agent for the owner, of the property described above as the "Job Location" has read the foregoing application, acknowledges that the contents of same are true, and authorizes the Mecklenburg County Health Department to enter onto the property for the purpose of processing this request.

N D Howard
Owner's/Agent's Signature

9/6/23
Date

A PROPOSED PLOT PLAN (see page 2) is required to be submitted with each application.

MECKLENBURG COUNTY – GROUNDWATER & WASTEWATER SERVICES
700 N. TRYON ST. SUITE 211 CHARLOTTE, NC 28202, OFFICE: 704-336-5103, FAX: 704-336-6894


Revised on: 01/03/11

File #: _____

PROPOSED PLOT PLAN

A drawing showing the locations of the following items is required: existing and proposed property lines with dimensions, easements or right-of-ways, proposed building pad(s) or existing building footprint(s), all appurtenances (garage, driveway, deck, pool, etc.), location of existing or proposed well(s), location of existing or proposed sewer lines and sewage disposal systems, surface water bodies, and any aboveground or underground storage tanks. Provide names for all roads that adjoin the property.

Street Address: _____ Tax Parcel #: _____

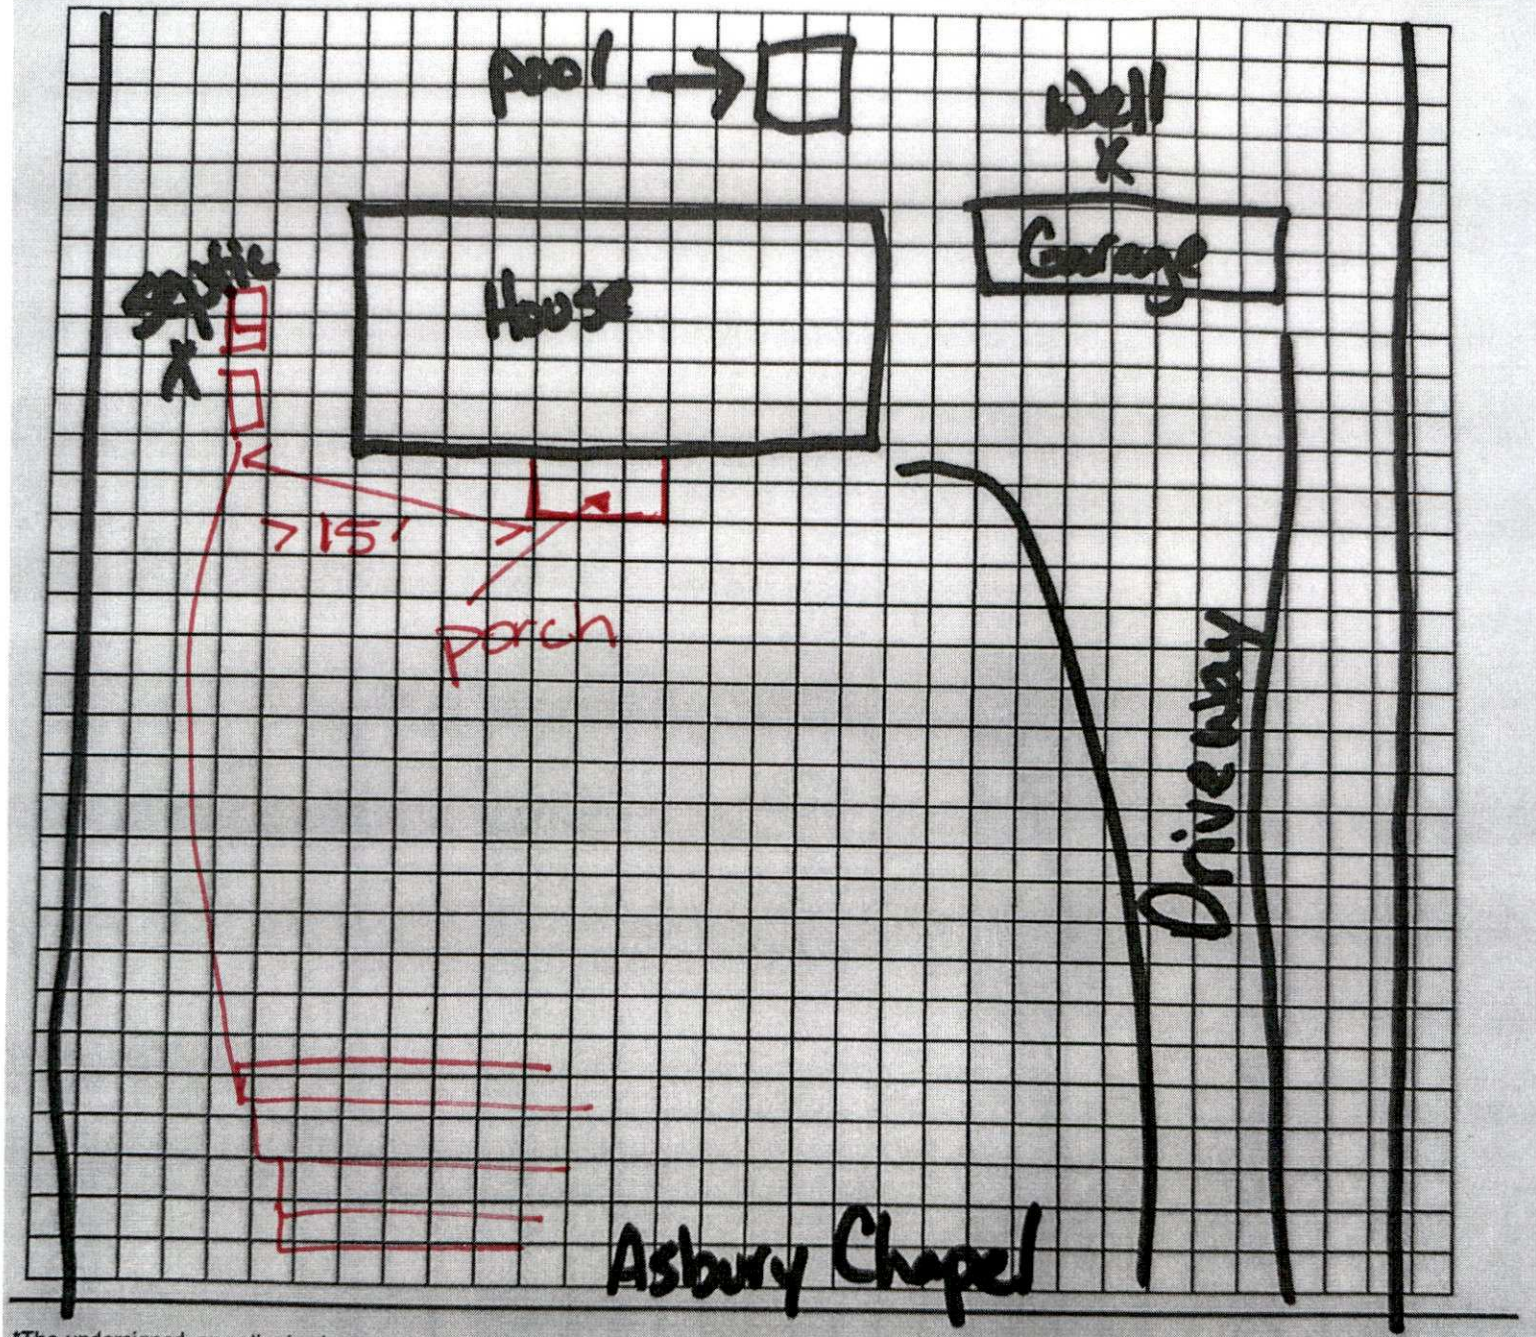

*The undersigned, an authorized agent of the Mecklenburg County Health Department, certifies that the Department has approved the Request for the "Job Location" contained in this document. This approval is granted in accordance with the provisions of Laws and Rules for Sanitary Sewage Collection, Treatment, and Disposal and Water Supply Wells in effect at the time of issuance of the permit and is subject to the following provisions:

- No work shall be conducted on the septic tank system until an installation, construction, alteration and/or repair approval is granted by this Department.
- This permit is not transferable.
- Addition/Renovation approval valid 1 year from issuance date
- Mobile home exchange approval valid 6 months from issuance date

Front porch project approved, meets > 5' setback off PT & ST

Kim Vanecek 9/13/23
REHS Signature Date

MECKLENBURG COUNTY – GROUNDWATER & WASTEWATER SERVICES
700 N. TRYON ST. SUITE 211 CHARLOTTE, NC 28202, OFFICE: 704-336-5103, FAX: 704-336-6894

Revised on: 01/03/11

Mecklenburg County Groundwater & Wastewater Services
3205 Freedom Dr. Suite 8000, Charlotte, NC 28208
Phone: (980) 314-1680 Fax: (704) 336-6894

NC DHHS
Division of Environmental Health
On-Site Wastewater Section

OPERATION PERMIT for an ON-SITE WASTEWATER TREATMENT & DISPOSAL SYSTEM

File #: 1732 B Permit #: 30011136 Tax Parcel #: 019-351-10

Property Owner: Andrew & Angela Villalobos

Job Location Address: 11525 Asbury Chapel Road

City: Huntersville State: NC Zip Code: 28078

Operation Permit Issuance Date: 3/20/20 Contractor Name: Tim Ammons #2943

Permitted Design Flow: 480 GPD Liquid Capacity of Dosing Tank: 1000 gallons

Liquid Capacity of Septic Tank: 1500 gallons Tank Manufacture existing Effluent Pump Model: existing

Drainfield Installation ☐ N/A

Trench Depth: 30 inches

Trench Width: 3 feet

Line Spacing: 9 feet (O.C.)

Total line length: 100 feet

# of Lines: 1 @ 100 feet

Depth of Media: 12 inches (Type) chambers

Depth of Cover: 18 inches

Distribution Device: Dbox

Bed Installation *(For Repair Installations ONLY.)* ☒ N/A

Bed Depth: _____ inches

Bed Width: _____ feet

Total line length: _____ feet

# of Lines: _____ @ _____ feet

Depth of Media: _____ inches (Type) _____

Depth of Cover: _____ inches

Distribution Device: _____

Water Supply Source

☐ Municipal ☒ Private Well ☐ Community Well

☐ Other _____

System Installation Setbacks

Distance from Building Foundation: >10 feet

Distance from Property Line: >10 feet

Distance from Water Supply Source: >50 feet


Inspection Dates

Tank(s) Inspected: existing

Excavation Inspected: 3/20/20

Pump & Controls Inspected: existing

SKETCH OF SYSTEM INSTALLATION
(As-Built Drawing)

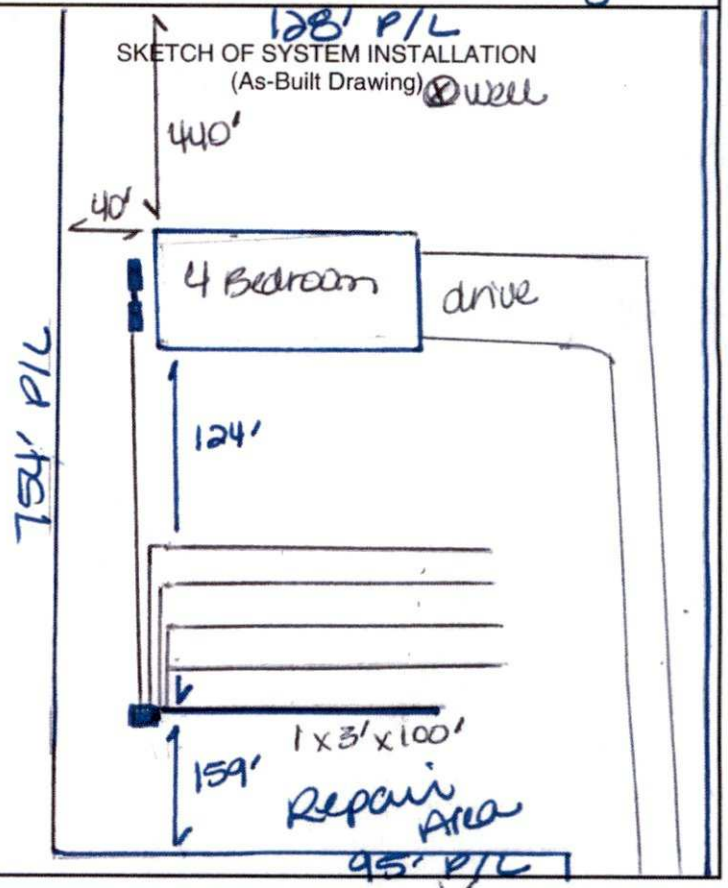

The undersigned has inspected the Septic Tank System described above, and certifies it has been ☐ installed ☒ altered ☐ repaired ☒ as detailed in the plot above ☐ in accordance with the permit issued and meets the provisions of 15A NCAC 18A. 1900, "Laws and Rules for Sewage Treatment and Disposal Systems" in effect on the date of issuance of the permit. The issuance of this Operation Permit does not in any way guarantee that the system will operate properly or relieve any person now or hereafter owning, controlling, or using such system from any liability resulting from the failure of the system to operate properly. This document is issued subject to those restrictions and conditions shown on the permit(s) and the provisions of 15A NCAC 18A. 1900 in addition to those listed below under "Comments." This document shall be null and void if any information contained in the application is untrue or if any additions are made to the property which would increase the requirements for said system.

Notice: Disturbance of the designated repair area may result in the Suspension or Revocation of this permit.

Comments: System Classification & Type: IIIb, pressure, IQ4, n/a, n/a

Alteration/Repair - dosing adjusted, light & alarm operate

DENR Authorized Agent: Kim Garrett, REHS Signature: Kim Garrett, REHS