


9907 ALBEMARLE RD

11116306

12/26/2007

duponbj

Groundwater and Wastewater Services File Imaging Project
May 2007
*Barcode Font = IDAutomationHC39M*

FEE: 350.00 cash
DATE: 8/9/96 JC

**INDIVIDUAL WATER AND WASTEWATER SYSTEMS PROGRAM**
**APPLICATION FOR IMPROVEMENT PERMIT FOR COMMERCIAL/INDUSTRIAL SITE**

Consultation made 8-3-96 with Jack Bryan & John Kanos present | | CRT

TYPE APPLICATION: X NEW SYSTEM ___ EXPANSION OF EXISTING SYSTEM ___ REPAIR OF EXISTING SYSTEM

NORTH CAROLINA
DEPARTMENT OF ENVIRONMENT,
HEALTH, AND NATURAL RESOURCES
DIVISION OF ENVIRONMENTAL HEALTH
ON-SITE WASTEWATER SECTION

Consultation

X COMMERICAL ___ INDUSTRIAL

DESCRIBE TYPE OF BUSINESS:
Restaurant
Square footage of facilities: 4320

NUMBER OF EMPLOYEES: 150 seats in Rest. PER SHIFT: ___ ___ ___

HOW WILL WATER BE USED IN THE FACILITY:
X TOLIETS/URINALS
X HANDSINK
___ SHOWERS
___ FLOOR DRAINS
OTHER, PLEASE DESCRIBE:

TYPE OF WASTEWATER:
X SEWAGE
___ INDUSTRIAL PROCESS WASTE WATER

FILE #: 1535B WM 8-7-96

PROJECT TRACKING #:

PROPERTY INFORMATION (FROM ENGINEERING FORM) FOR JOB LOCATION:

TAX/PARCEL NUMBER: 111-163-06

STREET ADDRESS: 9907 Albemarle Road, Charlotte NC 28212

LOT NUMBER:

TOWNSHIP (CHECK ONE):

| | |
|---|---|
| 0 MECKLENBURG | 4 PINEVILLE |
| X 1 CHARLOTTE | 5 MATTHEWS |
| 2 DAVIDSON | 6 HUNTERSVILLE |
| 3 CORNELIUS | 7 MINT HILL |

**An IMPROVEMENT PERMIT is subject to revocation if site plans or the intended use change.**

IF EXPANSION OF EXISTING SYSTEM, DESCRIBE THE PROPOSED ADDITION:

WATER SUPPLY (CHECK ONE): ___ COMMUNITY (C) X MUNICIPAL (M) ___ PRIVATE WELL (P) ___ SHARED WELL (S) ___ OTHER 'SPRINGS' (O)

IF ANY OF THE FOLLOWING ARE LOCATED ON THE PROPERTY, PLEASE SHOW LOCATION ON PLAT:

| | | | |
|---|---|---|---|
| BURIED CABLES, LANDFILLS, STUMPHOLES | ___ YES X NO | WELL SPRINGS OR WATERLINES | ? YES ___ NO |
| EXISTING WASTE WATER SYSTEMS | X YES ___ NO | DESIGNATED WETLANDS | ___ YES X NO |
| EASEMENTS OR RIGHT-OF-WAYS | X YES ___ NO | | |

BUILDING PLANS TO INCLUDE ALL PLUMBING, FLOOR DRAINS AND ALL SOURCES OF WASTEWATER DISCHARGE AND GRADING PLANS MAY BE REQUIRED DURING THE EVALUATION STAGE.

PROPERTY OWNER:

NAME: KANOS (LAST) John (FIRST) F. (MI)

ADDRESS: 7119 Chattanooga Ln.

CITY: Charlotte STATE: NC ZIP: 28227

DAYTIME PHONE: (704 545-8872

LEGAL AGENT FOR PROPERTY OWNER, IF APPLICABLE:

NAME: Bryan (LAST) Jack (FIRST) L. (MI)


DAYTIME PHONE: (704 541-5111

WHAT DATE WAS THE PROPERTY ORIGINALLY DEEDED AND RECORDED? 6/20/96

THE UNDERSIGNED, OWNER, OR LEGAL AGENT FOR THE OWNER, OF THE PROPERTY DESCRIBED ABOVE AS THE "JOB LOCATION" H
READ THE FOREGOING APPLICATION, ACKNOWLEDGES THAT THE CONTENTS OF SAME ARE TRUE, AND AUTHORIZES AGENTS OF TH
MECKLENBURG COUNTY HEALTH DEPARTMENT TO ENTER ONTO THE PROPERTY FOR THE PURPOSE OF PROCESSING THIS REQUES


SIGNED: John F. Kanos DATE: 8-9-96

1535B

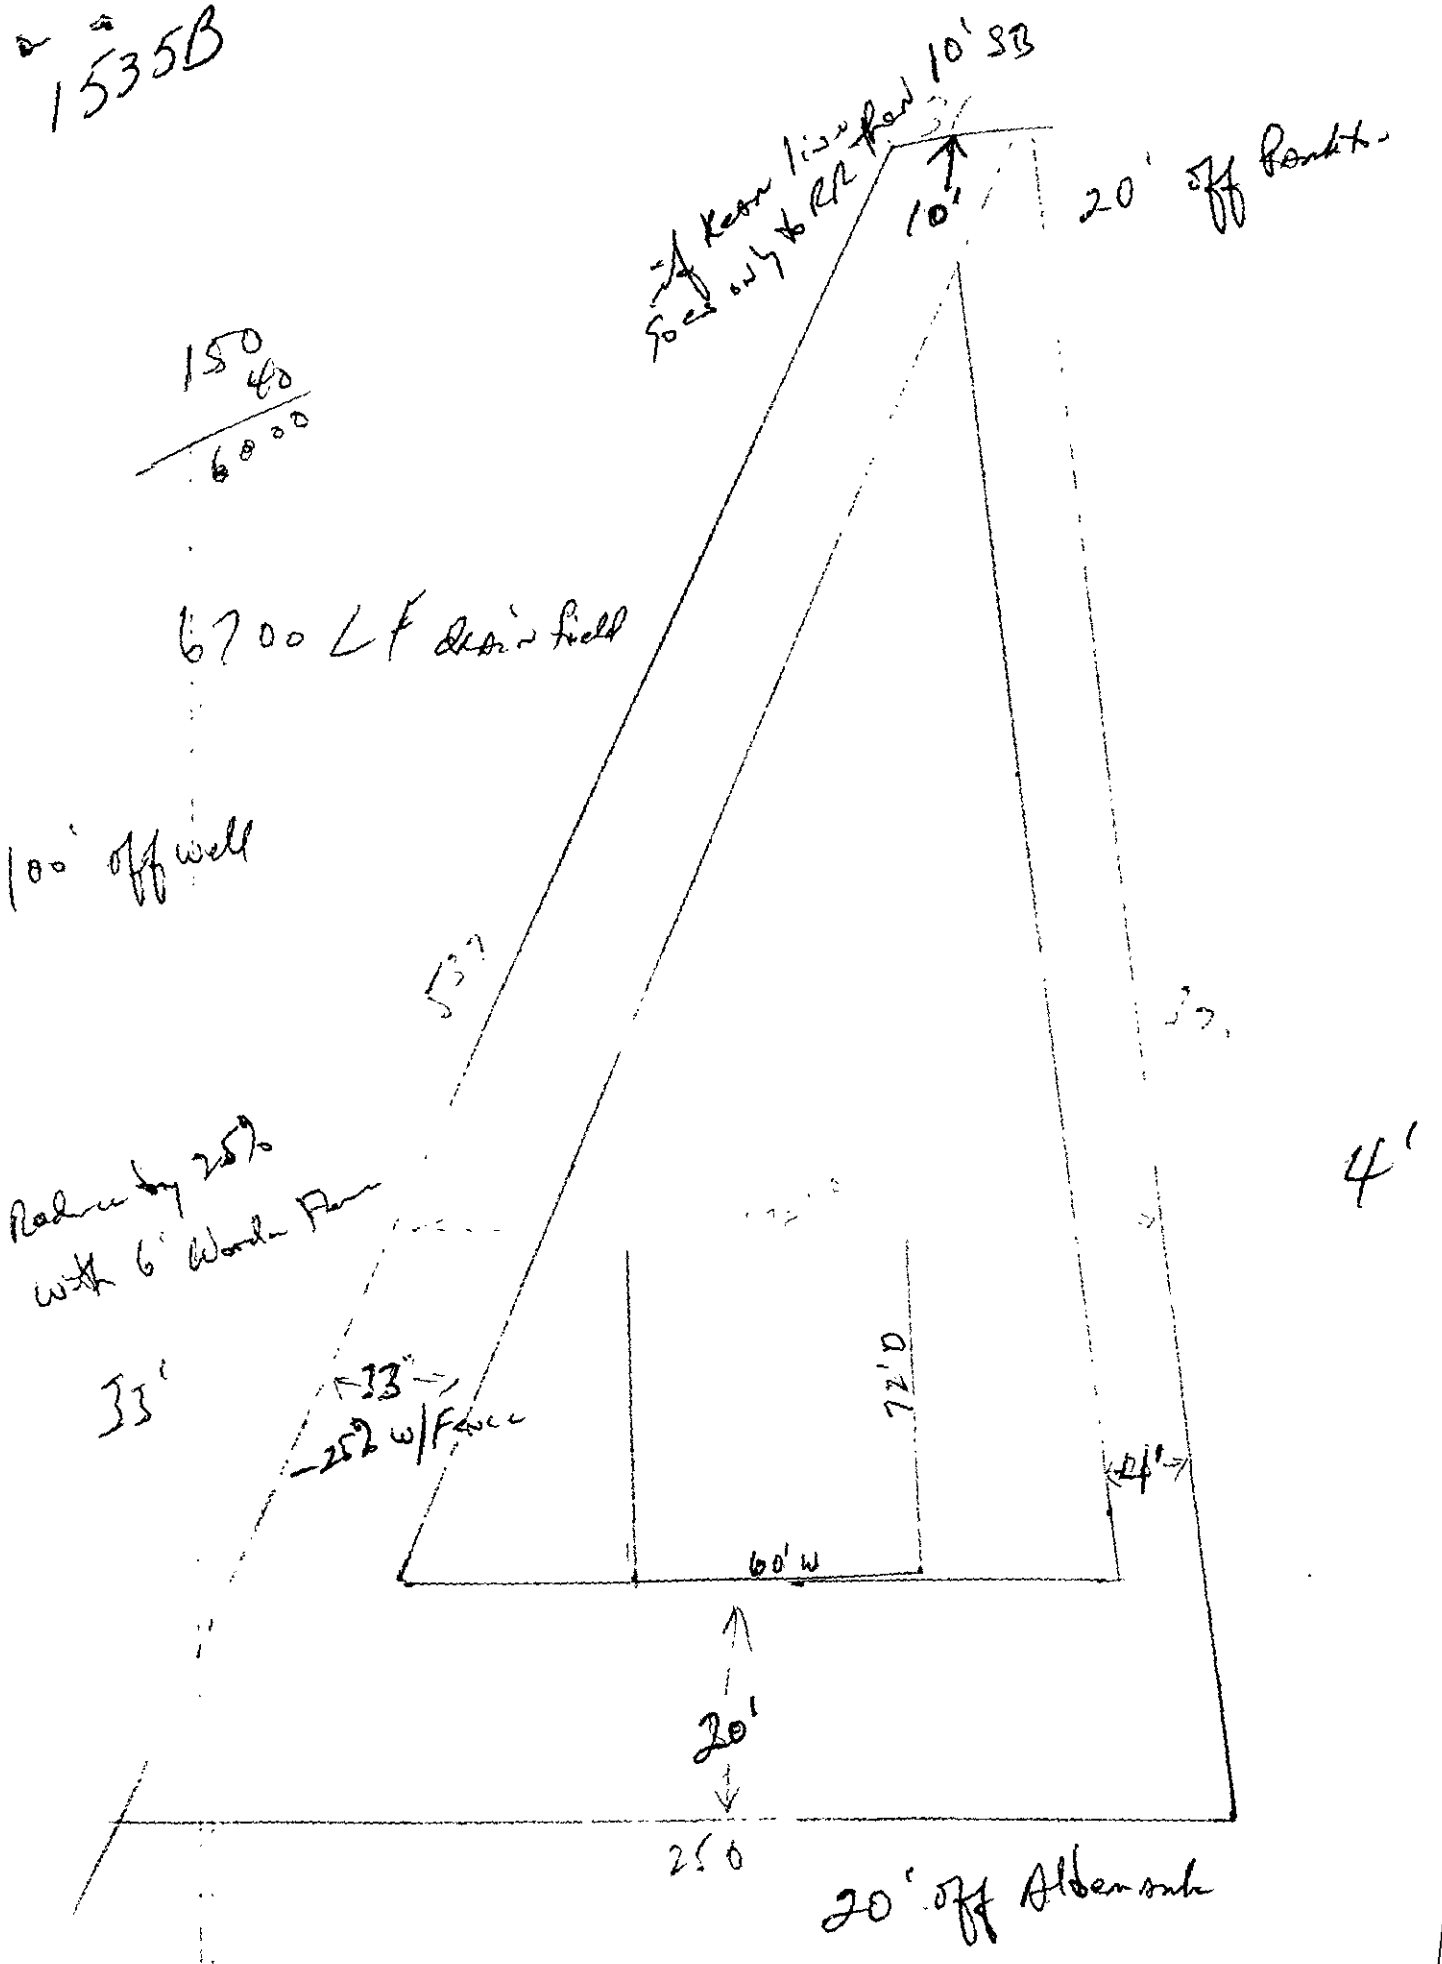
10' SB
20' off Rondt.
10'
150
40
6000
6700 LF drain field
100' off well
Reduce by 25%
with 6' Wood Fence
33'
33'
25' w/ Fence
72'0
24'
60' W
4'
20'
250
20' off Abernathy

1535B


Surveyed By: Ben M. Flowe & Son;
11316 Brief Road
Charlotte, N.C.
28227
(704) 545-3060

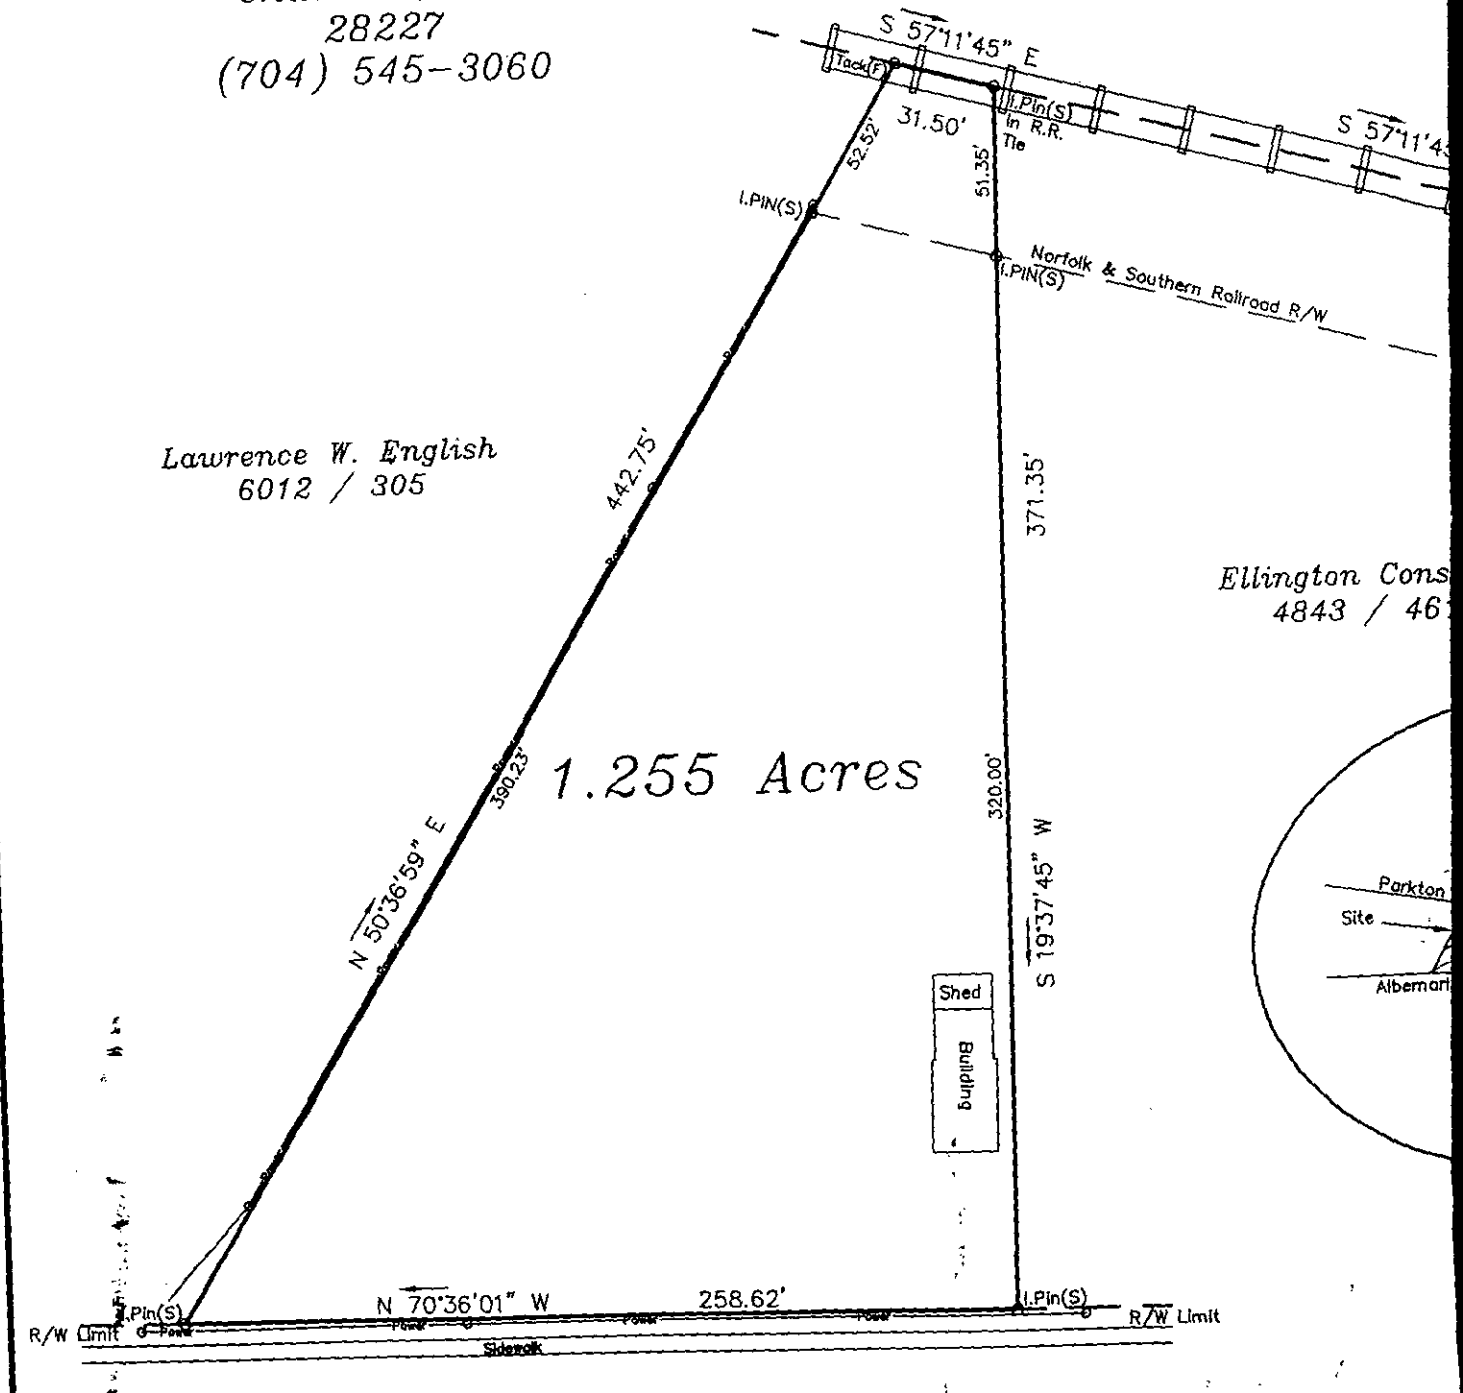



N.C. Hwy # 27
(Albemarle Road)

SUBJECT PROPERTY IS
AREA AS DETERMINED B

NOTE:
THIS PLAT IS OF A SURVEY OF

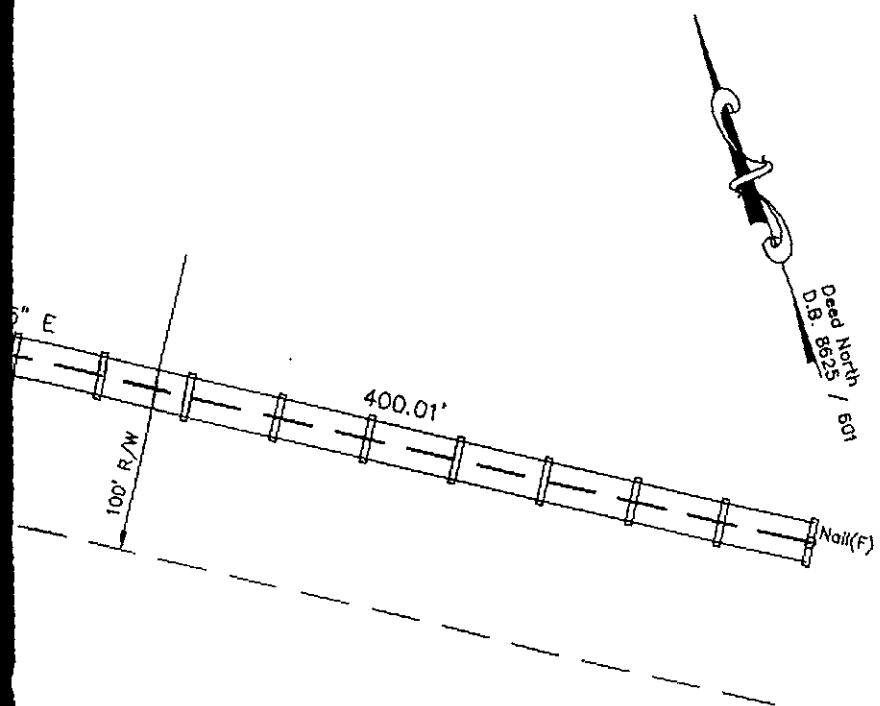


Co.

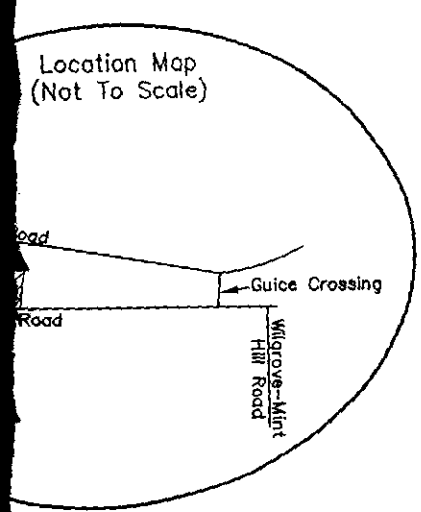


NORTH CAROLINA
REGISTERED
SEAL
L-3600
LAND SURVEYOR
GREGORY S. FLOWE

7/10/96

Tax Parcel: 111-163-06

E.C. = 1' : 10,000' +

Deed Ref: 8625 / 601, 6216 / 578

Property Survey
For
Fred John Kanos,
John F. Kanos and
Effie P. Kanos

Charlotte, N.C.
Mecklenburg County

NOT LOCATED IN A SPECIAL FLOOD HAZARD
Y FLOOD INSURANCE RATE MAP.

AN EXISTING PARCEL or PARCELS OF LAND.

Drawing No. 96399

Scale: 1" = 60'

June 27, 1996