#12542

SUPERVISOR/ADMINISTRATIVE PROFESSIONAL CHECKLIST

NEW SEPTIC ☑ NEW WELL ☐ USE EXISTING ☐ MODIFIED PLOT PLAN ☐

New Septic Fees Paid

IP ($250.00) LP/10.05.21 Initial/Date

CA ($200.00) _____Initial/Date

OP ($200.00) _____Initial/Date

(CA and OP fees need to be paid before a building permit can be issued)

New Well Fees Paid: $550.00 _____ Initial/Date

Use Existing Fees Paid: $100.00 _____Initial/Date

Alteration Fees Paid: $300 Total $200 _____Initial/Date (If use existing was part of payment)

Modified Plot Plan Fees Paid: $100.00 _____Initial/Date

Floor plans need to be submitted and reviewed before CA can be issued ☐ Review ☐

This site is served by septic and well. Verify each is complete before final hold is released ☐

Septic file complete ☐_____ Well complete ☐ _____

Send permit for signature ☐ Signature received ☐ _____

This septic system requires a certified operation contract before final hold is released ☐

Certified operator contract is on file ☐ _____

MECKLENBURG COUNTY
HEALTH DEPARTMENT 11160 P

5 OCT '21 AM 11:17

APPLICATION FOR A RESIDENTIAL SITE IMPROVEMENT PERMIT/ CONSTRUCTION AUTHORIZATION FOR AN ON-SITE WASTEWATER SYSTEM, NEW WELL INSTALLATION, OR REPAIR OF EXISTING WELL

1. SEPTIC / TYPE APPLICATION: ○ N/A ● NEW SYSTEM ○ ALTERATION ○ REPAIR ○ MODIFIED PLOT PLAN

2. WELL / TYPE APPLICATION: ● N/A ○ NEW WELL ○ MAJOR REPAIR ○ ABANDONMENT

3. JOB LOCATION INFORMATION:
TAX PARCEL NUMBER: 01304228
STREET ADDRESS: 12700 Allison Ferry Rd
CITY: Huntersville
STATE: NC ZIP: 28078
SUBDIVISION NAME: _____
LOT #: _____ LOT SIZE (acres): _____
TOWNSHIP:
○ MECKLENBURG ○ CORNELIUS ● HUNTERSVILLE
○ DAVIDSON ○ CHARLOTTE ○ PINEVILLE
○ MATTHEWS ○ MINT HILL

4. BUILDING INFORMATION:
BUILDING TYPE:
○ SINGLE MOBILE HOME ○ MODULAR HOME
○ DOUBLE WIDE ○ MULTIPLE FAMILY
● HOUSE ○ OTHER _____
HEATED SQUARE FOOTAGE: 1700
NUMBER OF BEDROOMS: 2
NUMBER OF OCCUPANTS: 4
FOUNDATION TYPE:
○ CONCRETE SLAB ○ BASEMENT WITH PLUMBING
● CRAWL SPACE ○ BASEMENT WITH NO PLUMBING

5. IF PLANNING TO EXPAND OR ALTER THE EXISTING SEPTIC SYSTEM PLEASE COMPLETE THE FOLLOWING SECTION: ☑ N/A
NUMBER OF BEDROOMS TO BE ADDED: _____ NUMBER OF ADDITIONAL OCCUPANTS IN THE RESIDENCE: _____

6. WATER SUPPLY: ○ MUNICIPAL ● PRIVATE WELL ○ PUBLIC WELL ○ SHARED WELL ○ OTHER _____

7. PROPOSED USE OF WELL: ○ N/A ○ IRRIGATION ○ POTABLE (DRINKING WATER) ○ OTHER _____

8. PLEASE INDICATE AND RANK DESIRED SEPTIC SYSTEM TYPE(S) IN ORDER OF PREFERENCE (1-MOST DESIRED 5-LEAST DESIRED):
☐ N/A ☐ ANY TYPE ☑ 1 CONVENTIONAL ☐ ACCEPTED ☐ INNOVATIVE ☑ 2 ALTERNATIVE ☐ OTHER _____

8A. RANK: ____ ____ ____ ____ ____

9. DO ANY OF THE FOLLOWING APPLY TO THE PROPERTY IN QUESTION? IF "YES" PLEASE ATTACH SUPPORTING DOCUMENTATION.

BURIED CABLES, LANDFILLS, STUMPHOLES	○ YES ● NO	GRADING/SOIL REMOVAL PERFORMED	○ YES ● NO
EXISTING WASTEWATER (SEPTIC) SYSTEMS	○ YES ● NO	JURISDICTIONAL WETLANDS	○ YES ● NO
WELLS, SPRINGS, OR WATER LINES	○ YES ● NO	APPROVAL REQUIRED BY ANY OTHER PUBLIC AGENCY	○ YES ● NO
EASEMENTS OR RIGHT-OF-WAYS	○ YES ● NO	WASTEWATER OTHER THAN DOMESTIC SEWAGE	○ YES ● NO
CHEMICAL/PETROLEUM STORAGE TANKS	○ YES ● NO	KNOWN UNDERGROUND CONTAMINATION	○ YES ● NO
WASTE STORAGE	○ YES ● NO	GROUNDWATER USE RESTRICTIONS/VARIANCES	○ YES ● NO

10. WHAT DATE WAS THE PROPERTY ORIGINALLY DEEDED AND RECORDED? 5/28/21 ☐ UNKNOWN

11. WHAT IS THE ANTICIPATED CLOSING DATE FOR THIS PROPERTY? _____ ☐ N/A

12. PROPERTY OWNER:
NAME: Dustin Foster
ADDRESS: 12720 Allison Ferry Rd
CITY: Huntersville
STATE: NC ZIP: 28078
WORK PHONE: _____
MOBILE PHONE: 610-715-9501
FAX: _____
E-MAIL: Dustin.foster@hotmail.com

13. OWNER'S LEGAL REPRESENTATIVE, IF APPLICABLE:
NAME: Brent Wood
ADDRESS: 345 Jericho Rd
CITY: Harmony
STATE: NC ZIP: 28634
WORK PHONE: _____
MOBILE PHONE: 704-999-5179
FAX: _____
E-MAIL: hod724@gmail.com
hod724@gmail.com

MECKLENBURG COUNTY – GROUNDWATER & WASTEWATER SERVICES
700 N. TRYON ST. SUITE 211 CHARLOTTE, NC 28202, OFFICE: 980-314-1680, FAX: 704-336-8894
Email: Wellreg@MecklenburgCountyNC.gov

Revised on: 4/20/17

14. SEPTIC SYSTEM PERMIT APPLICATION:

If the information in this application is falsified, changed, or the site is altered, then the Improvement Permit and Authorization to Construct shall become invalid. I have read this application and certify that the information provided herein is true, complete and correct. Authorized county and state officials are granted right of entry to conduct necessary inspections to determine compliance with applicable laws and rules. I understand that I am solely responsible for the proper identification and labeling of all property lines and corners and making the site accessible so that a complete site evaluation can be performed. The permit is valid for either sixty (60) months or is non-expiring depending upon the documentation submitted: complete site plan = 60 months, complete plat = non-expiring.

BW (initial here for septic system applications)

15. WELL PERMIT APPLICATION:

If the information in this application is falsified, changed, or the site is altered, then the Well Permit shall become invalid. I have read this application and certify that the information provided herein is true, complete and correct. Authorized county and state officials are granted right of entry to conduct necessary inspections to determine compliance with applicable laws and rules. I understand that I am solely responsible for the proper identification and labeling of all property lines and corners and making the site accessible so that a complete site evaluation can be performed. The permit is valid for a period of twelve (12) months from the date of issuance.

BW (initial here for well applications)

16. APPLICATION SIGNATURE SECTION:

ONLY COMPLETE APPLICATIONS WILL BE PROCESSED. A proper signature is required in order to process your application. Please review the application carefully and sign in the space provided below. A PROPOSED PLOT PLAN is required to be submitted with each application.

B Wall
Property Owner's or Owner's Legal Representative Signature

10/14/21
Date

OFFICE USE ONLY

○ SURVEY PLAT TO SCALE SUBMITTED ○ SCALED SITE PLAN SUBMITTED ○ UN-SCALED SITE PLAN SUBMITTED

SEPTIC APPLICATION FEE RECEIVED: $ _____ DATE FEE RECEIVED: _____

WELL APPLICATION FEE RECEIVED: $ _____ DATE FEE RECEIVED: _____

APPLICATION PROCESSED BY: _____

GWS FILE NUMBER ASSIGNED: _____

APPLICATION ID NUMBER ASSIGNED: _____

COMMENTS:

MECKLENBURG COUNTY – GROUNDWATER & WASTEWATER SERVICES
700 N. TRYON ST. SUITE 211 CHARLOTTE, NC 28202. OFFICE: 980-314-1680, FAX: 704-336-6894
Email: Wellrog@MecklenburgCountyNC.gov

Revised on: 4/20/17

File #: _____

PROPOSED PLOT PLAN


A drawing showing the locations of the following items is required: existing and proposed property lines with dimensions, easements or right-of-ways, proposed building pad(s) or existing building footprint(s), all appurtenances (garage, driveway; deck, pool, etc.), location of existing or proposed well(s), location of existing or proposed sewer lines and sewage disposal systems, surface water bodies, and any aboveground or underground storage tanks. Provide names for all roads that adjoin the property.

Street Address: 12700 Allison Ferry Rd

Tax Parcel #: _____

Subdivision Name: _____

Lot #: _____

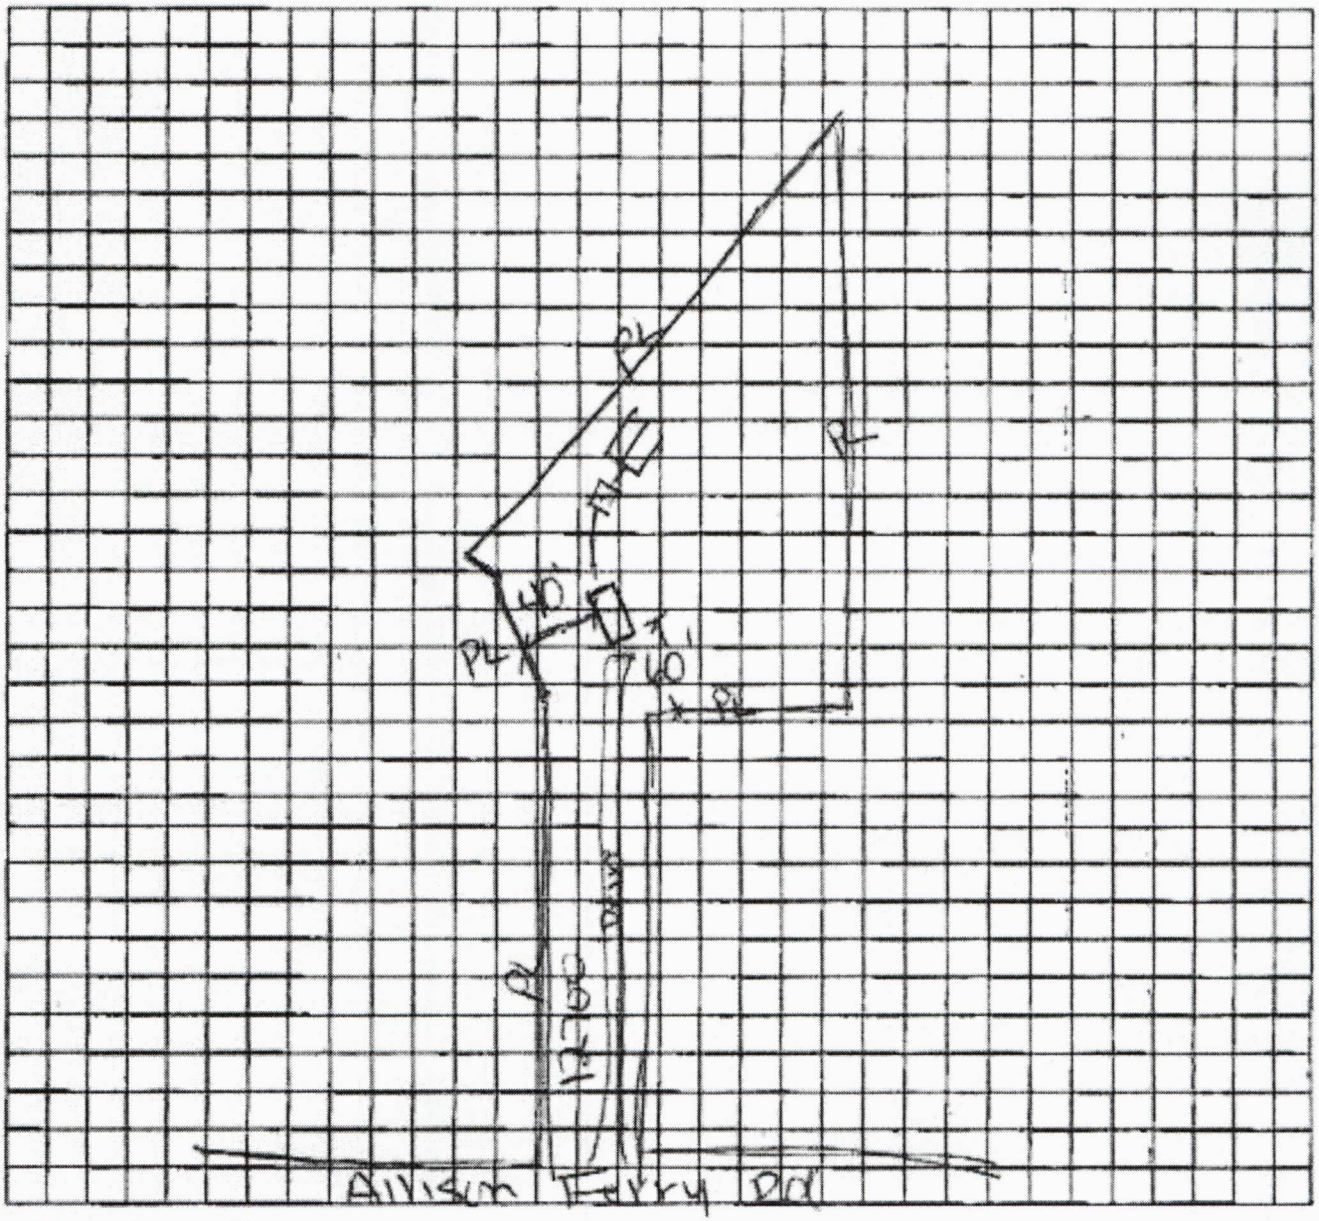

B Ward

Property Owner's or Owner's Legal Representative Signature

12/14/21

Date

MECKLENBURG COUNTY
Health Department

Gibbie Harris, MSPH, BSN
Director

(980) 314-9020

Addendum to Application for
New Well or Septic System Installation
Abandonment or Repair of Existing Well or Septic System

Your signature below confirms the following:

1. The information on the application is true, complete and accurate.
2. Authorized county and state officials are granted right of entry to conduct necessary inspections to determine compliances with applicable laws and rules.
3. I acknowledge that Burt Ward is acting as my legal representative (agent) in the submittal of the application for a water supply well or septic permit located at

12700 Allison Ferry Rd. Huntersville
Number Street Town
(Or Parcel Number)

Danielle V Foster
Property Owner (print name)

Danielle V Foster
Property Owner (signature)

June 28, 2020
Date

MECKLENBURG COUNTY
LAND USE AND ENVIRONMENTAL SERVICES
Payment Receipt

Receipt Information

Date: 10/05/21
Receipt #: 130950
Check / Auth #: DISCOVER 0
Received By: PLACILJ

Amount: 250.00
Tendered: 250.00
Returned: 0.00

Account Information

Account #: 200000
Contractor: BURT WARD
Attn:
Address: 345 JERICHO RD
Address:
City/State/Zip: HARMONY, NC 28634

Item	Description	Permit#	Quantity	Unit Price	Total Price
0701	Improvment Permit App-Residen 12700 ALLISON FERRY		1	250.00	250.00

----------Outstanding Balances----------

Month-To-Date	Prior Month	30 Days	60 Days	90 Days	Balance

Department of Environment, Health, and Natural Resources
Division of Environmental Health
On-site Wastewater Section

Sheet: 1 of 2
Property ID: 013-042-28
Lot #: NA
File #: 11160B
AppID: 12542

SOIL/SITE EVALUATION
for ON-SITE WASTEWATER SYSTEM

Property Owner: Justin Foster
Address: 12720 Allison Ferry Rd, Huntersville, NC 28078
Proposed Facility: 2 Bedroom House
Design Flow (.1949): 240 GPD
Location: 12700 Allison Ferry Rd, Huntersville, NC 28078
Water Supply: [ ] Public [X] Individual [X] Well [ ] Spring [ ] Municipal
Evaluation Method: [X] Auger Boring [ ] Pit [ ] Cut
Type of Wastewater: [X] Sewage [ ] Industrial Process [ ] Mixed

Applicant: Burt Ward
Date Evaluated: 10/13/2021
Property Size: 3.459 ac
Property Recorded: 5/28/2021

PROFILE #	.1940 Landscape Position/ Slope%	Horizon Depth (IN.)	SOIL MORPHOLOGY .1941 .1941 Structure/ Texture	.1941 Consistence Mineralogy	b PROFILE FACTORS .1942 Soil Wetness/ Color	.1943 Soil Depth (IN.)	.1956 Sapro Class	.1944 Restr Horiz	General Comments	Profile Class & LTAR	Maximum Trench Bottom Depth for 3' Wide Conventional Trench
Boring #1	LS 5%	0 - 5	sbk CL	SS SP FR SEXP	>48"	48	NA	NA		0.3	34"
		5 - 48	sbk C	S P FI SEXP							
Boring #2	LS 5%	0 - 9	sbk CL	SS SP FR SEXP	>48"	48	NA	NA		0.3	34"
		9 - 48	sbk C	S P FI SEXP							
Boring #3	LS 5%	0 - 6	sbk CL	SS SP FR SEXP	>48"	48	NA	NA		0.3	34"
		6 - 40	sbk C	S P FI SEXP							
		40 - 48	sbk CL	SS SP FR SEXP							
Boring #4	LS 6%	0 - 5	sbk CL	SS SP FR SEXP	>48"	48	NA	NA		0.3	34"
		5 - 35	sbk C	S P FI SEXP							
		35 - 48	sbk CL	SS SP FR SEXP							

Description	Initial System	Repair System
Available Space (.1945)	PS	PS
System Type(s)	III	III
Site LTAR (gpd/sq ft)	0.3	0.3

Other Factors (.1946): NA
Soil Evaluation By: Jacob Presley, REHS, LSS
Others Present:
Site Classification (.1948):
Site Evaluation By:
Others Present:


COMMENTS:

Landscape Position	Group	Texture	.1955 LTAR	Structure
R-Ridge	I	S-Sand	1.2 - 0.8	sg-Single Grain
SS-Shoulder Slope		LS-Loamy Sand		mass-Massive
LS-Linear Slope				cr-Crumb
FS-Foot Slope	II	SL-Sandy Loam	0.8 - 0.6	gr-Granular
NS-Nose Slope		L-Loam		sbk-Subangular Blocky
HS-Head Slope				abk-Angular Blocky
CC-Concave Slope	III	Si-Silt	0.6 - 0.3	pl-Platy
		SiCL-Silty Clay Loam		pr-Prismatic
CV-Convex Slope				Sap-Saprolite
T-Terrace				
FP-Flood Plain		CL-Clay Loam		**Structure Prefixes**
D-Drainage Way		SCL-Sandy Clay Loam		w-weak
				m-moderate
				s-strong f-fine
				m-medium
		Silt		c-coarse
	IV	SC-Sandy Clay	0.4 - 0.1	
		SiC-Silty Clay		
		C-Clay		

Consistence Moist	Consistence Wet	Mineralogy
VFR-Very Friable	SS-Slightly Sticky	SEXP-Slightly Expansive
FR-Friable	S-Sticky	EXP-Expansive
FI-Firm	VS-Very Sticky	
VFI-Very Firm	NP-Non-Plastic	**Classification**
EFI-Extremely Firm	SP-Slightly Plastic	US-Unsuitable
	P-Plastic	PS-Provisionally Suitable
	VP-Very Plastic	S-Suitable
		NA-Not Applicable

Soil Boring Location Sketch

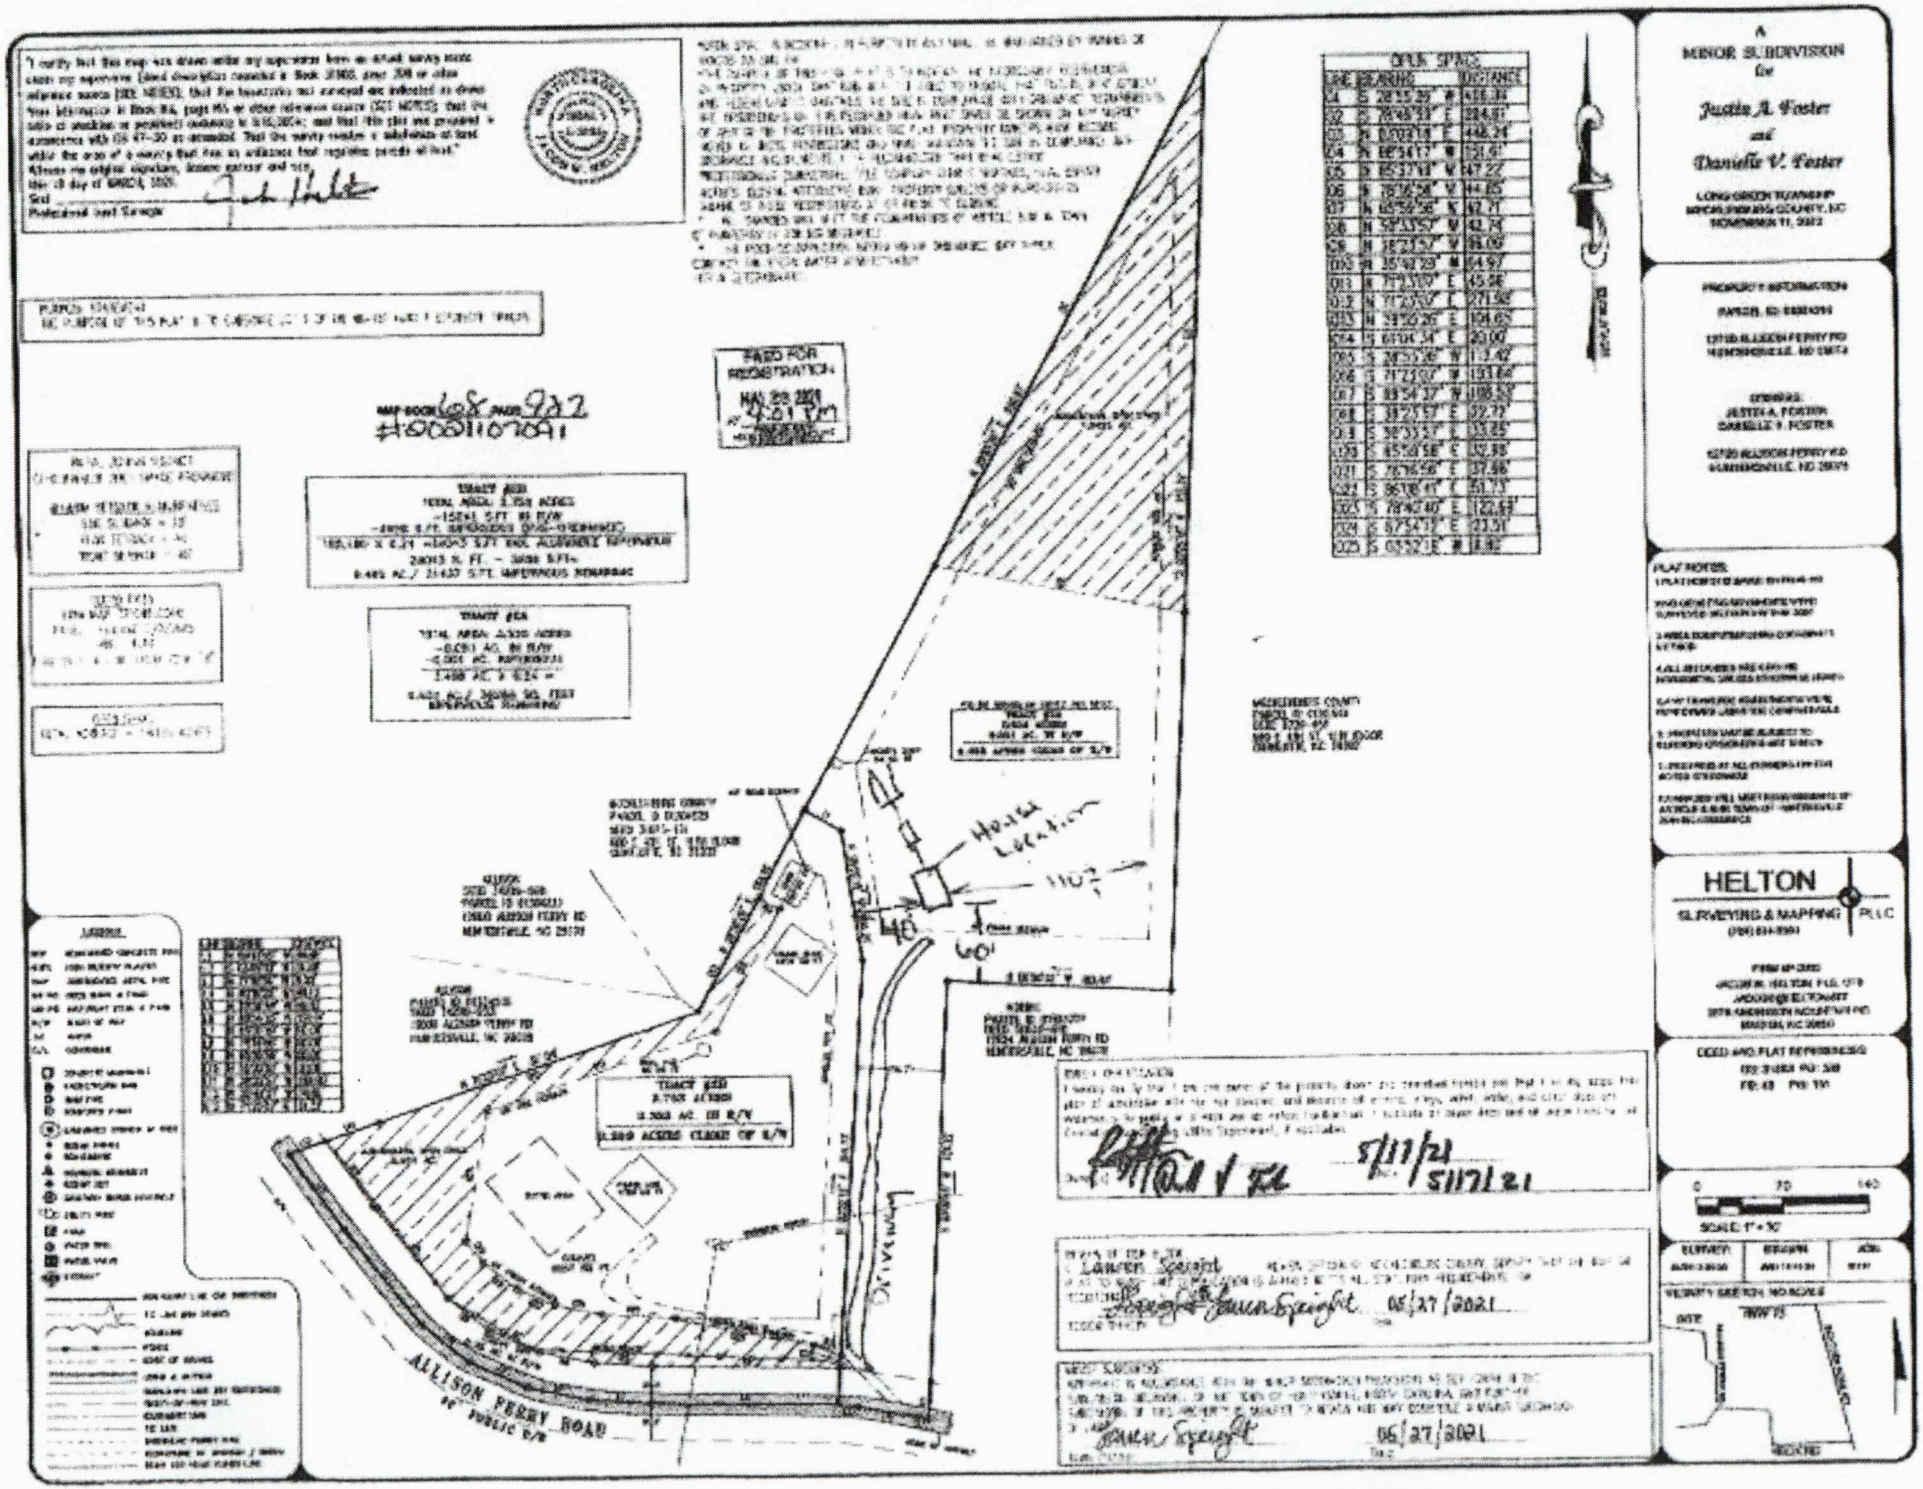


A
MINOR SUBDIVISION
for
Justin A. Foster
and
Danielle V. Foster
PROPERTY INFORMATION
OWNERS:
JUSTIN A. FOSTER
DANIELLE V. FOSTER
PLAT NOTES:
HELTON
SURVEYING & MAPPING PLLC
DEED AND PLAT REFERENCES
SCALE: 1" = 30'
VICINITY SKETCH NO SCALE
DELTA DATA
LINE BEARING DISTANCE
L1 S 28°55'35" W 456.34'
L2 S 26°48'59" E 284.61'
L3 N 0°00'00" E 446.24'
L4 N 88°34'17" W 150.67'
L5 S 85°37'18" W 147.22'
L6 N 16°06'58" W 44.85'
L7 N 68°56'26" W 92.71'
L8 N 59°43'55" W 92.75'
L9 N 16°24'57" W 86.09'
L10 N 35°40'29" W 64.97'
L11 S 77°33'00" E 45.28'
L12 N 11°57'00" E 271.58'
L13 N 39°50'26" E 104.63'
L14 S 61°04'34" E 20.00'
L15 S 28°55'26" W 113.42'
L16 S 71°33'00" W 151.64'
L17 S 89°54'37" W 108.59'
L18 S 38°21'57" E 22.77'
L19 S 16°33'57" E 33.85'
L20 S 45°50'58" E 12.18'
L21 S 76°56'58" E 37.98'
L22 S 86°08'41" E 20.13'
L23 S 78°42'40" E 122.69'
L24 S 67°54'13" E 23.31'
L25 S 63°52'01" W 18.82'
HELTON
SURVEYING & MAPPING PLLC
I hereby certify that the plat shown hereon is correct to the best of my knowledge and belief; that all monuments shown thereon actually exist or are marked as proposed; and that all dimensional and geodetic details are correct.
5/11/21
5/11/21
Lauren Speight 05/27/2021
Lauren Speight 05/27/2021
PLAT #20211107091
MAP BOOK 168 PAGE 922
PLAT #20211107091
House Location
110'±
40'
60'
ALLISON FERRY ROAD
50' PUBLIC R/W

Mecklenburg County Groundwater & Wastewater Services
3205 Freedom Dr., Suite 8000 Charlotte, NC 28208
Phone: (980) 314-1680 Fax: (704) 336-6894

NC DHHS
Division of Environmental Health
On-Site Wastewater Section

IMPROVEMENT PERMIT for a RESIDENTIAL ON-SITE WASTEWATER TREATMENT & DISPOSAL SYSTEM

Permit #: **30012542** GWS File #: **11160B** Tax Parcel #: **013-042-28**

- This IMPROVEMENT PERMIT is subject to revocation if site plans or the intended use change. There is to be **NO** grading, filling, or disturbance of the soil in the area of the septic tank system or repair area.
- CONSTRUCTION AUTHORIZATION must be obtained prior to receiving a Building Permit. Do not clear, grade, fill or disturb soil prior to obtaining a Construction Authorization.
- Domestic-type wastewater only. No industrial process wastewater may be discharged into the system.

I. This Improvement Permit Shall: Expire in Five (5) Years **Expiration Date (If Applicable):** 10/21/2026

Type of Installation: Residential - New System Lot Number: 0

Structure Type: HOUSE Size (ft^2): 1700 # Bedrooms: 2 Max. Occup.: 4

Building Foundation: Crawl Space Water Supply: Private Well

II. Initial System Type: Accepted **System Classification:** IIIg

Initial System Specifications:

Design Flow (gpd):	240	LTAR (gpd/ft^2):	0.3	Septic Tank Size (gal):	1000	Pump Tank Size (gal):	N/A
Trench Width (ft):	3	Trench Spacing (ft):	9	Absorption Area (ft^2):	600	Total Trench Length (ft):	200
Maximum Trench Depth (in):	34	Depth of Media (in):	12	Distribution Device:	Drop Boxes		

III. Repair System Type: Accepted **System Classification:** IIIg

Repair System Specifications:

Design Flow (gpd):	240	LTAR (gpd/ft^2):	0.3	Septic Tank Size (gal):	1000	Pump Tank Size (gal):	N/A
Trench Width (ft):	3	Trench Spacing (ft):	9	Absorption Area (ft^2):	600	Total Trench Length (ft):	200
Maximum Trench Depth (in):	34	Depth of Media (in):	12	Distribution Device:	Drop Boxes		

IV. Permit Conditions/Comments:

(Please See the Following Page for Permit Conditions.)

The undersigned, an authorized agent of the STATE OF NORTH CAROLINA, certifies that the Department is issuing an IMPROVEMENT PERMIT for the above referenced property. This permit is being issued in accordance with the *Laws and Rules For Sewage Treatment, and Disposal Systems* and is subject to the following provisions:

- No work shall be conducted on the septic system until a Pre-Construction meeting has been completed by the Department.
- The septic system installer shall be a licensed septic contractor with the North Carolina Wastewater Contractor Inspector Certification Board.
- The permitted system shall be installed in accordance with the included PLOT PLAN.
- This IMPROVEMENT PERMIT is transferable.

Authorized Agent: Heather Ray

Signature: Heather Ray

Date Issued: 10/21/2021

Owner/Legal Agent: _____
Print Name

Signature: _____

Mecklenburg County Groundwater & Wastewater Services
3205 Freedom Dr., Suite 8000 Charlotte, NC 28208
Phone: (980) 314-1680 Fax: (704) 336-6894

NC DHHS
Division of Environmental Health
On-Site Wastewater Section

IMPROVEMENT PERMIT for a RESIDENTIAL ON-SITE WASTEWATER TREATMENT & DISPOSAL SYSTEM

Permit #: **30012542** GWS File #: **11160B**

IV. Permit Conditions/Comments:

- All components of the septic system must be located at least 100 ft. (50 ft. minimum) from all private wells.
- Flow from all gutters and downspouts shall be directed not to discharge water onto or across any part of the septic system.
- Foundation drains shall be constructed not to discharge water onto or across any part of the septic system.

The undersigned, an authorized agent of the STATE OF NORTH CAROLINA, certifies that the Department is issuing an IMPROVEMENT PERMIT for the above referenced property. This permit is being issued in accordance with the *Laws and Rules For Sewage Treatment and Disposal Systems* and is subject to the following provisions:

- No work shall be conducted on the septic system until a Pre-Construction meeting has been completed by the Department.
- The septic system installer shall be a licensed septic contractor with the North Carolina Wastewater Contractor Inspector Certification Board.
- The permitted system shall be installed in accordance with the included PLOT PLAN.
- This IMPROVEMENT PERMIT is transferable.

Authorized Agent: Heather Ray


Signature: Heather Ray

Date Issued: 10/21/2021

Owner/Legal Agent: _____
Print Name

Signature: _____

On-site Wastewater Improvement Permit Diagram

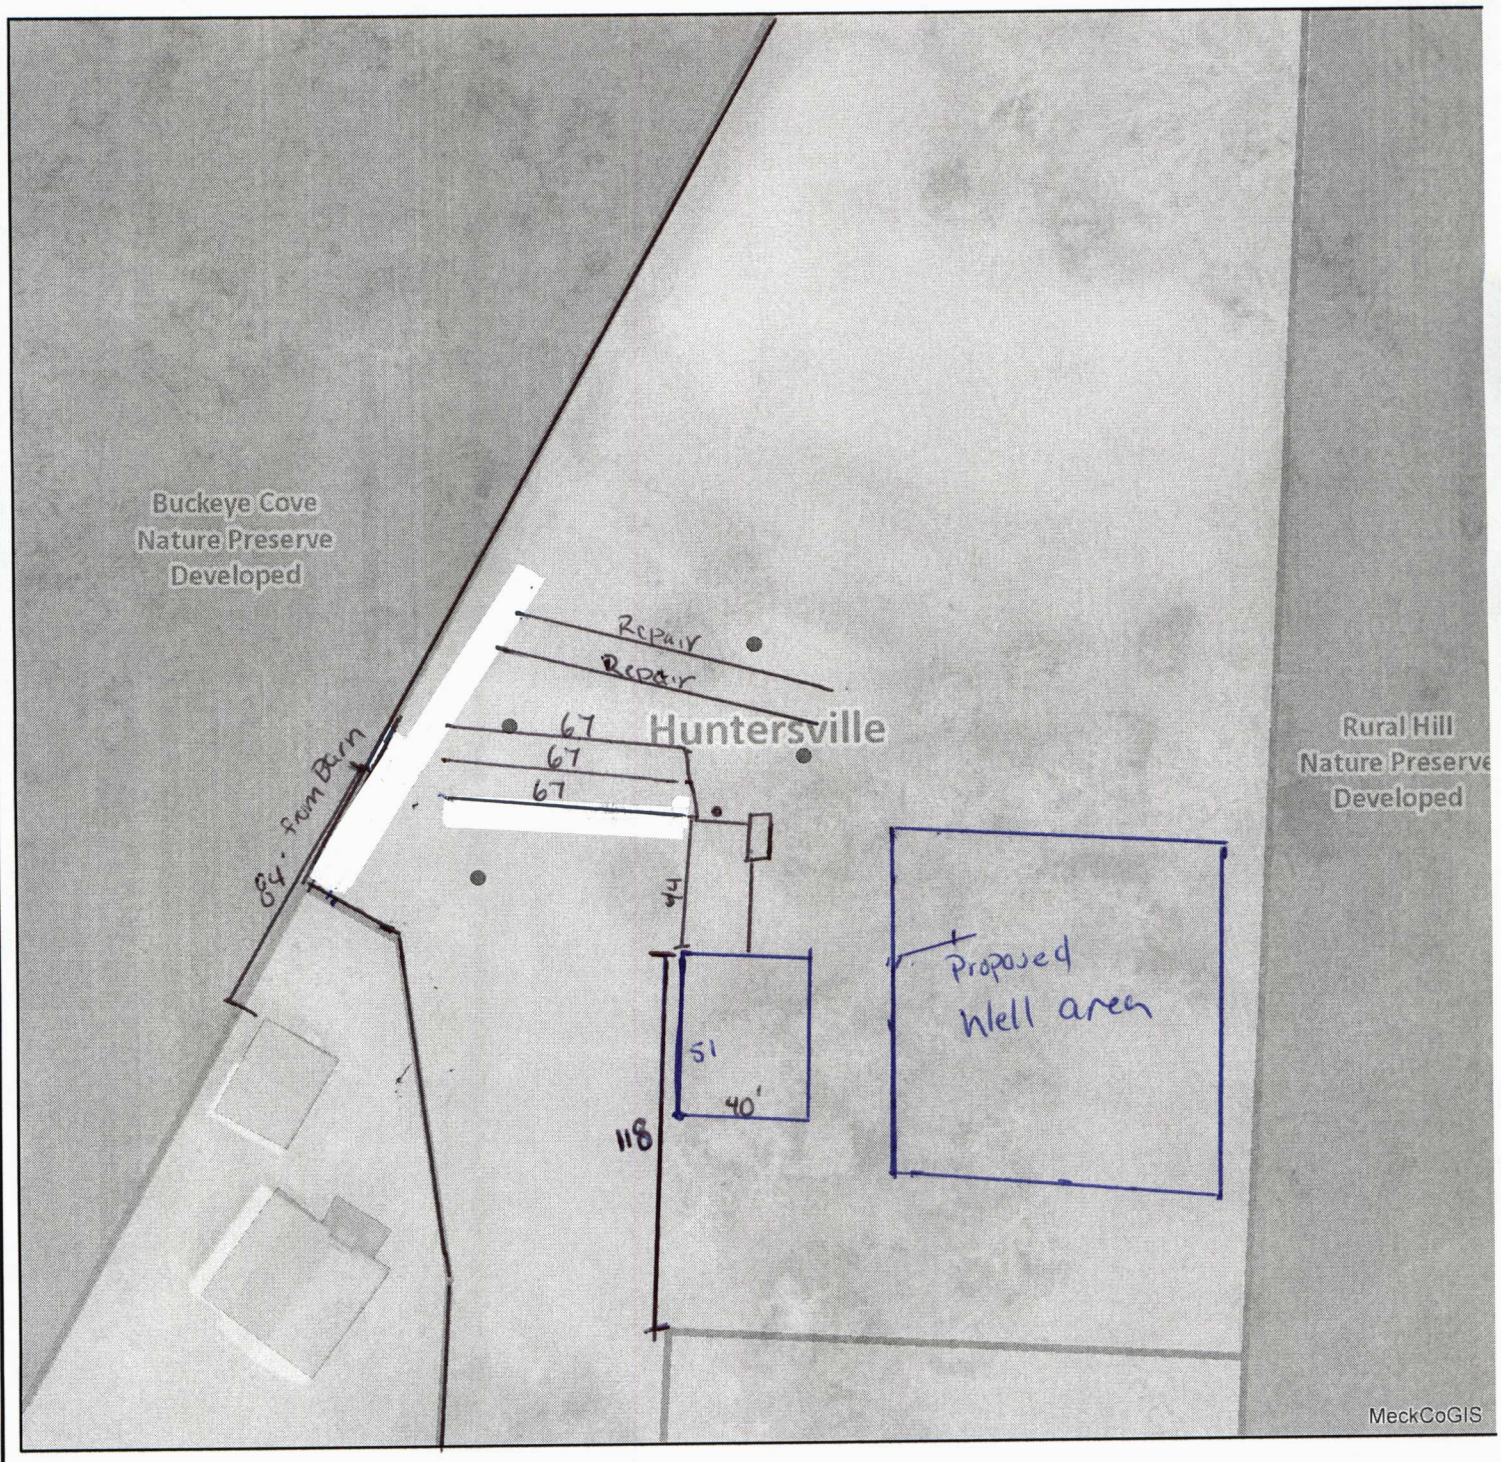

Mecklenburg County Health Department
Environmental Health - Groundwater and Wastewater Services

Permit #: 30012542
PID #: 013-042-28
File #: 111603

Authorized Agent: _____ Date: 10-21-21

Owner/ Legal Agent: _____ Date: _____

1 inch = 60 f

Mecklenburg County Groundwater & Wastewater Services
3205 Freedom Dr. Suite 8000, Charlotte, NC 28208
Phone: (980) 314-1680 Fax: (704) 336-6894

NC DHHS
Division of Environmental Health
On-Site Wastewater Section

OPERATION PERMIT for an ON-SITE WASTEWATER TREATMENT & DISPOSAL SYSTEM

File #: 11160b Permit #: 30012542 Tax Parcel #: 01304228

Property Owner: Justin & Danielle Foster

Job Location Address: 12700 Allison Ferry Rd

City: Huntersville State: NC Zip Code: 28078

Operation Permit Issuance Date: 03/30/2022 Contractor Name: Lentz Septic

Permitted Design Flow: 240 GPD

Liquid Capacity of Septic Tank: 1000 gallons

Liquid Capacity of Dosing Tank: NA gallons

Tank Manufacture Shoaf Effluent Pump Model: NA

Drainfield Installation ☐ N/A

Trench Depth: 30" inches

Trench Width: 3' feet

Line Spacing: 9' feet (O.C.)

Total line length: 200' feet

# of Lines: 3 @ 67 feet

Depth of Media: 12" inches (Type) CHM 36

Depth of Cover: 12"+ inches

Distribution Device: End Cap to End Cap

Bed Installation *(For Repair Installations ONLY.)* ☐ N/A

Bed Depth: _____ inches

Bed Width: _____ feet

Total line length: _____ feet

# of Lines: _____ @ _____ feet

Depth of Media: _____ inches (Type) _____

Depth of Cover: _____ inches

Distribution Device: _____

Water Supply Source

☐ Municipal ☐ Private Well ☐ Community Well

☑ Other Shared Well

System Installation Setbacks

Distance from Building Foundation: 41 feet

Distance from Property Line: 10 feet

Distance from Water Supply Source: 100' feet

Inspection Dates

Tank(s) Inspected: 03/30/2022

Excavation Inspected: 3/30/2022

Pump & Controls Inspected: _____

SKETCH OF SYSTEM INSTALLATION
(As-Built Drawing)



The undersigned has inspected the Septic Tank System described above, and certifies it has been ☐ installed ☐ altered ☐ repaired ☐ as detailed in the plot above ☐ in accordance with the permit issued and meets the provisions of 15A NCAC 18A. 1900, "Laws and Rules for Sewage Treatment and Disposal Systems" in effect on the date of issuance of the permit. The issuance of this Operation Permit does not in any way guarantee that the system will operate properly or relieve any person now or hereafter owning, controlling, or using such system from any liability resulting from the failure of the system to operate properly. This document is issued subject to those restrictions and conditions shown on the permit(s) and the provisions of 15A NCAC 18A. 1900 in addition to those listed below under "Comments." This document shall be null and void if any information contained in the application is untrue or if any additions are made to the property which would increase the requirements for said system.

Notice: Disturbance of the designated repair area may result in the Suspension or Revocation of this permit.

Comments: System Classification & Type: IIIg/CHM36/G/Na/NA

DENR Authorized Agent: Heather Ray Signature: Heather Ray

Mecklenburg County Groundwater & Wastewater Services
3205 Freedom Dr. Suite 8000, Charlotte, NC 28208
Phone: (980) 314-1680 Fax: (704) 336-6894

NC DHHS
Division of Environmental Health
On-Site Wastewater Section

OPERATION PERMIT for an
ON-SITE WASTEWATER TREATMENT & DISPOSAL SYSTEM

File #: 11160b Permit #: 30012542 Tax Parcel #: 01304228

Property Owner: Justin & Danielle Foster

Job Location Address: 12700 Allison Ferry Rd

City: Huntersville State: NC Zip Code: 28078

OPERATION PERMIT CONDITIONS:

I. Performance: System shall perform in accordance with 15A NCAC 18A .1961.

II. Monitoring: System shall be monitored as required by 15A NCAC 18A .1961.

III. Maintenance: Ground absorption sewage treatment and disposal systems shall be checked, and the contents of the septic tank removed, periodically from all compartments, to ensure proper operation of the system. The contents shall be pumped whenever the solids level is found to be more than 1/3 of the liquid depth in any compartment.

IV. Operation: System shall be operated in accordance with 15A NCAC 18A .1961.

System Classification: IIG

*Operation Permits for Type V and VI systems expire five (5) years from the date of issuance (in accordance with Table V(a)). The system owner must contact GWS six (6) months prior to expiration for permit renewal.

Subsurface system operator required: Yes ☐ No ☑

☐ This type of system requires the system owner to maintain a contract with a certified operator to perform system inspection, maintenance, and reporting as required in 15A NCAC 18A .1961. and Table V(a). The system owner is responsible for all fees associated with these services.

☐ System does not require inspection by GWS on a routine frequency.

☐ System requires inspection by GWS once every five (5) years. The system owner is responsible for all fees associated with the inspection.

☐ System requires inspection by GWS once every three (3) years. The system owner is responsible for all fees associated with the inspection.

☐ System requires inspection by GWS once every twelve (12) months. The system owner is responsible for all fees associated with the inspection.

☐ System requires inspection by GWS once every six (6) months. The system owner is responsible for all fees associated with the inspection.

V. Other:

DENR Authorized Agent: Heather Ray Date: 3/30/2022

Signature: Heather Ray