6ws file # 2294

13610

MECKLENBURG COUNTY
HEALTH DEPARTMENT

APPLICATION FOR A RESIDENTIAL SITE IMPROVEMENT PERMIT/ CONSTRUCTION AUTHORIZATION FOR AN ON-SITE WASTEWATER SYSTEM, NEW WELL INSTALLATION, OR REPAIR OF EXISTING WELL

1. SEPTIC / TYPE APPLICATION: ○ N/A ○ NEW SYSTEM ○ ALTERATION ✓ REPAIR ○ MODIFIED PLOT PLAN

2. WELL / TYPE APPLICATION: ○ N/A ○ NEW WELL ○ MAJOR REPAIR ○ ABANDONMENT

3. JOB LOCATION INFORMATION: 165-121-30

TAX PARCEL NUMBER: Wallace LN

STREET ADDRESS: 7635 Wallace LN

CITY: Charlotte NC

STATE: NC **ZIP:** 28212

SUBDIVISION NAME: _____

LOT #: _____ **LOT SIZE (acres):** _____

TOWNSHIP:

✓ MECKLENBURG ○ CORNELIUS ○ HUNTERSVILLE
○ DAVIDSON ○ CHARLOTTE ○ PINEVILLE
○ MATTHEWS ○ MINT HILL

4. BUILDING INFORMATION:

BUILDING TYPE:

○ SINGLE MOBILE HOME ○ MODULAR HOME
○ DOUBLE WIDE ○ MULTIPLE FAMILY
✓ HOUSE ○ OTHER _____

HEATED SQUARE FOOTAGE: 1,724

NUMBER OF BEDROOMS: 3

NUMBER OF OCCUPANTS: 1

FOUNDATION TYPE:

○ CONCRETE SLAB ○ BASEMENT WITH PLUMBING
✓ CRAWL SPACE ○ BASEMENT WITH NO PLUMBING

5. IF PLANNING TO EXPAND OR ALTER THE EXISTING SEPTIC SYSTEM PLEASE COMPLETE THE FOLLOWING SECTION: ☑ N/A

NUMBER OF BEDROOMS TO BE ADDED: _____ NUMBER OF ADDITIONAL OCCUPANTS IN THE RESIDENCE: _____

6. WATER SUPPLY: ✓ MUNICIPAL ○ PRIVATE WELL ○ PUBLIC WELL ○ SHARED WELL ○ OTHER _____

7. PROPOSED USE OF WELL: ✓ N/A ○ IRRIGATION ○ POTABLE (DRINKING WATER) ○ OTHER _____

8. PLEASE INDICATE AND RANK DESIRED SEPTIC SYSTEM TYPE(S) IN ORDER OF PREFERENCE *(1-MOST DESIRED 5-LEAST DESIRED):*

☐ N/A ☐ ANY TYPE ☑ CONVENTIONAL ☐ ACCEPTED ☐ INNOVATIVE ☐ ALTERNATIVE ☐ OTHER _____

8A. RANK: ____ ____ ____ ____ ____

9. DO ANY OF THE FOLLOWING APPLY TO THE PROPERTY IN QUESTION? IF "YES" PLEASE ATTACH SUPPORTING DOCUMENTATION.

BURIED CABLES, LANDFILLS, STUMPHOLES	○ YES ✓ NO	GRADING/SOIL REMOVAL PERFORMED	○ YES ✓ NO
EXISTING WASTEWATER (SEPTIC) SYSTEMS	○ YES ✓ NO	JURISDICTIONAL WETLANDS	○ YES ✓ NO
WELLS, SPRINGS, OR WATER LINES	○ YES ✓ NO	APPROVAL REQUIRED BY ANY OTHER PUBLIC AGENCY	○ YES ✓ NO
EASEMENTS OR RIGHT-OF-WAYS	○ YES ✓ NO	WASTEWATER OTHER THAN DOMESTIC SEWAGE	○ YES ✓ NO
CHEMICAL/PETROLEUM STORAGE TANKS	○ YES ✓ NO	KNOWN UNDERGROUND CONTAMINATION	○ YES ✓ NO
WASTE STORAGE	○ YES ✓ NO	GROUNDWATER USE RESTRICTIONS/VARIANCES	○ YES ✓ NO

10. WHAT DATE WAS THE PROPERTY ORIGINALLY DEEDED AND RECORDED? _____ ☑ UNKNOWN

11. WHAT IS THE ANTICIPATED CLOSING DATE FOR THIS PROPERTY? _____ ☑ N/A

12. PROPERTY OWNER:

NAME: Laksance Leopard Dd
ADDRESS: 7635 Wallace LN
CITY: Charlotte NC
STATE: NC ZIP: 28212
WORK PHONE: 704-713-0536
MOBILE PHONE: _____
FAX: _____
E-MAIL: _____

13. OWNER'S LEGAL REPRESENTATIVE, IF APPLICABLE:

NAME: _____
ADDRESS: _____
CITY: _____
STATE: _____ ZIP: _____
WORK PHONE: _____
MOBILE PHONE: _____
FAX: _____
E-MAIL: _____

MECKLENBURG COUNTY – GROUNDWATER & WASTEWATER SERVICES
700 N. TRYON ST. SUITE 211 CHARLOTTE, NC 28202, OFFICE: 980-314-1680, FAX: 704-336-6894
Email: Wellreg@MecklenburgCountyNC.gov

Revised on: 4/20/17

14. SEPTIC SYSTEM PERMIT APPLICATION:

If the information in this application is falsified, changed, or the site is altered, then the Improvement Permit and Authorization to Construct shall become invalid. I have read this application and certify that the information provided herein is true, complete and correct. Authorized county and state officials are granted right of entry to conduct necessary inspections to determine compliance with applicable laws and rules. I understand that I am solely responsible for the proper identification and labeling of all property lines and corners and making the site accessible so that a complete site evaluation can be performed. The permit is valid for either sixty (60) months or is non-expiring depending upon the documentation submitted: complete site plan = 60 months, complete plat = non-expiring.

LC (Initial here for septic system applications)

15. WELL PERMIT APPLICATION:

If the information in this application is falsified, changed, or the site is altered, then the Well Permit shall become invalid. I have read this application and certify that the information provided herein is true, complete and correct. Authorized county and state officials are granted right of entry to conduct necessary inspections to determine compliance with applicable laws and rules. I understand that I am solely responsible for the proper identification and labeling of all property lines and corners and making the site accessible so that a complete site evaluation can be performed. The permit is valid for a period of twelve (12) months from the date of issuance.

_____ (Initial here for well applications)

16. APPLICATION SIGNATURE SECTION:

ONLY COMPLETE APPLICATIONS WILL BE PROCESSED. A proper signature is required in order to process your application. Please review the application carefully and sign in the space provided below. A PROPOSED PLOT PLAN is required to be submitted with each application.

Laborence Lockard — 2/1/23

Property Owner's or Owner's Legal Representative Signature — Date

---

OFFICE USE ONLY

○ SURVEY PLAT TO SCALE SUBMITTED ○ SCALED SITE PLAN SUBMITTED ○ UN-SCALED SITE PLAN SUBMITTED

SEPTIC APPLICATION FEE RECEIVED: $ _____ DATE FEE RECEIVED: _____

WELL APPLICATION FEE RECEIVED: $ _____ DATE FEE RECEIVED: _____

APPLICATION PROCESSED BY: _____

GWS FILE NUMBER ASSIGNED: _____

APPLICATION ID NUMBER ASSIGNED: _____

COMMENTS:

MECKLENBURG COUNTY – GROUNDWATER & WASTEWATER SERVICES
700 N. TRYON ST. SUITE 211 CHARLOTTE, NC 28202, OFFICE: 980-314-1680, FAX: 704-336-6894
Email: Wellreg@MecklenburgCountyNC.gov


File #: _____

PROPOSED PLOT PLAN

A drawing showing the locations of the following items is required: existing and proposed property lines with dimensions, easements or right-of-ways, proposed building pad(s) or existing building footprint(s), all appurtenances (garage, driveway, deck, pool, etc.), location of existing or proposed well(s), location of existing or proposed sewer lines and sewage disposal systems, surface water bodies, and any aboveground or underground storage tanks. Provide names for all roads that adjoin the property.

Street Address: _____ Tax Parcel #: _____

Subdivision Name: _____ Lot #: _____

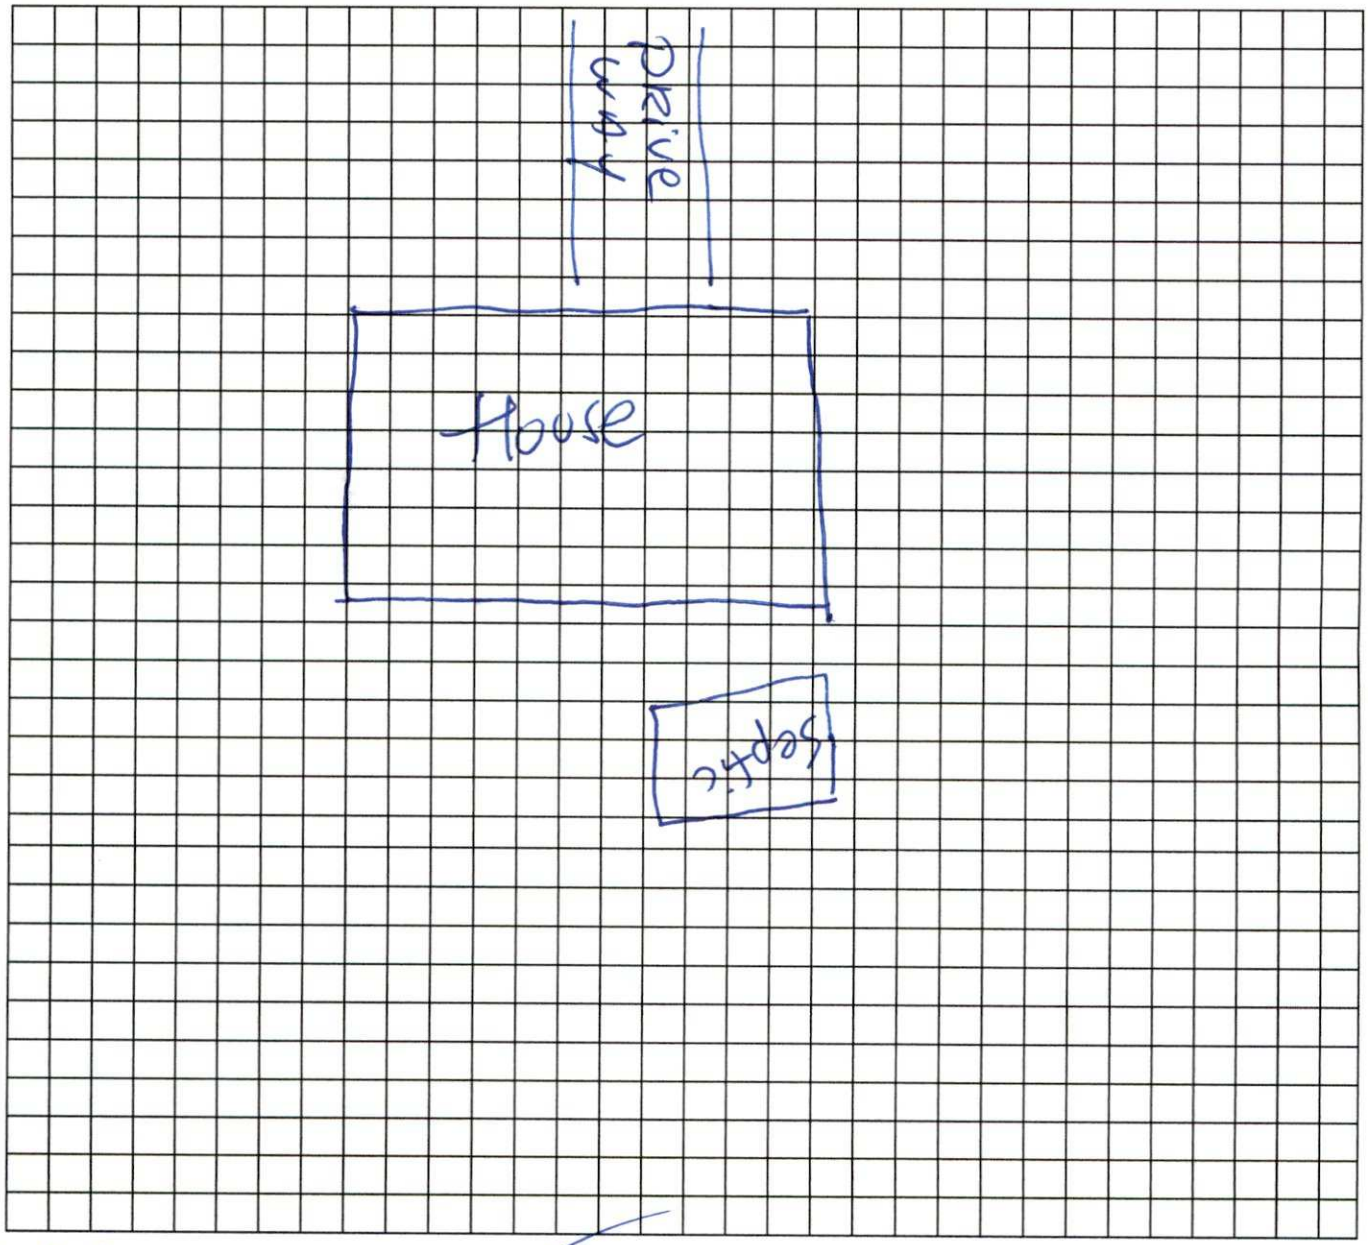

Property Owner's or Owner's Legal Representative Signature

2/11/23
Date

MECKLENBURG COUNTY – GROUNDWATER & WASTEWATER SERVICES
700 N. TRYON ST. SUITE 211 CHARLOTTE, NC 28202, OFFICE: 980-314-1680, FAX: 704-336-6894
Email: Wellreg@MecklenburgCountyNC.gov

Revised on: 4/20/17

CERTIFICATE OF COMPLETION/OPERATION PERMIT

HEALTH DEPARTMENT
ENVIRONMENTAL HEALTH DIVISION
700 NORTH TRYON ST., SUITE 211
CHARLOTTE, NC 28202
PHONE (704) 336-5102

FILE: ZZ94 DATE: ~~5/22/03~~ 5/30/03

TC: 165-121-30 ☒ L ☐ CRT

SERIAL 19207

Name of Owner JOHN LEOPARD Juris.: _____

Address of Property 7635 WALLACE LN.

Inspection Data:

Tank Material PCC/EXISTING BED

Total Length of ~~Drainfield~~ 10'X36'

Number of Lines _____ @ _____

Cover Depth 3'

Water Supply Source MUNICIPAL


Distance to Water Source >50'

Excavation Inspected 5/30/03

Tank(s) Inspected EXISTING

Wash Line Inspected N/A

High Water Alarm Inspected N/A

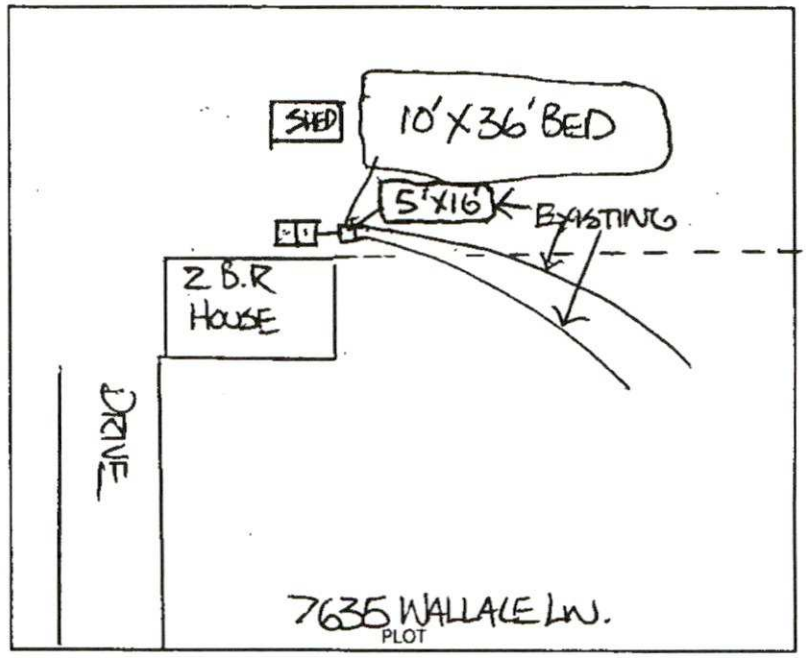

Design 2 EXISTING ST, CON, 360 SFT, B, 24G CTR# AUTRY

The undersigned has inspected the Septic Tank System described above, and certifies it has been

☐ installed or constructed ☒ altered or repaired

☐ in accordance with the permit issued ☐ as detailed in the plot above

and meets the provisions of 15A NCAC 18A. 1900, "Laws And Rules For Sewage Treatment and Disposal Systems" in effect on the date of issuance of the permit. This issuance of this

☐ Certificate of Completion ☒ Operation Permit

does not in any way guarantee that the system will operate properly or relieve any person now or hereafter owning, controlling, or using such system from any liability resulting from the failure of the system to operate properly. This document is issued subject to those restrictions and conditions shown on the permit(s) and the provisions of 15A NCAC 18A. 1990 in addition to those listed below under "COMMENTS." This document shall be null and void if any information contained in the application is untrue or if any additions are made to the property which would increase the requirements for said system.

Notice: Disturbance of the designated repair area may result in the suspension/revocation of this permit.

COMMENTS: REPAIR TO EXISTING SYSTEM, 10'X36' BED, 2' GRAVEL

Environmental Health Specialist

Mecklenburg County services are available without regard to ethnic origin, sex, or disability.

CERTIFICATE OF COMPLETION/OPERATION PERMIT

HEALTH DEPARTMENT
ENVIRONMENTAL HEALTH DIVISION
700 NORTH TRYON ST., SUITE 211
CHARLOTTE, NC 28202
PHONE (704) 336-5102

FILE: 2294 DATE: 5/30/03 ~~5/27/03~~

TC: 165-121-30 ☒ L ☐ CRT

SERIAL 19207

Name of Owner JOHN LEOPARD Juris.:

Address of Property 7635 WALLACE LN.

Inspection Data:

Tank Material PCC/EXISTING BED

Total Length of ~~Drainfield~~ 10'X36'

Number of Lines ____ @ ____

Cover Depth 3'

Water Supply Source MUNICIPAL


Distance to Water Source >50'

Excavation Inspected 5/30/03

Tank(s) Inspected EXISTING

Wash Line Inspected N/A

High Water Alarm Inspected N/A

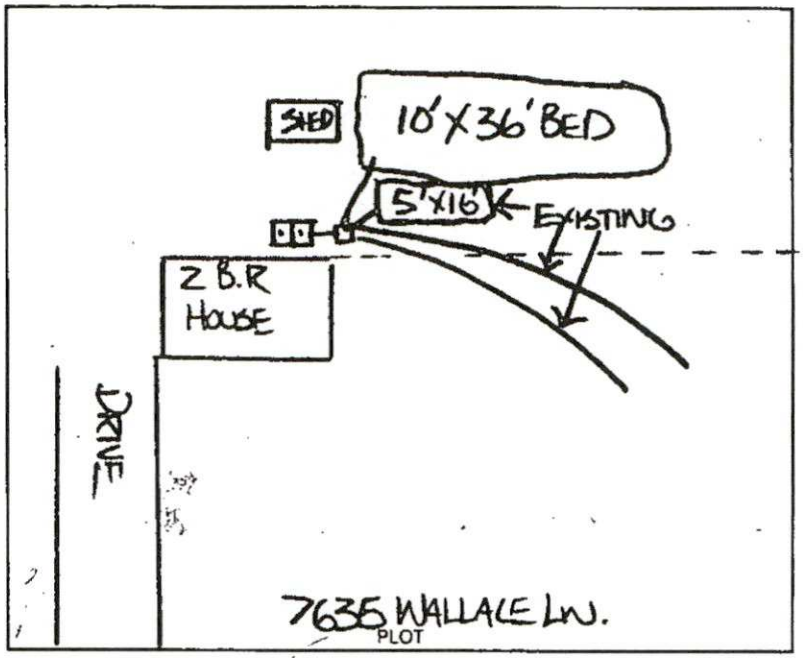

Design #EXISTING ST, CON, 360 SFT, B, 24G CTR# AUTRY

The undersigned has inspected the Septic Tank System described above, and certifies it has been

☐ installed or constructed ☒ altered or repaired

☐ in accordance with the permit issued ☐ as detailed in the plot above

and meets the provisions of I5A NCAC 18A. 1900, "Laws And Rules For Sewage Treatment and Disposal Systems" in effect on the date of issuance of the permit. This issuance of this

☐ Certificate of Completion ☒ Operation Permit

does not in any way guarantee that the system will operate properly or relieve any person now or hereafter owning, controlling, or using such system from any liability resulting from the failure of the system to operate properly. This document is issued subject to those restrictions and conditions shown on the permit(s) and the provisions of I5A NCAC 18A. 1990 in addition to those listed below under "COMMENTS." This document shall be null and void if any information contained in the application is untrue or if any additions are made to the property which would increase the requirements for said system.

Notice: Disturbance of the designated repair area may result in the suspension/revocation of this permit.

COMMENTS: REPAIR TO EXISTING SYSTEM, 10X36' BED, 2' GRAVEL

Environmental Health Specialist

Mecklenburg County services are available without regard to ethnic origin, sex, or disability.

INSTALLATION, CONSTRUCTION, ALTERATION, AND/OR REPAIR APPROVAL


HEALTH DEPARTMENT
ENVIRONMENTAL HEALTH DIVISION
700 NORTH TRYON ST., SUITE 211
CHARLOTTE, NC 28202
PHONE (704) 336-5102

FILE: 2294 DATE: 5/22/03

TC: 165-121-30 L

SERIAL . 19408

Permission is hereby given to _____ Install or Construct, _____ Alter or Repair the individual septic tank wastewater treatment system with subsurface, soil absorption, effluent discharge as specified herein at the described location. This permit is granted based upon the information supplied in the application dated _____. All work shall be completed on or before _____, after which date this permit shall be null and void. The system shall meet all of the construction requirements of I5A NCAC 18A. 1900 which are in effect on the date of the granting of this permit. A Certificate of Completion or an Operation Permit must be obtained from the Mecklenburg County Health Department before any system can be covered up or placed into service. The issuance of this permit does not in any way guarantee that the system anticipated to be constructed will operate properly, or relieve any person now or hereafter owning, controlling or using such system from any liability resulting from the failure of the system to operate properly.

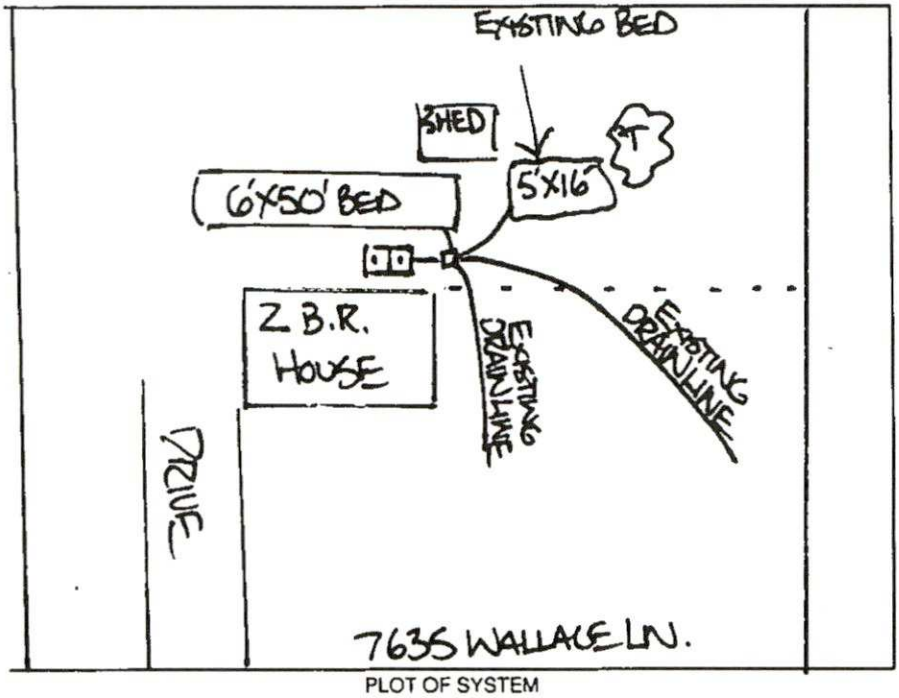

PLOT OF SYSTEM

Liquid Capacity of Septic Tank EXISTING gallons

Liquid Capacity of Dosing Tank N/A gallons

Tank Construction PCC

Trench Depth 3'

Absorption and/or Nitrification Lines:

~~Trench~~ BED Width 6'X50' feet

Trench Walls Scored and Porous Y

Total Line Length 6'X50' BED feet

Number of Lines —

Depth of Stone 24 inches

Distance from House 10 feet

Distance from Property Line 10 feet

Distance from Well 750' feet

NOTICE: This system shall not be installed while soils are in a wet condition.

NAME OF OWNER JOHN LEOPARD

LOCATION OF PROPERTY 7635 WALLACE LN.

Comments: REPAIR, 6'X50' BED, 2FT GRAVEL.

Environmental Health Specialist

INSTALLATION, CONSTRUCTION, ALTERATION, AND/OR REPAIR APPROVAL


HEALTH DEPARTMENT
ENVIRONMENTAL HEALTH DIVISION
700 NORTH TRYON ST., SUITE 211
CHARLOTTE, NC 28202
PHONE (704) 336-5102

FILE: 22914 DATE: 5/22/03

TC: 165-121-30 ☒ L

SERIAL 19408

Permission is hereby given to _____ Install or Construct, _____ Alter or Repair the individual septic tank wastewater treatment system with subsurface, soil absorption, effluent discharge as specified herein at the described location. This permit is granted based upon the information supplied in the application dated _____. All work shall be completed on or before _____, after which date this permit shall be null and void. The system shall meet all of the construction requirements of 15A NCAC 18A. 1900 which are in effect on the date of the granting of this permit. A Certificate of Completion or an Operation Permit must be obtained from the Mecklenburg County Health Department before any system can be covered up or placed into service. The issuance of this permit does not in any way guarantee that the system anticipated to be constructed will operate properly, or relieve any person now or hereafter owning, controlling or using such system from any liability resulting from the failure of the system to operate properly.

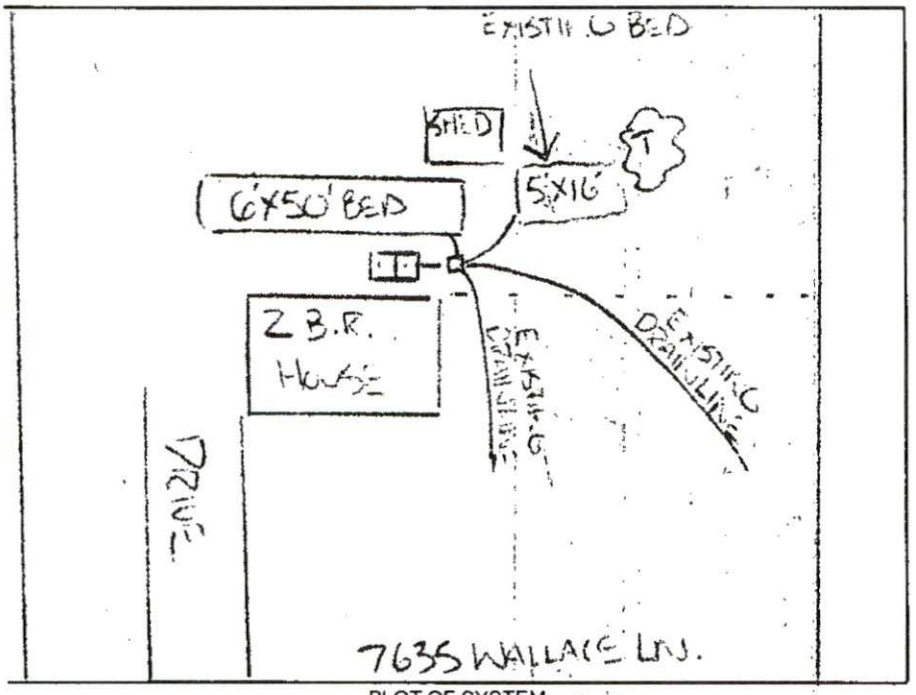

PLOT OF SYSTEM

Liquid Capacity of Septic Tank EXISTING gallons

Liquid Capacity of Dosing Tank N/A gallons

Tank Construction PCC

Trench Depth 3'

Absorption and/or Nitrification Lines:

~~Trench~~ BED Width 6'X50' feet

Trench Walls Scored and Porous Y

Total Line Length 6'X50' BED feet

Number of Lines —

Depth of Stone 24 inches

Distance from House 10 feet

Distance from Property Line 10 feet

Distance from Well 750' feet

NOTICE: This system shall not be installed while soils are in a wet condition.

NAME OF OWNER JOHN LEODARD

LOCATION OF PROPERTY 7635 WALLACE LN.

Comments: REPAIR, 6'X50' BED, 2FT GRAVEL

Environmental Health Specialist

WHITE - HEALTH DEPARTMENT's COPY, • CANARY - E.H.S. COPY • PINK - OWNER OR AGENT's COPY

FEE: 0

DATE: 5/30/03

APPLICATION FOR IMPROVEMENT PERMIT FOR RESIDENTIAL SITE INDIVIDUAL WATER AND WASTEWATER SYSTEMS PROGRAM

[ ] CRT

TYPE APPLICATION: ___ NEW SYSTEM ___ EXPANSION/ ALTERATION OF EXISTING SYSTEM X REPAIR OF EXISTING SYSTEM

NORTH CAROLINA
DEPARTMENT OF ENVIRONMENT,
HEALTH, AND NATURAL RESOURCES
DIVISION OF ENVIRONMENTAL HEALTH
ON-SITE WASTEWATER SECTION

FILE #: 2294

PROPERTY INFORMATION (FROM ENGINEERING FORM) FOR JOB LOCATION:

TAX/PARCEL NUMBER: 166-121-30

STREET ADDRESS: 7635 WALLACE LN

SUBDIVISION OR MOBILE HOME PARK NAME:

LOT NUMBER:

TYPE OF BUILDING (CHECK ONE):

- ___ SINGLE MOBILE HOME(S)
- ___ DOUBLE WIDE (D)
- √ HOUSE (H)
- ___ MODULAR HOME (M)
- ___ MULTIPLE FAMILY (U)
- ___ OTHER (O)

TOWNSHIP (CHECK ONE):

- √ 0 MECKLENBURG
- ___ 1 CHARLOTTE
- ___ 2 DAVIDSON
- ___ 3 CORNELIUS
- ___ 4 PINEVILLE
- ___ 5 MATTHEWS
- ___ 6 HUNTERSVILLE
- ___ 7 MINT HILL

HEATED SQUARE FOOTAGE:

NUMBER OF BEDROOMS: 2

NUMBER OF OCCUPANTS:

CLOSING DATE_____

FOUNDATION FOR RESIDENCE:

- ___ WITHOUT BASEMENT ON SLAB
- √ CRAWL SPACE
- ___ WITH BASEMENT /PLUMBING
- ___ WITH BASEMENT /NO PLUMBING

IF EXPANSION/ALTERATION OF EXISTING SYSTEM, DESCRIBE THE PROPOSED BUILDING ADDITION:

WILL THERE BE A HOME BUSINESS IN THE RESIDENCE: ___ YES √ NO TYPE: _____

WATER SUPPLY (CHECK ONE):

___ COMMUNITY (C) ___ MUNICIPAL (M) ___ PRIVATE WELL (P)
___ SHARED WELL (S) ___ OTHER 'SPRINGS' (O)

IF ANY OF THE FOLLOWING ARE LOCATED ON THE PROPERTY, PLEASE SHOW LOCATION ON PLAT:

BURIED CABLES, LANDFILLS, STUMPHOLES	___ YES ___ NO	WELL, SPRINGS OR WATERLINES	___ YES ___ NO
EXISTING WASTEWATER SYSTEMS	___ YES ___ NO	DESIGNATED WETLANDS	___ YES ___ NO
EASTMENTS OR RIGHT-OF-WAYS	___ YES ___ NO		

PROPERTY OWNER:

NAME: LEOPARD JOHN
(LAST) (FIRST) (MI)

ADDRESS: 7635 WALLACE LN

CITY: CHARLOTTE STATE: NC ZIP:

DAYTIME PHONE: ( ) –

LEGAL AGENT FOR PROPERTY OWNER, IF APPLICABLE:

NAME:
(LAST) (FIRST) (MI)

DAYTIME PHONE: ( ) –

WHAT DATE WAS THE PROPERTY ORIGINALLY DEEDED AND RECORDED? _____

An Improvement Permit is subject to suspension or revocation if site plans or the intended use change or if information submitted in this application is falsified or changed. The undersigned, owner, or legal agent for the owner, of the property described above as the "Job Location" has read the foregoing application, acknowledges that the contents of same are true, and authorizes agents of the Mecklenburg County Health Department to enter onto the property for the purpose of processing this request.

SIGNED: John D. Leopard DATE: 5-30-03

MECKLENBURG COUNTY HEALTH DEPARTMENT
ENVIRONMENTAL HEALTH DIVISION
c/o HAL MARSHALL CTR., SUITE 211, 700 N. TRYON ST., CHARLOTTE, N.C. 28202., (704) 336-5102

VIDUAL WATER AND WASTEWATER SYSTEMS PROGRAM
APPLICATION FOR SERVICES

FC Pd $100 CASH 5/13/03 gd CRT

5/13 gd

Mecklenburg County Health Dept
Environmental Health Division
c/o Hal Marshall Ctr., Suite 211
700 N. Tryon St.
Charlotte, NC 28202

(704)336-5102 2294

Date:

PERSON FILING APPLICATION:

NAME: Leopard (last) John (first) (mi)

ADDRESS: 7635 Wallace Ln PHONE: (704) 532-6143

CITY: Charlotte STATE: N.C. ZIPCODE: 28212

PROPERTY INFORMATION (FROM ENGINEERING FORM):

TAX/PARCEL NUMBER: 165-121-30

STREET ADDRESS: 7635 Wallace LN

ZONING:

PROPERTY OWNER:

NAME: Leopard (last) John (first) (mi)

ADDRESS: 7635 Wallace Ln PHONE: (704) 532-6143

CITY: Charlotte STATE: N.C. ZIPCODE: 28212

SUBDIVISION OR MOBILE HOME PARK NAME:

Township (check one):
[ ] 0 Mecklenburg County [ ] 2 Davidson [ ] 4 Pineville [ ] 6 Huntersville
[X] 1 Charlotte [ ] 3 Cornelius [ ] 5 Matthews [ ] 7 Mint Hill

TYPE APPLICATION (check one):

LOT NUMBER: LOT SIZE (in acres):

[redacted] 1962

[ ] EXCHANGE MOBILE HOME - SAME # BEDROOMS (Y)
[ ] ADDITION - INCREASE ROOMS/OCCUPANCY/MOBILE HOME SIZE (A or M)
[ ] COMMERCIAL OR INDUSTRIAL (N)

[ ] ADDITION - GARAGE OR RENOVATION/NO MAJOR CHANGES (X)
Add one bath
[redacted]

RESIDENTIAL PROPERTY (Type Building, check one):
[ ] SINGLE MOBILE HOME (S) [X] HOUSE (H) [ ] MULTIPLE FAMILY (U)
[ ] DOUBLE WIDE (D) [ ] MODULAR HOME (M) [ ] OTHER _____ (O)

NUMBER BEDROOMS: 3 NUMBER OCCUPANTS: 2

SYSTEM CLASSIFICATION:

COMMERCIAL/INDUSTRIAL PROPERTY:
Type Business _____ # Employees ___ Per Shift ___ ___ ___
Industrial Wastes (Y/N) ___
Underground Storage Tanks On Property (Y/N) ___ Type _____

WATER SUPPLY (check one):
[X] Community (C) [ ] Shared Well (S)
[ ] Municipal (M) [ ] Other 'spring' (O)
[ ] Private Well (P)

FUTURE ADDITIONS - ALL PLANNED ADDITIONS MUST BE ENTERED (check all that apply):
[ ] Swimming Pool [ ] Jacuzzi [ ] Stable/Barn [ ] Workshop [ ] None
[ ] Garage [ ] Storage Building [ ] Deck/Patio [ ] Bedrooms [X] Other bathroom

The undersigned, owner, or legal agent for the owner, of the property described above as the "JOB LOCATION" has read the foregoing application, acknowledges that the contents of same are true, and authorizes agents of the MECKLENBURG COUNTY HEALTH DEPARTMENT to enter onto the property for the purpose of processing this request.

Signed: John D. Leopard Date: 5/13/03

NOTICE:

The undersigned, an authorized agent of the MECKLENBURG COUNTY HEALTH DEPARTMENT, certifies that the Department has approved the Request for the Job Location contained in this document. This approval is granted in accordance with the provisions of Laws And Rules For Sanitary Sewage Collection, Treatment And Disposal in effect at the time of issuance of the permit and is subject to the following provisions:

...No work shall be conducted on the septic tank system until an installation, Construction, Alteration and/or Repair approval is granted by this Department.

...This permit is not transferable.

...ADDITION APPROVED..

O.K. TO USE EXISTING SYSTEM

[ ] IMPROVEMENT PERMIT - VALID 60 MONTHS FROM ISSUANCE
[ ] MOBILE HOME EXCHANGE APPROVAL - VALID 6 MONTHS FROM ISSUANCE
[ ] ADDITION/RENOVATION APPROVAL - VALID 1 YEAR FROM ISSUANCE

Environmentalist 6/3/03 Date

WWATER : 122791

PROPOSED PLOT PLAN


COPY

HEALTH DEPARTMENT
ENVIRONMENTAL HEALTH DIVISION
700 NORTH TRYON STREET
CHARLOTTE, NC 28202
PHONE (704) 336-5102

FILE: 2294

TC: 165-121-30

Draw in and name all roads adjoining the property. Draw in and accurately dimension the lot concerned. Accurately indicate property boundaries proposed and/or existing structures and driveways, underground utilities, and wells and springs within 100 feet of the proposed building or drainfield.

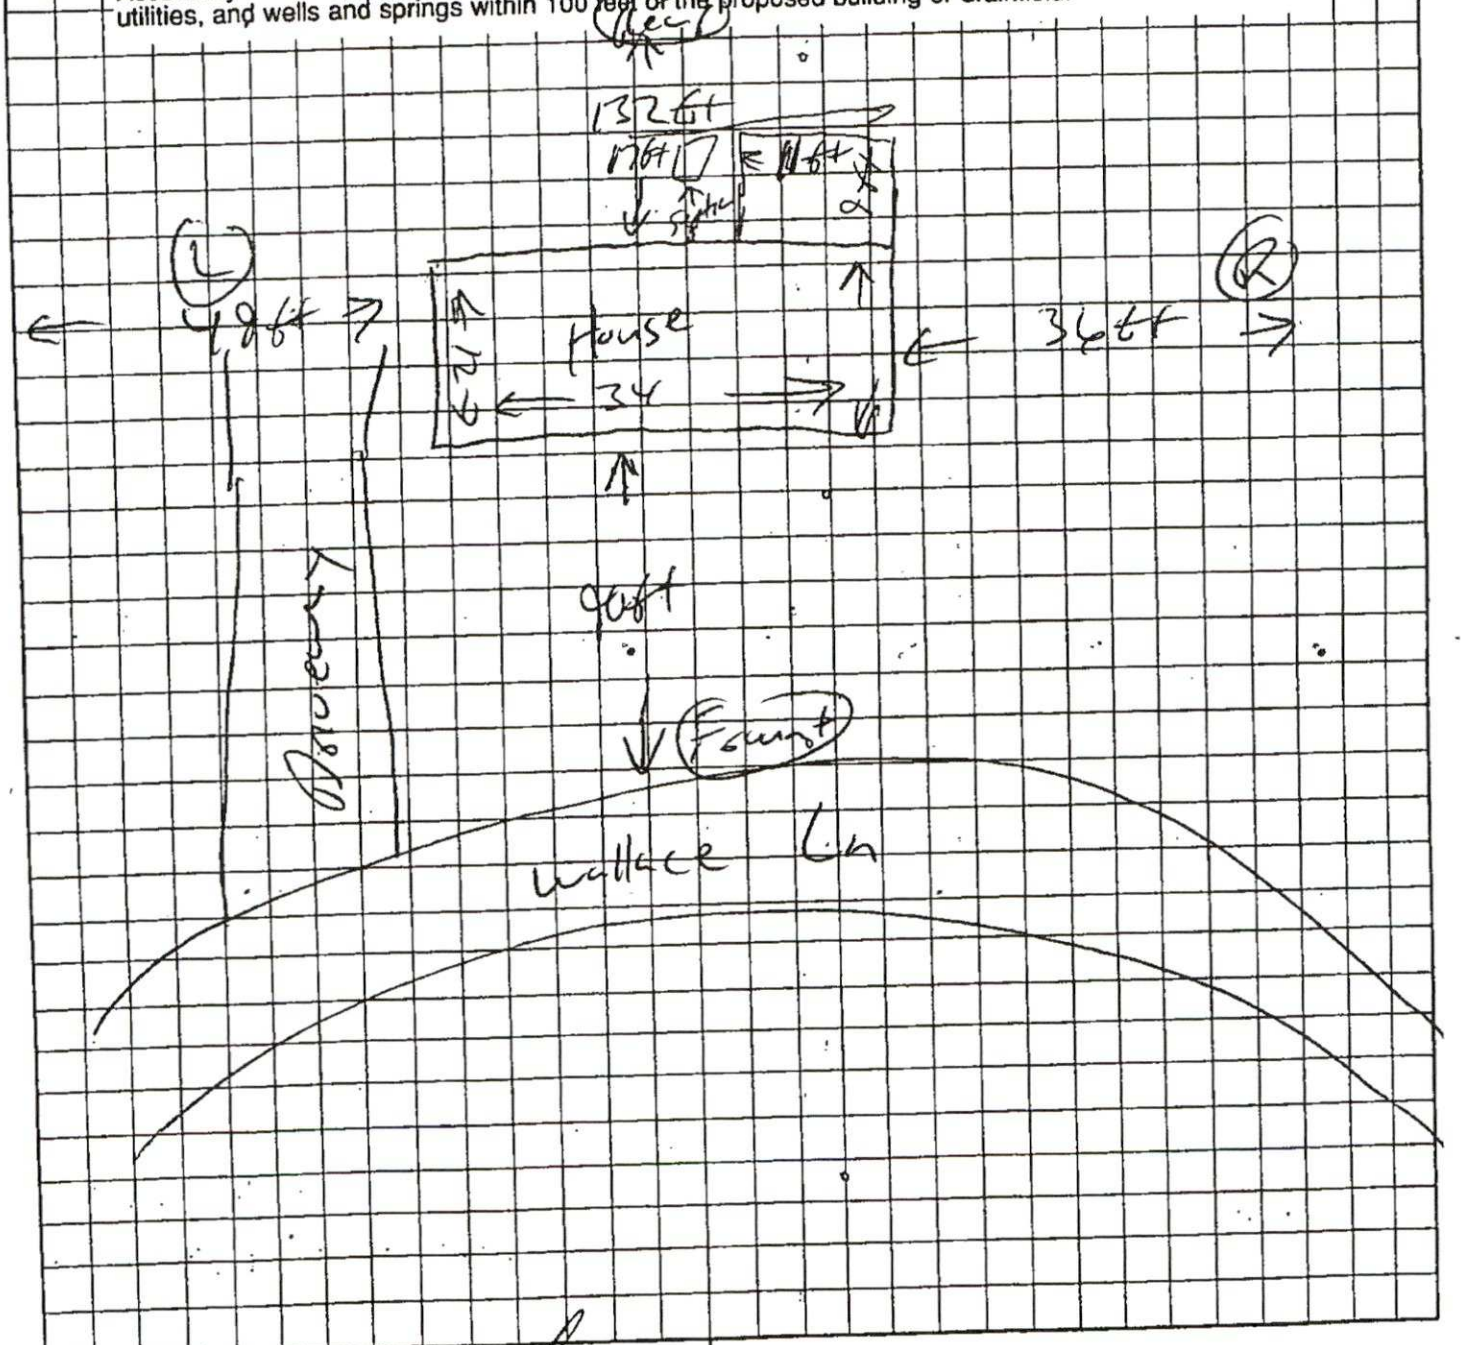

APPROVAL DATE _____


OWNER/AGENT SIGNATURE

DATE 5/15/03

White - Health Department's Copy

Canary - E.H.S. Copy

Pink - Owner's Copy

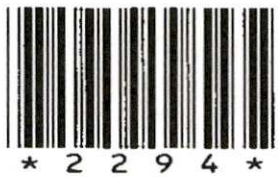

7635 WALLACE LN

16512130

5/20/08

marliwr

Groundwater and Wastewater Services File Imaging Project
May 2007
Barcode Font = IDAutomationHC39M

Mecklenburg County Groundwater & Wastewater Services
3205 Freedom Dr. Suite 8000 Charlotte, NC 28208
Phone: (980) 314-1680 Fax: (704) 336-6894

NC DHHS
Division of Environmental Health
On-Site Wastewater Section

IMPROVEMENT PERMIT/CONSTRUCTION AUTHORIZATION for REPAIRING an ON-SITE WASTEWATER TREATMENT & DISPOSAL SYSTEM

File #: 2294 Permit #: 13610 Tax Parcel #: 165-121-30

Property Owner: Laksanee Leopard

Job Location Address: 7635 Wallace Ln

City: Charlotte State: NC Zip Code: 28212

Improvement Permit Issuance Date: 2/8/23 **Construction Authorization Issuance Date:** _____

Permission is hereby given to **repair** an on-site wastewater treatment & and disposal system, with subsurface soil absorption and effluent discharge, as specified herein at the described location. This approval is granted based upon the application information submitted to our office. All work shall be completed on or before _____. The system shall meet all of the construction requirements of 15A NCAC 18A. 1900 which are in effect on the date of granting this approval. An **Operation Permit** must be obtained from the Mecklenburg County Health Department before any system can be covered up or placed into service. The issuance of this permit does not in any way guarantee that the system anticipated to be constructed will operate properly, or relieve any person now of hereafter owning, controlling or using such system from any liability resulting from the failure of the system to operate properly.

Permitted Design Flow: existing GPD

Site LTAR: existing GPD/ft^2

Liquid Capacity of Septic Tank: 1000 gallons

Liquid Capacity of Dosing Tank: NA gallons

Drainfield Design ☑ N/A

Trench Depth: _____ inches

Trench Width: _____ feet

Line Spacing: _____ feet (O.C.)

Total line length: _____ feet

# of Lines: _____ @ _____ feet

Depth of Media: _____ inches (Type) _____

Distribution Device: _____

Bed Design *(For Repair Installations ONLY.)* ☑ N/A

Bed Depth: _____ inches

Bed Width: _____ feet

Total line length: _____ feet

# of Lines: _____ @ _____ feet

Depth of Media: _____ inches (Type) _____

Distribution Device: _____

Water Supply Source

☑ Municipal ☐ Private Well ☐ Community Well

☐ Other _____


Minimum System Setbacks

Distance from Building Foundation: 5 feet

Distance from Property Line: 50 feet

Distance from Water Supply Source: 10 feet

SKETCH OF SYSTEM LAYOUT
(Proposed Layout)

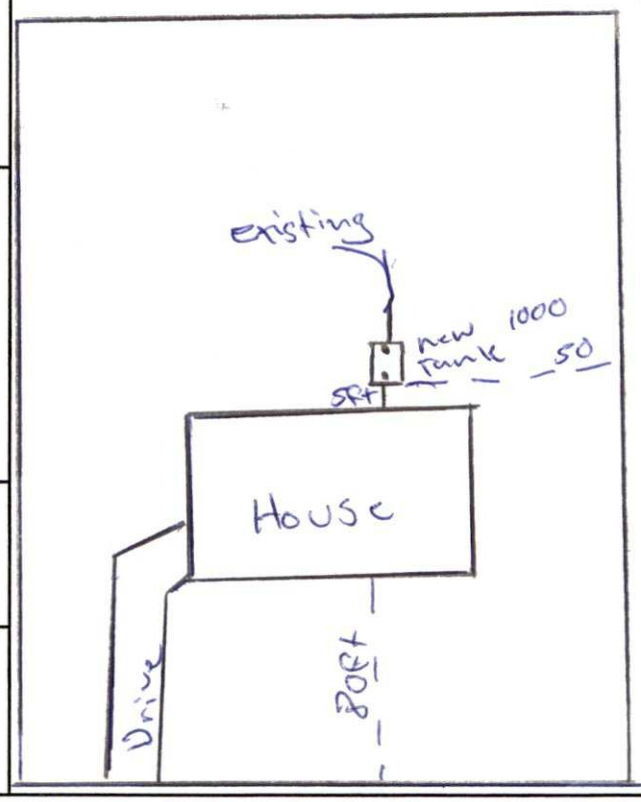

Comments: System Classification & Type: Tank / 6 / NA / NA

Sewer is located out front

Authorized Agent: Bryan Davenport Signature: Bryan Davenport

Owner Signature: _____ Date: _____

Mecklenburg County Groundwater & Wastewater Services
3205 Freedom Dr. Suite 8000 Charlotte, NC 28208
Phone: (980) 314-1680 Fax: (704) 336-6894

Septic System Pre-Construction Meeting Checklist

File # 2294 App# 13610 Tax Parcel# 165-121-30

Property Owner: Leopard

Job Location Address: 7635 Wallace Ln

City: Charlotte State: NC Zip Code: 28212

1. Does System design match facility, flow & wastewater characteristics?

   ☑ YES ☐ NO

   Comments: _____

2. Is there sufficient available space for the septic systems initial and repair areas?

   ☑ YES ☐ NO

   Comments: _____

3. Can the septic system be installed per the permit conditions and drawing on file?

   ☑ YES ☐ NO

   Comments: _____

*If "NO" is checked for any of the above the existing permit may need to be revoked.

Permission is hereby given to ☐ install ☐ alter ☐ repair an on-site wastewater treatment & and disposal system, with subsurface soil absorption and effluent discharge meeting all of the construction requirements of 15A NCAC 18A .1900 which are in effect on the date of granting this approval. **System shall not be installed while soils are in wet condition.**

Bryan Davenport
Authorized Agent

2-22-23
Date

Septic Blue / Brett with
Others Present

Mecklenburg County Groundwater & Wastewater Services
3205 Freedom Dr. Suite 8000, Charlotte, NC 28208
Phone: (980) 314-1680 Fax: (704) 336-6894

NC DHHS
Division of Environmental Health
On-Site Wastewater Section

OPERATION PERMIT for an
ON-SITE WASTEWATER TREATMENT & DISPOSAL SYSTEM

File #: 2294 Permit #: 13610 Tax Parcel #: 165-121-30

Property Owner: Leopard

Job Location Address: 7635 Wallace Ln

City: Charlotte State: NC Zip Code: 28212

Operation Permit Issuance Date: 2/21/23 Contractor Name: Septic Blue / Brett

Permitted Design Flow: existing GPD
Liquid Capacity of Septic Tank: ~~ex~~ 1000 gallons
Liquid Capacity of Dosing Tank: existing gallons
Tank Manufacture infiltrator Effluent Pump Model: NA

Drainfield Installation ☑ N/A
Trench Depth: _____ inches
Trench Width: _____ feet
Line Spacing: _____ feet (O.C.)
Total line length: _____ feet
# of Lines: _____ @ _____ feet
Depth of Media: _____ inches (Type) _____
Depth of Cover: _____ inches
Distribution Device: _____


Bed Installation *(For Repair Installations ONLY.)* ☑ N/A
Bed Depth: _____ inches
Bed Width: _____ feet
Total line length: _____ feet
# of Lines: _____ @ _____ feet
Depth of Media: _____ inches (Type) _____
Depth of Cover: _____ inches
Distribution Device: _____

Water Supply Source
☑ Municipal ☐ Private Well ☐ Community Well
☐ Other _____

System Installation Setbacks
Distance from Building Foundation: 8 feet
Distance from Property Line: 54 feet
Distance from Water Supply Source: 13 feet

Inspection Dates
Tank(s) Inspected: 2/21/23
Excavation Inspected: 2/21/23
Pump & Controls Inspected: N/A

SKETCH OF SYSTEM INSTALLATION
(As-Built Drawing)

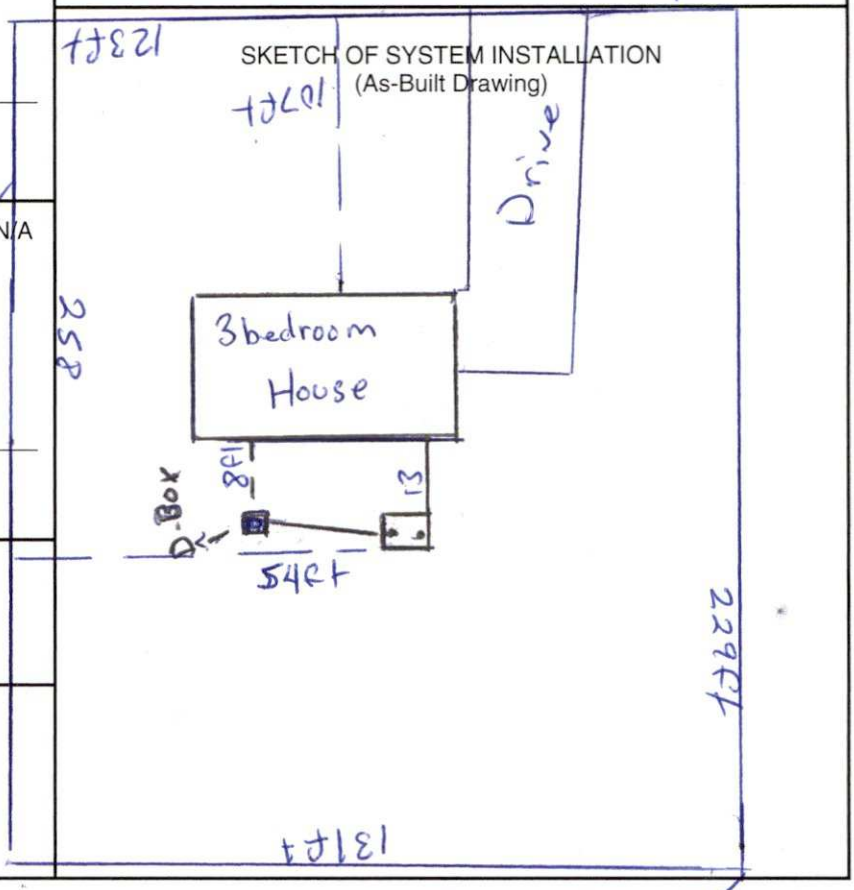

The undersigned has inspected the Septic Tank System described above, and certifies it has been ☐ installed ☐ altered ☑ repaired ☐ as detailed in the plot above ☑ in accordance with the permit issued and meets the provisions of 15A NCAC 18A. 1900, "Laws and Rules for Sewage Treatment and Disposal Systems" in effect on the date of issuance of the permit. The issuance of this Operation Permit does not in any way guarantee that the system will operate properly or relieve any person now or hereafter owning, controlling, or using such system from any liability resulting from the failure of the system to operate properly. This document is issued subject to those restrictions and conditions shown on the permit(s) and the provisions of 15A NCAC 18A. 1900 in addition to those listed below under "Comments." This document shall be null and void if any information contained in the application is untrue or if any additions are made to the property which would increase the requirements for said system.

Notice: Disturbance of the designated repair area may result in the Suspension or Revocation of this permit.

Comments: System Classification & Type:

DENR Authorized Agent: Bryan Davenport Signature: B. Davenport

Mecklenburg County Groundwater & Wastewater Services
3205 Freedom Dr. Suite 8000, Charlotte, NC 28208
Phone: (980) 314-1680 Fax: (704) 336-6894

NC DHHS
Division of Environmental Health
On-Site Wastewater Section

OPERATION PERMIT for an
ON-SITE WASTEWATER TREATMENT & DISPOSAL SYSTEM

File #: 2294 Permit #: 13610 Tax Parcel #: 165-121-30

Property Owner: Leoparel

Job Location Address: 7635 Wallace Ln

City: Charlotte State: NC Zip Code: 28212

OPERATION PERMIT CONDITIONS:

I. Performance: System shall perform in accordance with 15A NCAC 18A .1961.

II. Monitoring: System shall be monitored as required by 15A NCAC 18A .1961.

III. Maintenance: Ground absorption sewage treatment and disposal systems shall be checked, and the contents of the septic tank removed, periodically from all compartments, to ensure proper operation of the system. The contents shall be pumped whenever the solids level is found to be more than 1/3 of the liquid depth in any compartment.

IV. Operation: System shall be operated in accordance with 15A NCAC 18A .1961.

System Classification: Tank

*Operation Permits for Type V and VI systems expire five (5) years from the date of issuance (in accordance with Table V(a)). The system owner must contact GWS six (6) months prior to expiration for permit renewal.

Subsurface system operator required: Yes ☐ No ☑

☐ This type of system requires the system owner to maintain a contract with a certified operator to perform system inspection, maintenance, and reporting as required in 15A NCAC 18A .1961. and Table V(a). The system owner is responsible for all fees associated with these services.

☑ System does not require inspection by GWS on a routine frequency.

☐ System requires inspection by GWS once every five (5) years. The system owner is responsible for all fees associated with the inspection.

☐ System requires inspection by GWS once every three (3) years. The system owner is responsible for all fees associated with the inspection.

☐ System requires inspection by GWS once every twelve (12) months. The system owner is responsible for all fees associated with the inspection.

☐ System requires inspection by GWS once every six (6) months. The system owner is responsible for all fees associated with the inspection.

V. Other: Tank

DENR Authorized Agent: Bryan Davenport Date: 2/22/23

Signature: Bryan Davenport