

2027 SAM WILSON RD

05521145

1/10/2008

duponbj

Groundwater and Wastewater Services File Imaging Project
May 2007
Barcode Font = IDAutomationHC39M

#717

GWS – RES APPROVED

SEPTIC FEE: _____
DATE: _____
CRT [ ]

PERMIT APPLICATION FOR A RESIDENTIAL SITE IMPROVEMENT PERMIT / CONSTRUCTION AUTHORIZATION FOR ON-SITE WASTEWATER SYSTEM NEW WELL INSTALLATION OR REPAIR OF EXISTING WELL MECKLENBURG COUNTY GROUNDWATER & WASTEWATER SERVICES

WELL FEE: _____
DATE: _____
CRT [ ]

FILE # 16464B

SEPTIC / TYPE APPLICATION: ☐ NONE ☐ NEW SYSTEM ☐ ALTERATION ☒ REPAIR ☐ MODIFY PLOT PLAN

WELL / TYPE APPLICATION: ☒ NONE ☐ NEW WELL ☐ MAJOR REPAIR ☐ ABANDONMENT

JOB LOCATION INFORMATION:

TAX/PARCEL #: 05521145
STREET ADDRESS: 2027 Sam Wilson Rd.
CITY: Charlotte
STATE: NC ZIP: 28214
SUBDIVISION OR MOBILE HOME PARK NAME:
LOT #:
TOWNSHIP:

☐ 9-MECKLENBURG ☐ 4-PINEVILLE
☒ 1-CHARLOTTE ☐ 5-MATTHEWS
☐ 2-DAVIDSON ☐ 6-HUNTERSVILLE
☐ 3-CORNELIUS ☐ 7-MINT HILL

1931

BUILDING INFORMATION:

TYPE OF BUILDING:

☐ SINGLE MOBILE HOME (S) ☐ MODULAR HOME (M)
☐ DOUBLE WIDE (D) ☐ MULTIPLE FAMILY (U)
☒ HOUSE (H) ☐ OTHER

HEATED SQUARE FOOTAGE: 2,350
NUMBER OF BEDROOMS: 5
NUMBER OF OCCUPANTS: 5

FOUNDATION FOR RESIDENCE:

☐ CONCRETE SLAB ☒ BASEMENT WITH PLUMBING
☐ CRAWLSPACE ☐ BASEMENT WITH NO PLUMBING

IF PLANNING TO EXPAND/ALTER THE EXISTING SYSTEM INDICATE THE FOLLOWING CHANGES:

NUMBER OF BEDROOMS TO BE ADDED: NUMBER OF ADDITIONAL OCCUPANTS IN THE RESIDENCE:
WILL THERE BE A HOME BUSINESS IN THE RESIDENCE? ☐ YES ☒ NO TYPE:

WATER SUPPLY:

☐ MUNICIPAL (M) ☒ PUBLIC (C) ☐ PRIVATE WELL (P) ☐ SHARED WELL (S) ☐ OTHER SPRINGS (O)

PROPOSED USE OF WELL: ☒ N/A ☐ IRRIGATION ☐ POTABLE ☐ GEOTHERMAL ☐ OTHER

ARE ANY OF THE FOLLOWING LOCATED ON THE PROPERTY? IF SO, PLEASE SHOW LOCATION ON SITE PLAN/PLAT.

BURIED CABLES, LANDFILLS, STUMPHOLES	☒ YES ☐ NO	WELLS, SPRINGS, OR WATER LINES	☒ YES ☐ NO
EXISTING WASTEWATER SYSTEMS	☒ YES ☐ NO	DESIGNATED WETLANDS	☐ YES ☒ NO
EASEMENTS OR RIGHT-OF-WAYS	☒ YES ☐ NO	GRADING/SOIL REMOVAL PERFORMED	☐ YES ☒ NO

PROPERTY OWNER:

NAME: Tony + Kimberlee Chavis
ADDRESS: 2027 Sam Wilson Rd.
CITY: Charlotte
STATE: NC ZIP: 28214
HOME PHONE: 704-674-98 WORK PHONE: 12
MOBILE PHONE: FAX:

LEGAL AGENT FOR PROPERTY OWNER, IF APPLICABLE:

NAME:
ADDRESS:
CITY:
STATE: ZIP:
HOME PHONE: WORK PHONE:
MOBILE PHONE FAX:

WHAT DATE WAS THE PROPERTY ORIGINALLY DEEDED AND RECORDED?
WHAT IS THE ANTICIPATED CLOSING DATE FOR THIS PROPERTY?

"An Improvement Permit is subject to suspension or revocation if site plans or the intended use change or if information submitted in this application is falsified or changed. The undersigned, owner, or legal agent for the owner, of the property described above as the "Job Location" has read the foregoing application, acknowledges that the contents of same are true, and authorizes the Mecklenburg County Health Department to enter onto the property for the purpose of processing this request.


Kim Chavis 4/24/06
Owner's/Agent's Signature Date


NORTH CAROLINA DEPARTMENT OF
ENVIRONMENT & NATURAL RESOURCES DIVISION
OF ENVIRONMENTAL HEALTH ON-SITE
WASTEWATER SECTION

"A Well Permit is subject to suspension or revocation if site plans or the intended use change or if information submitted in this application is falsified or changed. The undersigned, owner, or legal agent for the owner, of the property described above as the "Job Location" has read the foregoing application, acknowledges that the contents of same are true, and authorizes the Mecklenburg County Health Department to enter onto the property for the purpose of processing this request.

Owner's/Agent's Signature Date

MECKLENBURG COUNTY HEALTH DEPARTMENT
GROUNDWATER & WASTEWATER SERVICES
700 N. TRYON ST., SUITE 211
CHARLOTTE, NC 28202 704-336-5105 / FAX 704-336-5994

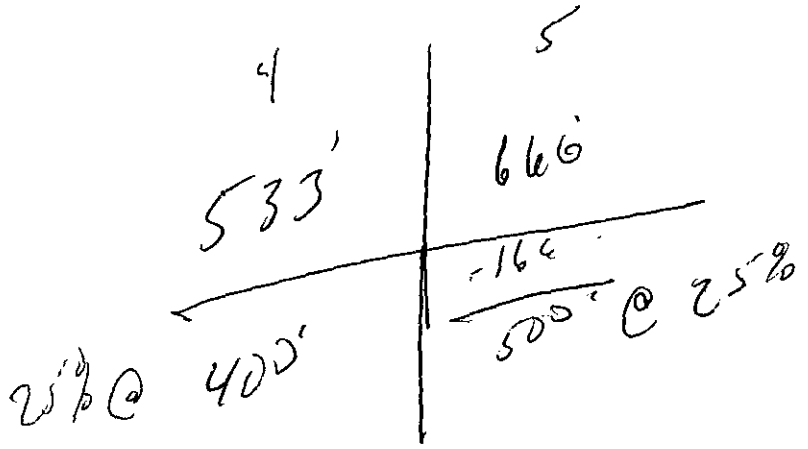
4
5
533'
666
-166

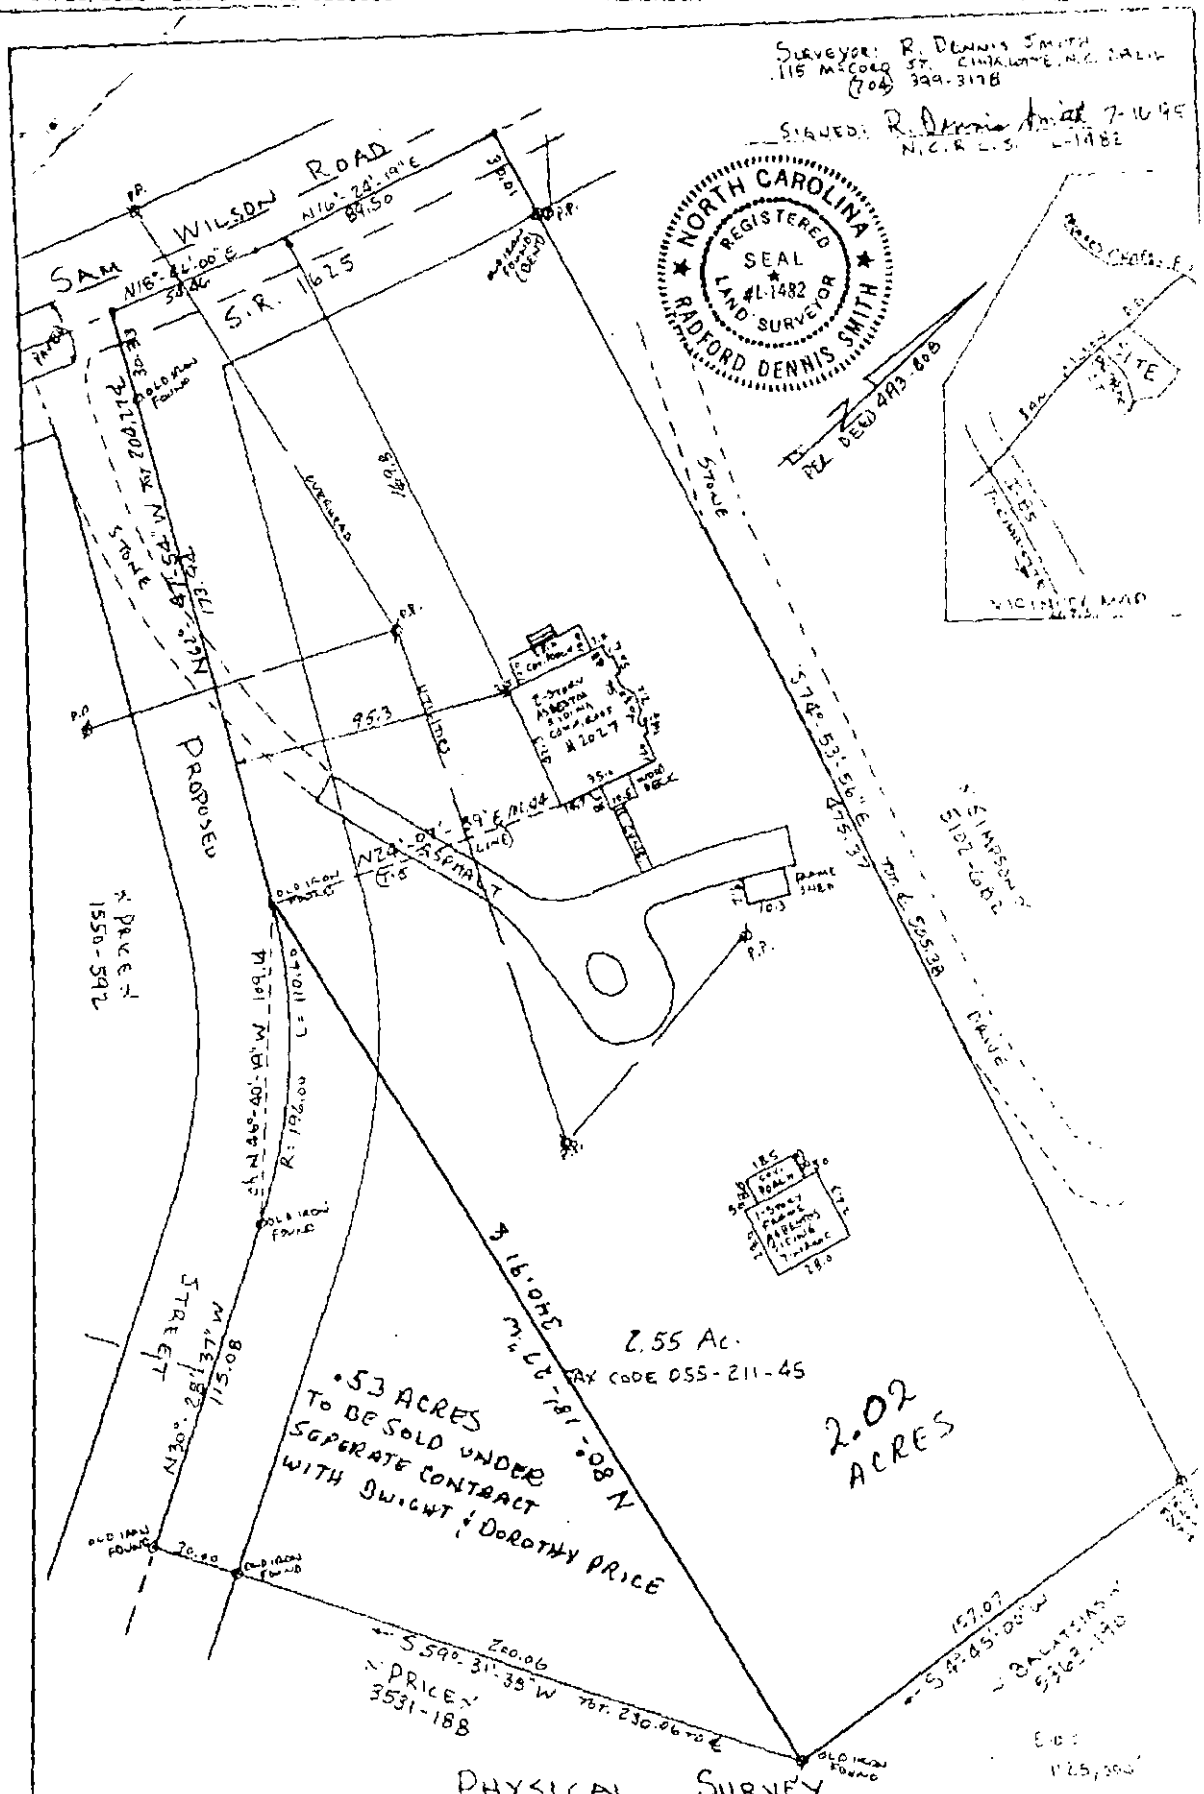

PHYSICAL SURVEY

OF

2027 SAM WILSON ROAD

PAW CREEK, TOWNSHIP, MECKLENBURG COUNTY, N.C.

PROPERTY OF GARY E. STEWART & wife AUDREY F. STEWART

DATE: JULY 8, 1995 SCALE: 1"=50'

MAP RECORDED IN BOOK _____ AT PAGE _____ DEED RECORDED IN BOOK 4193 PAGE 808

Mecklenburg County Groundwater & Wastewater Services
700 N. Tryon St., Suite 211 Charlotte, NC 28202
Phone: (704) 336-5103 Fax: (704) 336-6894

NC DENR
Division of Environmental Health
On-Site Wastewater Section

OPERATION PERMIT for an ON-SITE WASTEWATER TREATMENT & DISPOSAL SYSTEM

File #: 14648 Permit #: _____ Tax Parcel #: 055-211-45

Property Owner: Tonya Chasis

Job Location Address: 2027 Sam Wilson

City: Charlotte State: NC Zip Code: 28214

Operation Permit Issuance Date: 5-12-06 Contractor Name: White Chimney

Permitted Design Flow: 600 GPD

Liquid Capacity of Septic Tank: 1500 gallons

Liquid Capacity of Dosing Tank: N/A gallons

Effluent Pump Model: N/A

Drainfield Installation ☐ N/A

Trench Depth: 30" inches

Trench Width: 3 feet

Line Spacing: 9' feet (O.C.)

Total line length: 300' feet

# of Lines: 3 @ 100' feet

Depth of Media: 12" inches (Type) 25% Chaba

Depth of Cover: 18" inches

Distribution Device: Drop Box

Bed Installation *(For Repair Installations ONLY.)* ☒ N/A

Bed Depth: _____ inches

Bed Width: _____ feet

Total line length: _____ feet

# of Lines: _____ @ _____ feet

Depth of Media: _____ inches (Type) _____

Depth of Cover: _____ inches

Distribution Device: _____

Water Supply Source

☒ Municipal ☐ Private Well ☐ Community Well

☐ Other _____

System Installation Setbacks

Distance from Building Foundation: >5' feet

Distance from Property Line: >10' feet

Distance from Water Supply Source: >50' feet


Inspection Dates

Tank(s) Inspected: 5-12-06

Excavation Inspected: 5-12-06

Pump & Controls Inspected: N/A

SKETCH OF SYSTEM INSTALLATION (As-Built Drawing)

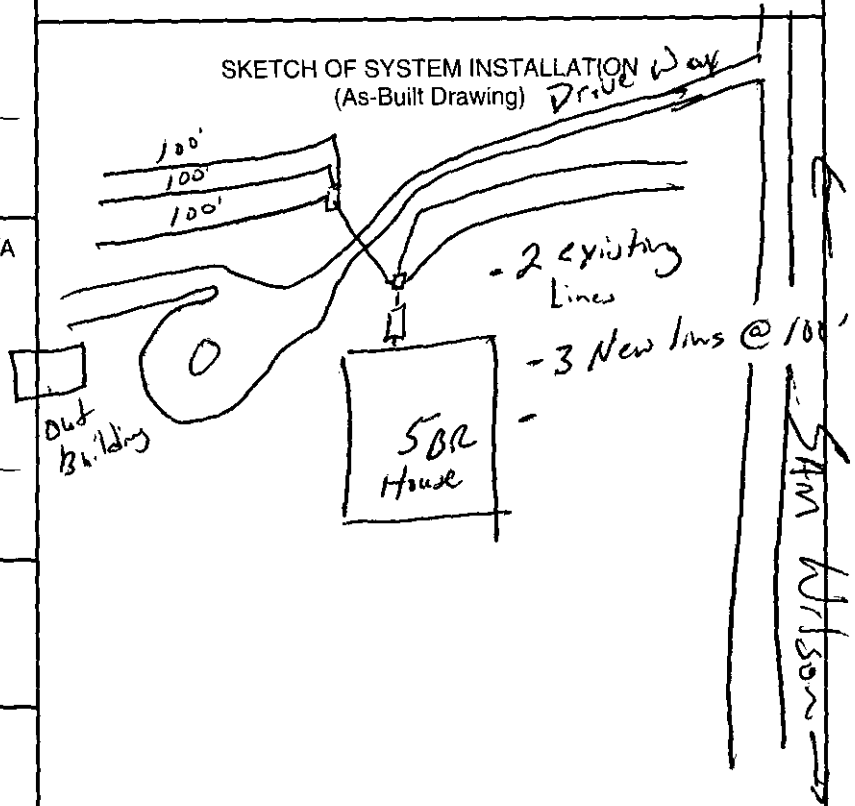

The undersigned has inspected the Septic Tank System described above, and certifies it has been ☐ installed ☐ altered ☒ repaired ☐ as detailed in the plot above ☐ in accordance with the permit issued and meets the provisions of 15A NCAC 18A. 1900, "Laws and Rules for Sewage Treatment and Disposal Systems" in effect on the date of issuance of the permit. The issuance of this Operation Permit does not in any way guarantee that the system will operate properly or relieve any person now or hereafter owning, controlling, or using such system from any liability resulting from the failure of the system to operate properly. This document is issued subject to those restrictions and conditions shown on the permit(s) and the provisions of 15A NCAC 18A. 1900 in addition to those listed below under "Comments." This document shall be null and void if any information contained in the application is untrue or if any additions are made to the property which would increase the requirements for said system.

Notice: Disturbance of the designated repair area may result in the Suspension or Revocation of this permit.

Comments: System Classification & Type: II b

DENR Authorized Agent: Zach Peterson Estes Signature: Zach Peterson Estes

Mecklenburg County Groundwater & Wastewater Services
700 N. Tryon St., Suite 211 Charlotte, NC 28202
Phone: (704) 336-5103 Fax: (704) 336-5894

NC DENR
Division of Environmental Health
On-Site Wastewater Section

INSTALLATION APPROVAL for an ON-SITE WASTEWATER TREATMENT & DISPOSAL SYSTEM

File #: 6464B Permit #: _____ Tax Parcel #: 055-211-45

Property Owner: Tony + Kimberly Chavis

Job Location Address: 8027 San Wilson R

City: Charlotte State: NC Zip Code: 28214

Installation Approval Issuance Date: 4/27/06

Permission is hereby given to ☐ install ☐ alter ☑ repair an on-site wastewater treatment & and disposal system, with subsurface soil absorption and effluent discharge, as specified herein at the described location. This approval is granted based upon the application information submitted to our office. All work shall be completed on or before 5-27-06, after which date this approval shall be null and void. The system shall meet all of the construction requirements of 15A NCAC 18A. 1900 which are in effect on the date of granting this approval. An **Operation Permit** must be obtained from the Mecklenburg County Health Department before any system can be covered up or placed into service. The issuance of this permit does not in any way guarantee that the system anticipated to be constructed will operate properly, or relieve any person now of hereafter owning, controlling or using such system from any liability resulting from the failure of the system to operate properly.

***NOTICE: This system shall not be installed while soils are in a wet condition.**

Permitted Design Flow: 600 GPD

Site LTAR: 0.3 GPD/ft² (For new installations only.)

Liquid Capacity of Septic Tank: N/A gallons

Liquid Capacity of Dosing Tank: N/A gallons

Drainfield Design ☐ N/A

Trench Depth: 24-30 inches

Trench Width: 3 feet

Line Spacing: 9 feet (O.C.)

Total line length: 300' feet

# of Lines: 3 @ 100' feet

Depth of Media: 12" inches (Type) Chamber

Distribution Device: Distribution Box

Bed Design *(For Repair Installations ONLY.)* ☑ N/A

Bed Depth: _____ inches

Bed Width: _____ feet

Total line length: _____ feet

# of Lines: _____ @ _____ feet

Depth of Media: _____ inches (Type) _____

Distribution Device: _____

Water Supply Source

☒ Municipal ☐ Private Well ☐ Community Well

☐ Other _____


Minimum System Setbacks

Distance from Building Foundation: >5' feet

Distance from Property Line: >5' feet

Distance from Water Supply Source: >100' feet

SKETCH OF SYSTEM LAYOUT
(Proposed Layout)

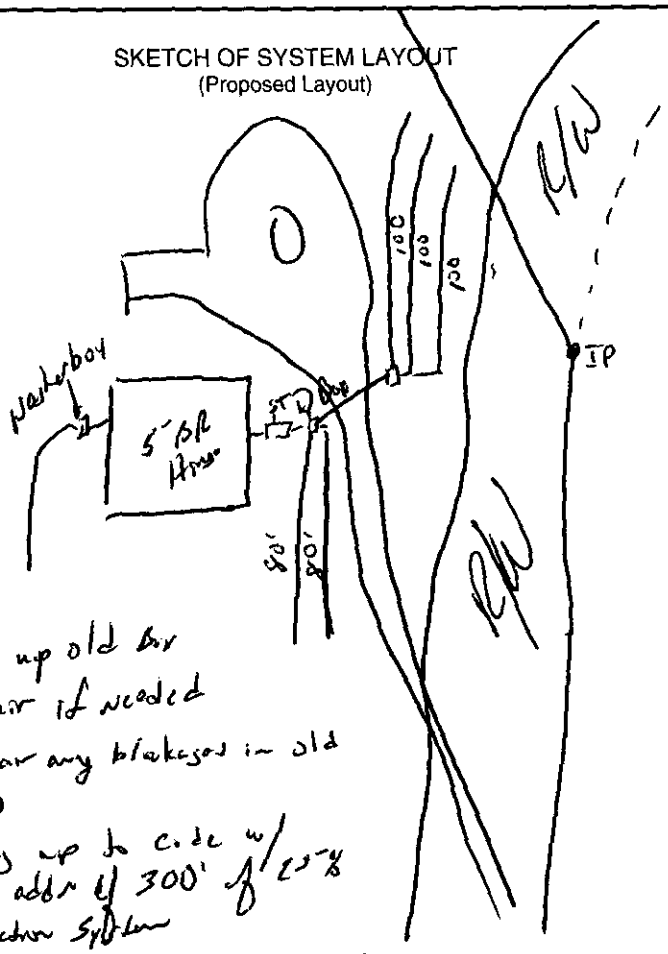

- Dig up old bx Repair if needed
- Repair any blockages in old lines
- Bring up to code w/ the addn of 300' of 25% Reduction System
- Acknowledge R/W or Property Line

Comments: System Classification & Type: IIIg

DENR Authorized Agent: Zach Pate EHS Signature: Zach Pate

2010
TANK

Groundwater & Wastewater Services
Septic Project File & Data Review Worksheet

GWS File #: G4693 WASPS App #: _____

Primary ES assigned to project: PLW

Secondary ES assigned to project: _____

Project Type: New System ☐ Alteration ☐ Repair ☑ Modified Plot Plan ☐

I. File Review:

Rule or Law	Permit Application			
.1937(d)	Is the Application complete	Yes ☑	No ☐	N/A ☐
.1937(d)	Is there a Site plan/Plat with application	Yes ☑	No ☐	N/A ☐
.1937(d)	Is the Facility shown?	Yes ☑	No ☐	N/A ☐
.1937(d)	Are appurtenances shown	Yes ☑	No ☐	N/A ☐
	Site Evaluation Information			
.1939 (a)(1)	Topography and Landscape Position Recorded?	Yes ☐	No ☐	N/A ☐
.1940 (a-g)	Slope % Recorded?	Yes ☐	No ☐	N/A ☐
.1939 (a)(2)	Texture Class Recorded?	Yes ☐	No ☐	N/A ☐
.1939 (a)(2)	Structure type Recorded?	Yes ☐	No ☐	N/A ☐
.1939 (a)(2)	Consistence Recorded?	Yes ☐	No ☐	N/A ☐
.1939 (a)(2)	Mineralogy Recorded?	Yes ☐	No ☐	N/A ☐
.1939 (a)(3)	Soil Wetness Condition Recorded?	Yes ☐	No ☐	N/A ☐
.1939 (a)(4)	Soil Depth to Rock or Parent Material Recorded When Encountered	Yes ☐	No ☐	N/A ☐
.1939 (a)(5)	Depth to Restrictive Horizons Recorded When Encountered?	Yes ☐	No ☐	N/A ☐
.1939 (a)(6)	Sufficient Available Space Recorded?	Yes ☐	No ☐	N/A ☐
.1937(m)	Are the Profile Locations Shown?			
.1939(a)	Are the S/PS Profiles in system & in repair area?	Yes ☐	No ☐	N/A ☐
& .1945(b)	Number of auger borings made: _____ Were sufficient auger borings made?	Yes ☐	No ☐	N/A ☐
.1939(d), .1955, .1956, .1957	LTAR	Yes ☐	No ☐	N/A ☐
	Improvement Permit/Construction Authorization			
.1937(g) 130A-336(a)	Proposed System Type stated-Initial	Yes ☐	No ☐	N/A ☐
.1945(b)	Proposed System Type stated-Repair	Yes ☐	No ☐	N/A ☐
130A-336 (a)(3)	System location identifiable by setbacks - Initial	Yes ☐	No ☐	N/A ☐
.1937(g) .1945(b)	System components shown – Initial	Yes ☐	No ☐	N/A ☐
.1945(b)	Repair area shown	Yes ☐	No ☐	N/A ☐
.1937 (f)(g)	Does System design match facility, flow & WWcharacteristics?	Yes ☐	No ☐	N/A ☐
.1937 (f)(g)	Is System design consistent with soil/site conditions?	Yes ☐	No ☐	N/A ☐
.1937 (f)(g)	Is the System located in the approved area?	Yes ☐	No ☐	N/A ☐
130A-336(a)	Is the Design flow (gpd) indicated?	Yes ☐	No ☐	N/A ☐

130A-336(a)	Number of Bedrooms, employees, seats, etc. indicated?	Yes ☐	No ☐	N/A ☐
.1937(g)	Trench depth indicated?	Yes ☐	No ☐	N/A ☐
.1937(g)	Trench width indicated?	Yes ☐	No ☐	N/A ☐
.1937(g)	Trench length indicated?	Yes ☐	No ☐	N/A ☐
130A-336(a)(1)	Proposed/existing well shown?	Yes ☐	No ☐	N/A ☐
130A-336(a)(1)	Property line lengths shown?	Yes ☐	No ☐	N/A ☐
130A-336(a)	Facility/appurtenance setbacks shown from fixed points?	Yes ☐	No ☐	N/A ☐
	Operation Permit			
.1937(i)	System type as described in table V(a) of rule .1961	Yes ☐	No ☐	N/A ☐
.1937(i)	Conditions for system performance, operation, maintenance, monitoring and reporting.	Yes ☐	No ☐	N/A ☐

II. WASPS Review:

Construction authorization issued	Yes ☐	No ☐	N/A ☐
Installation approval issued	Yes ☐	No ☐	N/A ☐
Operation permit issued	Yes ☐	No ☐	N/A ☐
Other related documentation	Yes ☐	No ☐	N/A ☐

Items requiring correction/modification: _____

Comments:

_____

_____

_____

_____

_____

IA issued date: _____

OP issued date: _____

Review performed by: KR _____ Date performed: 2-25-10

6464B

MECKLENBURG COUNTY
GROUNDWATER & WASTEWATER SERVICES

PW 4471

APPLICATION FOR A RESIDENTIAL SITE IMPROVEMENT PERMIT/ CONSTRUCTION AUTHORIZATION FOR AN ON-SITE WASTEWATER SYSTEM, NEW WELL INSTALLATION, OR REPAIR OF EXISTING WELL

1. **SEPTIC / TYPE APPLICATION:** ☐ N/A ☐ NEW SYSTEM ☐ ALTERATION ☑ REPAIR ☐ MODIFIED PLOT PLAN

2. **WELL / TYPE APPLICATION:** ☐ N/A ☐ NEW WELL ☐ MAJOR REPAIR ☐ ABANDONMENT

3. **JOB LOCATION INFORMATION:**
TAX PARCEL NUMBER: 055-211-45
STREET ADDRESS: 2027 SAM WILSON RD
CITY: CHARLOTTE
STATE: NC ZIP: 28214
SUBDIVISION NAME:
LOT #: LOT SIZE (acres): 2.02
TOWNSHIP: 1931
☑ 0-MECKLENBURG ☐ 3-CORNELIUS ☐ 6-HUNTERSVILLE
☐ 1-CHARLOTTE ☐ 4-PINEVILLE ☐ 7-MINT HILL
☐ 2-DAVIDSON ☐ 5-MATTHEWS

4. **BUILDING INFORMATION:**
BUILDING TYPE:
☐ SINGLE MOBILE HOME ☐ MODULAR HOME
☐ DOUBLE WIDE ☐ MULTIPLE FAMILY
☑ HOUSE ☐ OTHER _____
HEATED SQUARE FOOTAGE:
NUMBER OF BEDROOMS: 4
NUMBER OF OCCUPANTS: 2 ADULTS 1 INFANT (3)
FOUNDATION TYPE:
☑ CONCRETE SLAB ☑ BASEMENT WITH PLUMBING
☑ CRAWL SPACE ☐ BASMENT WITH NO PLUMBING

5. **IF PLANNING TO EXPAND OR ALTER THE EXISTING SEPTIC SYSTEM PLEASE COMPLETE THE FOLLOWING SECTION:** ☐ N/A

NUMBER OF BEDROOMS TO BE ADDED: _____ NUMBER OF ADDITIONAL OCCUPANTS IN THE RESIDENCE: _____

6. **WATER SUPPLY:** ☑ MUNICIPAL ☐ PRIVATE WELL ☐ PUBLIC WELL ☐ SHARED WELL ☐ OTHER _____

7. **PROPOSED USE OF WELL:** ☐ N/A ☐ IRRIGATION ☐ POTABLE (DRINKING WATER) ☐ OTHER _____

8. **PLEASE INDICATE AND RANK DESIRED SEPTIC SYSTEM TYPE(S) IN ORDER OF PREFERENCE** *(1-MOST DESIRED 5-LEAST DESIRED):*

☐ N/A ☑ ANY TYPE ☐ CONVENTIONAL ☐ ACCEPTED ☐ INNOVATIVE ☐ ALTERNATIVE ☐ OTHER _____

8A. **RANK:** ____ ____ ____ ____ ____

9. **DO ANY OF THE FOLLOWING APPLY TO THE PROPERTY IN QUESTION? IF "YES" PLEASE ATTACH SUPPORTING DOCUMENTATION.**

BURIED CABLES, LANDFILLS, STUMPHOLES	☑ YES	☐ NO	GRADING/SOIL REMOVAL PERFORMED	☐ YES	☐ NO
EXISTING WASTEWATER (SEPTIC) SYSTEMS	☑ YES	☐ NO	JURISDICTIONAL WETLANDS	☐ YES	☑ NO
WELLS, SPRINGS, OR WATER LINES	☐ YES	☑ NO	APPROVAL REQUIRED BY ANY OTHER PUBLIC AGENCY	☐ YES	☑ NO
EASEMENTS OR RIGHT-OF-WAYS	☑ YES	☐ NO	WASTEWATER OTHER THAN DOMESTIC SEWAGE	☐ YES	☐ NO
CHEMICAL/PETROLEUM STORAGE TANKS	☐ YES	☑ NO	KNOWN UNDERGROUND CONTAMINATION	☐ YES	☑ NO
WASTE STORAGE	☐ YES	☑ NO	GROUNDWATER USE RESTRICTIONS/VARIANCES	☐ YES	☑ NO

10. **WHAT DATE WAS THE PROPERTY ORIGINALLY DEEDED AND RECORDED?** _____ ☑ UNKNOWN

11. **WHAT IS THE ANTICIPATED CLOSING DATE FOR THIS PROPERTY?** _____ ☑ N/A

12. **PROPERTY OWNER:**
NAME: WILSON & CORNELL HOUGH
ADDRESS: 2027 SAM WILSON RD
CITY: CHARLOTTE
STATE: NC ZIP: 28214
HOME PHONE: 704-995-4556
WORK PHONE:
MOBILE PHONE:
FAX:

13. **OWNER'S LEGAL REPRESENTATIVE, IF APPLICABLE:**
NAME:
ADDRESS:
CITY:
STATE: ZIP:
HOME PHONE:
WORK PHONE:
MOBILE PHONE:
FAX:

MECKLENBURG COUNTY – GROUNDWATER & WASTEWATER SERVICES
700 N. TRYON ST. SUITE 211 CHARLOTTE, NC 28202, OFFICE: 704-336-5103, FAX: 704-336-6894

Revised on: 7/1/08

14. SEPTIC SYSTEM PERMIT APPLICATION:

If the information in this application is falsified, changed, or the site is altered, then the Improvement Permit and Authorization to Construct shall become invalid. I have read this application and certify that the information provided herein is true, complete and correct. Authorized county and state officials are granted right of entry to conduct necessary inspections to determine compliance with applicable laws and rules. I understand that I am solely responsible for the proper identification and labeling of all property lines and corners and making the site accessible so that a complete site evaluation can be performed. The permit is valid for either sixty (60) months or is non-expiring depending upon the documentation submitted: complete site plan = 60 months, complete plat = non-expiring.

RCH (Initial here for septic system applications)

15. WELL PERMIT APPLICATION:

If the information in this application is falsified, changed, or the site is altered, then the Well Permit shall become invalid. I have read this application and certify that the information provided herein is true, complete and correct. Authorized county and state officials are granted right of entry to conduct necessary inspections to determine compliance with applicable laws and rules. I understand that I am solely responsible for the proper identification and labeling of all property lines and corners and making the site accessible so that a complete site evaluation can be performed. The permit is valid for a period of twelve (12) months from the date of issuance.

_____ (Initial here for well applications)

16. APPLICATION SIGNATURE SECTION:

ONLY COMPLETE APPLICATIONS WILL BE PROCESSED. A proper signature is required in order to process your application. Please review the application carefully and sign in the space provided below.

_____ _____

Property Owner's or Owner's Legal Representative Signature Date

---

OFFICE USE ONLY

☐ SURVEY PLAT TO SCALE SUBMITTED ☐ SCALED SITE PLAN SUBMITTED ☐ UN-SCALED SITE PLAN SUBMITTED

SEPTIC APPLICATION FEES RECEIVED: $ _____ DATE FEE RECEIVED: _____

WELL APPLICATION FEES RECEIVED: $ _____ DATE FEE RECEIVED: _____

APPLICATION PROCESSED BY: JC

GWS FILE NUMBER ASSIGNED: 64/64B3

APPLICATION ID NUMBER ASSIGNED: 4471

COMMENTS:

MECKLENBURG COUNTY – GROUNDWATER & WASTEWATER SERVICES
700 N. TRYON ST. SUITE 211 CHARLOTTE, NC 28202, OFFICE: 704-336-5103, FAX: 704-336-6894

Revised on: 7/1/08

Mecklenburg County Groundwater & Wastewater Services
700 N. Tryon St., Suite 211 Charlotte, NC 28202
Phone: (704) 336-5103 Fax: (704) 336-6894

NC DENR
Division of Environmental Health
On-Site Wastewater Section

INSTALLATION APPROVAL for an ON-SITE WASTEWATER TREATMENT & DISPOSAL SYSTEM

File #: 6464B Permit #: 4471 Tax Parcel #: 055 211 45

Property Owner: Cordell & Alison Hough

Job Location Address: 2027 Sam Wilson Rd

City: Charlotte State: NC Zip Code: 28214

Installation Approval Issuance Date: _____

Permission is hereby given to ☐ install ☐ alter ☑ repair an on-site wastewater treatment & and disposal system, with subsurface soil absorption and effluent discharge, as specified herein at the described location. This approval is granted based upon the application information submitted to our office. All work shall be completed on or before _____, after which date this approval shall be null and void. The system shall meet all of the construction requirements of 15A NCAC 18A. 1900 which are in effect on the date of granting this approval. An **Operation Permit** must be obtained from the Mecklenburg County Health Department before any system can be covered up or placed into service. The issuance of this permit does not in any way guarantee that the system anticipated to be constructed will operate properly, or relieve any person now of hereafter owning, controlling or using such system from any liability resulting from the failure of the system to operate properly.

***NOTICE: This system shall not be installed while soils are in a wet condition.**

Permitted Design Flow: Existing GPD

Liquid Capacity of Septic Tank: 1500 gallons

Site LTAR: NA GPD/ft² (For new installations only.)

Liquid Capacity of Dosing Tank: NA gallons

Drainfield Design ☑ N/A

Trench Depth: _____ inches

Trench Width: _____ feet

Line Spacing: _____ feet (O.C.)

Total line length: _____ feet

# of Lines: _____ @ _____ feet

Depth of Media: _____ inches (Type) _____

Distribution Device: _____

Bed Design *(For Repair Installations ONLY.)* ☑ N/A

Bed Depth: _____ inches

Bed Width: _____ feet

Total line length: _____ feet

# of Lines: _____ @ _____ feet

Depth of Media: _____ inches (Type) _____

Distribution Device: _____

Water Supply Source

☐ Municipal ☐ Private Well ☐ Community Well

☐ Other _____

Minimum System Setbacks


Distance from Building Foundation: _____ feet

Distance from Property Line: _____ feet

Distance from Water Supply Source: _____ feet

SKETCH OF SYSTEM LAYOUT
(Proposed Layout)

Replace Septic Tank
w/ 1500 Gal

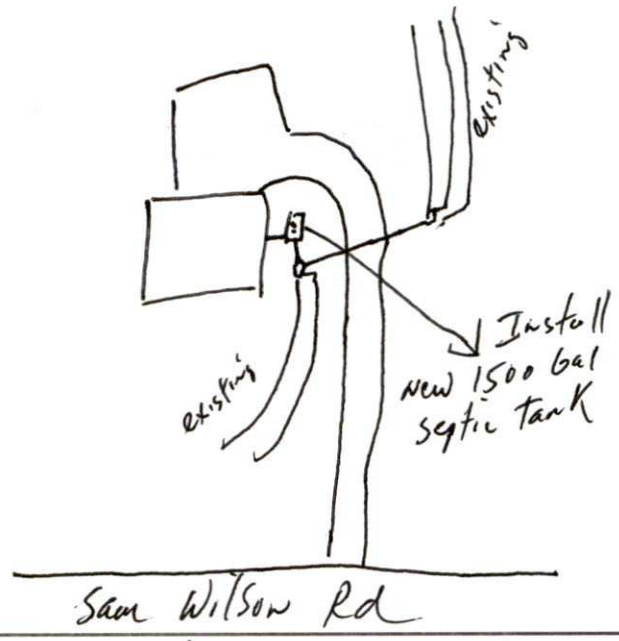

Comments: System Classification & Type: Replace septic Tank only and reconnect to drainfield

DENR Authorized Agent: Philo Walker Signature: Philo Walker RS

Mecklenburg County Groundwater & Wastewater Services
700 N. Tryon St., Suite 211 Charlotte, NC 28202
Phone: (704) 336-5103 Fax: (704) 336-6894

NC DENR
Division of Environmental Health
On-Site Wastewater Section

OPERATION PERMIT for an ON-SITE WASTEWATER TREATMENT & DISPOSAL SYSTEM

File #: 6464B Permit #: 4471 Tax Parcel #: 05521145

Property Owner: Cordell & Alison Hough

Job Location Address: 2027 Sam Wilson Rd

City: Charlotte State: NC Zip Code: 28214

Operation Permit Issuance Date: 3/1/10 Contractor Name: Stanley

Permitted Design Flow: Existing GPD

Liquid Capacity of Septic Tank: 1500 gallons

Liquid Capacity of Dosing Tank: N/A gallons

Effluent Pump Model: N/A

Drainfield Installation ☒ N/A

Trench Depth: _____ inches

Trench Width: _____ feet

Line Spacing: _____ feet (O.C.)

Total line length: _____ feet

# of Lines: _____ @ _____ feet

Depth of Media: _____ inches (Type) _____

Depth of Cover: _____ inches

Distribution Device: _____

Bed Installation *(For Repair Installations ONLY.)* ☒ N/A

Bed Depth: _____ inches

Bed Width: _____ feet

Total line length: _____ feet

# of Lines: _____ @ _____ feet

Depth of Media: _____ inches (Type) _____

Depth of Cover: _____ inches

Distribution Device: _____

Water Supply Source

☐ Municipal ☒ Private Well ☐ Community Well

☐ Other _____

System Installation Setbacks

Distance from Building Foundation: _____ feet

Distance from Property Line: _____ feet

Distance from Water Supply Source: _____ feet

Inspection Dates

Tank(s) Inspected: 3/1/10

Excavation Inspected: N/A

Pump & Controls Inspected: N/A

SKETCH OF SYSTEM INSTALLATION
(As-Built Drawing)

* Installed according to installion Approval design *

The undersigned has inspected the Septic Tank System described above, and certifies it has been ☐ installed ☐ altered ☒ repaired ☐ as detailed in the plot above ☐ in accordance with the permit issued and meets the provisions of 15A NCAC 18A. 1900, "Laws and Rules for Sewage Treatment and Disposal Systems" in effect on the date of issuance of the permit. The issuance of this Operation Permit does not in any way guarantee that the system will operate properly or relieve any person now or hereafter owning, controlling, or using such system from any liability resulting from the failure of the system to operate properly. This document is issued subject to those restrictions and conditions shown on the permit(s) and the provisions of 15A NCAC 18A. 1900 in addition to those listed below under "Comments." This document shall be null and void if any information contained in the application is untrue or if any additions are made to the property which would increase the requirements for said system.

Notice: Disturbance of the designated repair area may result in the Suspension or Revocation of this permit.

Comments: System Classification & Type: Repair of Septic tank to existing system New Septic tank Replacement Sheaf 775 P.T-352 STB-390 7/19

DENR Authorized Agent: Jason Jackson Signature: Jason Jackson

Mecklenburg County Groundwater & Wastewater Services
700 N. Tryon St., Suite 211 Charlotte, NC 28202
Phone: (704) 336-5103 Fax: (704) 336-6894

NC DENR
Division of Environmental Health
On-Site Wastewater Section

OPERATION PERMIT for an
ON-SITE WASTEWATER TREATMENT & DISPOSAL SYSTEM

File #: 6464 B Permit #: 4471 Tax Parcel #: 055-211 45

Property Owner: Cordell & Alison Hough

Job Location Address: 2027 Sam Wilson Rd

City: Charlotte State: NC Zip Code: 28214

OPERATION PERMIT CONDITIONS:

I. Performance: System shall perform in accordance with 15A NCAC 18A .1961.

II. Monitoring: System shall be monitored as required by 15A NCAC 18A .1961.

III. Maintenance: Ground absorption sewage treatment and disposal systems shall be checked, and the contents of the septic tank removed, periodically from all compartments, to ensure proper operation of the system. The contents shall be pumped whenever the solids level is found to be more than 1/3 of the liquid depth in any compartment.

IV. Operation: System shall be operated in accordance with 15A NCAC 18A .1961.

System Classification: IIa existing

*Operation Permits for Type V and VI systems expire five (5) years from the date of issuance (in accordance with Table V(a)). The system owner must contact GWS six (6) months prior to expiration for permit renewal.

Subsurface system operator required: Yes ☐ No ☒

☐ This type of system requires the system owner to maintain a contract with a certified operator to perform system inspection, maintenance, and reporting as required in 15A NCAC 18A .1961. and Table V(a). The system owner is responsible for all fees associated with these services.

☒ System does not require inspection by GWS on a routine frequency.

☐ System requires inspection by GWS once every five (5) years. The system owner is responsible for all fees associated with the inspection.

☐ System requires inspection by GWS once every three (3) years. The system owner is responsible for all fees associated with the inspection.

☐ System requires inspection by GWS once every twelve (12) months. The system owner is responsible for all fees associated with the inspection.

☐ System requires inspection by GWS once every six (6) months. The system owner is responsible for all fees associated with the inspection.

V. Other: Replacement of septic tank to existing system

DENR Authorized Agent: Jason Jackson Date: 3/1/10

Signature: Jason Jackson