Mecklenburg County Groundwater & Wastewater Services
700 N. Tryon St., Suite 211 Charlotte, NC 28202
Phone: (704) 336-5103 Fax: (704) 336-6894

NC DENR
Division of Environmental Health
On-Site Wastewater Section

OPERATION PERMIT for an ON-SITE WASTEWATER TREATMENT & DISPOSAL SYSTEM

File #: 8628B Permit #: 5922 Tax Parcel #: 017-276-11

Property Owner: Gregorio Montoya

Job Location Address: 9116 Cheyenne Drive

City: Huntersville State: NC Zip Code: 28078 (FIELD) (TANK) / ADAN GARCIA

Operation Permit Issuance Date: 4/17/13 Contractor Name: Robbie Ray

Permitted Design Flow: 360 GPD / 1500

Liquid Capacity of Septic Tank: ~~Existing~~ gallons

Liquid Capacity of Dosing Tank: N/A gallons

Effluent Pump Model: N/A

Drainfield Installation ☑ N/A

Trench Depth: _____ inches

Trench Width: _____ feet

Line Spacing: _____ feet (O.C.)

Total line length: _____ feet

# of Lines: _____ @ _____ feet

Depth of Media: _____ inches (Type) _____

Depth of Cover: _____ inches

Distribution Device: _____

Bed Installation *(For Repair Installations ONLY.)* ☐ N/A

Bed Depth: 36 inches

Bed Width: 12 feet

Total line length: 160 feet

# of Lines: 4 @ 40 feet

Depth of Media: 24 inches (Type) TCHP

Depth of Cover: 12 inches

Distribution Device: D-BOX

Water Supply Source

☑ Municipal ☐ Private Well ☐ Community Well

☐ Other _____

System Installation Setbacks

Distance from Building Foundation: >5' feet

Distance from Property Line: >10' feet

Distance from Water Supply Source: >100' feet


Inspection Dates

Tank(s) Inspected: 4/17/13

Excavation Inspected: 2/8/13

Pump & Controls Inspected: N/A

SKETCH OF SYSTEM INSTALLATION
(As-Built Drawing)

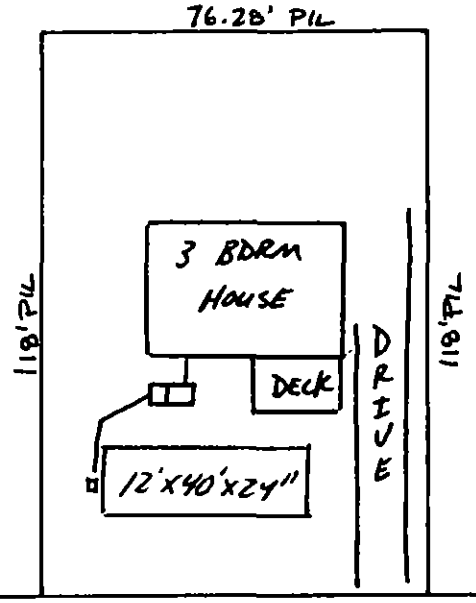

Cheyenne Drive

The undersigned has inspected the Septic Tank System described above, and certifies it has been ☐ installed ☐ altered ☑ repaired ☑ as detailed in the plot above ☑ in accordance with the permit issued and meets the provisions of 15A NCAC 18A. 1900, "Laws and Rules for Sewage Treatment and Disposal Systems" in effect on the date of issuance of the permit. The issuance of this Operation Permit does not in any way guarantee that the system will operate properly or relieve any person now or hereafter owning, controlling, or using such system from any liability resulting from the failure of the system to operate properly. This document is issued subject to those restrictions and conditions shown on the permit(s) and the provisions of 15A NCAC 18A. 1900 in addition to those listed below under "Comments." This document shall be null and void if any information contained in the application is untrue or if any additions are made to the property which would increase the requirements for said system.

Notice: Disturbance of the designated repair area may result in the Suspension or Revocation of this permit.

Comments: System Classification & Type: IIa, GRAVITY, TCHP, NA, NA

DENR Authorized Agent: Tommy Michelle Reeks Signature: Tommy Michelle Reeks

* WHILE INSPECTING THE TANK INSTALLATION IT WAS EVIDENT THAT A CURTAIN DRAIN WAS NOT NEEDED – GUTTERS MUST BE INSTALLED.

Mecklenburg County Groundwater & Wastewater Services
700 N. Tryon St., Suite 211 Charlotte, NC 28202
Phone: (704) 336-5103 Fax: (704) 336-6894

NC DENR
Division of Environmental Health
On-Site Wastewater Section

OPERATION PERMIT for an
ON-SITE WASTEWATER TREATMENT & DISPOSAL SYSTEM

File #: 8628B Permit #: 5922 Tax Parcel #: 017-276-11

Property Owner: Gregorio Montoya

Job Location Address: 9116 Cheyenna Drive

City: Huntersville State: NC Zip Code: 28078

OPERATION PERMIT CONDITIONS:

I. Performance: System shall perform in accordance with 15A NCAC 18A .1961.

II. Monitoring: System shall be monitored as required by 15A NCAC 18A .1961.

III. Maintenance: Ground absorption sewage treatment and disposal systems shall be checked, and the contents of the septic tank removed, periodically from all compartments, to ensure proper operation of the system. The contents shall be pumped whenever the solids level is found to be more than 1/3 of the liquid depth in any compartment.

IV. Operation: System shall be operated in accordance with 15A NCAC 18A .1961.

System Classification: IIa

*Operation Permits for Type V and VI systems expire five (5) years from the date of issuance (in accordance with Table V(a)). The system owner must contact GWS six (6) months prior to expiration for permit renewal.

Subsurface system operator required: Yes ☐ No ☑

☐ This type of system requires the system owner to maintain a contract with a certified operator to perform system inspection, maintenance, and reporting as required in 15A NCAC 18A .1961. and Table V(a). The system owner is responsible for all fees associated with these services.

☑ System does not require inspection by GWS on a routine frequency.

☐ System requires inspection by GWS once every five (5) years. The system owner is responsible for all fees associated with the inspection.

☐ System requires inspection by GWS once every three (3) years. The system owner is responsible for all fees associated with the inspection.

☐ System requires inspection by GWS once every twelve (12) months. The system owner is responsible for all fees associated with the inspection.

☐ System requires inspection by GWS once every six (6) months. The system owner is responsible for all fees associated with the inspection.

V. Other: 2013 ALTERATION

DENR Authorized Agent: Jeremy Micklave, REHS Date: 4/17/13

Signature: Jeremy Micklave REHS

Mecklenburg County Groundwater & Wastewater Services
700 N. Tryon St., Suite 211 Charlotte, NC 28202
Phone: (704) 336-5103 Fax: (704) 336-6894

NC DENR
Division of Environmental Health
On-Site Wastewater Section

INSTALLATION APPROVAL for an
ON-SITE WASTEWATER TREATMENT & DISPOSAL SYSTEM

File #: 8628B Permit #: 5922 Tax Parcel #: 017-276-11

Property Owner: GREGORIO MONTOYA

Job Location Address: 9116 Cheyenne DRIVE

City: HUNTERSVILLE State: NC Zip Code: 28078

Installation Approval Issuance Date: 12/6/12

Permission is hereby given to ☐ install ☐ alter ☒ repair an on-site wastewater treatment & and disposal system, with subsurface soil absorption and effluent discharge, as specified herein at the described location. This approval is granted based upon the application information submitted to our office. All work shall be completed on or before BEFORE C.O., after which date this approval shall be null and void. The system shall meet all of the construction requirements of 15A NCAC 18A. 1900 which are in effect on the date of granting this approval. An **Operation Permit** must be obtained from the Mecklenburg County Health Department before any system can be covered up or placed into service. The issuance of this permit does not in any way guarantee that the system anticipated to be constructed will operate properly, or relieve any person now of hereafter owning, controlling or using such system from any liability resulting from the failure of the system to operate properly.

***NOTICE: This system shall not be installed while soils are in a wet condition.**

Permitted Design Flow: 360 GPD

Liquid Capacity of Septic Tank: ~~Existing~~ 1500 gallons

Site LTAR: 0.3 GPD/ft² (For new installations only.)

Liquid Capacity of Dosing Tank: NA gallons

Drainfield Design ☒ N/A

Trench Depth: _____ inches

Trench Width: _____ feet

Line Spacing: _____ feet (O.C.)

Total line length: _____ feet

# of Lines: _____ @ _____ feet

Depth of Media: _____ inches (Type) _____

Distribution Device: _____

Bed Design *(For Repair Installations ONLY.)* ☐ N/A

Bed Depth: 36 inches

Bed Width: 12 feet

Total line length: 200 feet

# of Lines: 4 @ 50 feet

Depth of Media: 24 inches (Type) TIRE CHIPS

Distribution Device: D-Box

Water Supply Source

☒ Municipal ☐ Private Well ☐ Community Well

☐ Other _____


Minimum System Setbacks

Distance from Building Foundation: >5' feet

Distance from Property Line: >5' feet

Distance from Water Supply Source: >100' feet

SKETCH OF SYSTEM LAYOUT
(Proposed Layout) SCALE = 1" = 30'

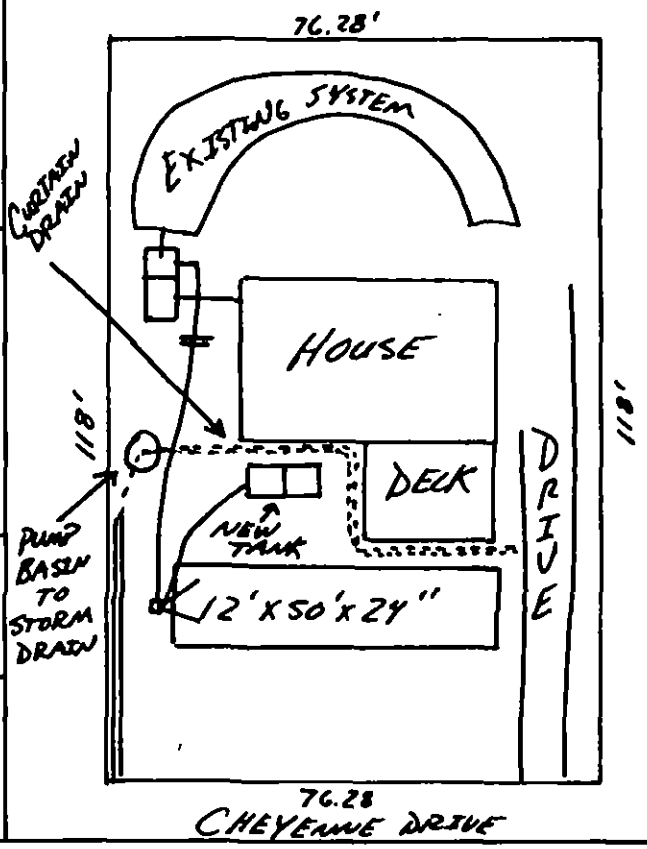

Comments: System Classification & Type: TYPE IIa CONVENTIONAL SYSTEM

OVER-FLOW TO THE NEW SYSTEM AFTER FEEDING THE EXISTING FIELD.

DENR Authorized Agent: Jeremy Mickelone REHS Signature: Jeremy Mickelone REHS

* WHILE CONDUCTING THE FINAL INSPECTION - IT WAS EVIDENT THAT A NEW TANK NEEDED TO BE SET AS WELL AS A CURTAIN DRAIN ABOVE THE SYSTEM TO CAPTURE GROUND WATER

DENR/DEH

ON-SITE WASTEWATER SECTION

Sheet ___ *of* ___
PROPERTY ID #: _____
COUNTY: _____

SOIL/SITE EVALUATION
for ON-SITE WASTEWATER SYSTEM

OWNER: GREGORIO MONTOYA
ADDRESS: 9116 Cheyenne Drive
PROPOSED FACILITY: Residence
PROPOSED DESIGN FLOW (.1949): 360
LOCATION OF SITE: 9116 Cheyenne Drive
WATER SUPPLY: • Private • Public • Well • Spring • Other _____
EVALUATION METHOD: • Auger Boring • Pit • Cut

APPLICATION DATE 11/20/12
DATE EVALUATED: 12/3/12
PROPERTY SIZE: _____
PROPERTY RECORDED: 1970's
TYPE OF WASTEWATER: • Sewage • Industrial Process • Mixed

PROFILE #	.1940 LANDSCAPE POSITION/ SLOPE %	HORIZON DEPTH (IN.)	SOIL MORPHOLOGY (.1941) .1941 STRUCTURE/ TEXTURE	SOIL MORPHOLOGY (.1941) .1941 CONSISTENCE/ MINERALOGY	OTHER PROFILE FACTORS .1942 SOIL WETNESS/ COLOR	OTHER PROFILE FACTORS .1943 SOIL DEPTH	OTHER PROFILE FACTORS .1956 SAPRO CLASS	OTHER PROFILE FACTORS .1944 RESTR HORIZ	PROFILE CLASS & LTAR
1	LS 5%	0-2	GR/SCL	FR/SS/SP/SOMP	>48" TO SOFT WATER	48"	NA	NA	P.S. IV 0.36/D/FT²
		2-36	SBK/C	FI/S/P/SOMP					
		36-48	SBK/CL	FI/S/P/SOMP					
2									
3									
4									

DESCRIPTION	INITIAL SYSTEM	REPAIR SYSTEM
Available Space (.1945)	PS	PS
System Type(s)	IIa	IIa
Site LTAR	0.3	0.3

OTHER FACTORS (.1946): P.S.
SITE CLASSIFICATION (.1948): P.S.
EVALUATED BY: Jacob Pressley, LSS, Eric Bailey, LSS
OTHER(S) PRESENT: Jeremy Mackey, REHS

COMMENTS: Jeremy Mackey REHS

LEGEND

use the following standard abbreviations

LANDSCAPE POSITION	GROUP	SOIL TEXTURE	CONVENTIONAL 1955 LTAR*	LPP 1957 LTAR*	MINERALOGY/ CONSISTENCE	STRUCTURE
CC (Concave Slope)	I	S (Sand)	1.2 - 0.8	0.6 - 0.4	NEXP (Non-expansive)	G (Single Grain)
CV (Convex Slope)		LS (Loamy Sand)			SEXP (Slightly Expansive)	M (Massive)
D (Drainage Way)					EXP (Expansive)	CR (Crumb)
DS (Debris Slump)	II	SL (Sandy Loam)	0.8 - 0.6	0.4 - 0.3		GR (Granular)
FP (Flood Plain)		L (Loam)				SBK (Subangular Blocky)
FS (Foot Slope)						ABK (Angular Blocky)
H (Head Slope)	III	Si (Silt)	0.6 - 0.3	0.3 - 0.15		PL (Platy)
L (Linear Slope)		SiCL (Silty Clay Loam)				PR (Prismatic)
N (Nose Slope)		CL (Clay Loam)				
R (Ridge)		SCL (Sandy Clay Loam)			**MOIST**	**WET**
S (Shoulder Slope)		SiL (Silt Loam)				
T (Terrace)					VFR (Very Friable)	NS (Non-sticky)
	IV	SC (Sandy Clay)	0.4 - 0.1	0.2 - 0.05	FR (Friable)	SS (Slightly Sticky)
		SiC (Silty Clay)			FI (Firm)	S (Sticky)
		C (Clay)			VFI (Very Firm v. Very Sticky)	VS (Very Sticky)
		O (Organic)	None	None	EFI (Extremely Firm)	NP (Non-plastic)
						SP (Slightly Plastic)
						P (Plastic)
						VP (Very Plastic)

*Adjust LTAR due to depth, consistence, structure, soil wetness, landscape, position, wastewater flow and quality.


NOTES

HORIZON DEPTH	In inches below natural soil surface
DEPTH OF FILL	In inches from land surface
RESTRICTIVE HORIZON	Thickness and depth from land surface
SAPROLITE	S(suitable) or U(unsuitable)
SOIL WETNESS-	Inches from land surface to free water or inches from land surface to soil colors with chroma 2 or less - record Munsell color chip designation
CLASSIFICATION	S (Suitable), PS (Provisionally Suitable), or U (Unsuitable)

Evaluation of saprolite shall be by pits.

Long-term Acceptance Rate (LTAR): gal/day/ft^2

Show profile locations and other site features (dimensions, reference or benchmark, and North).

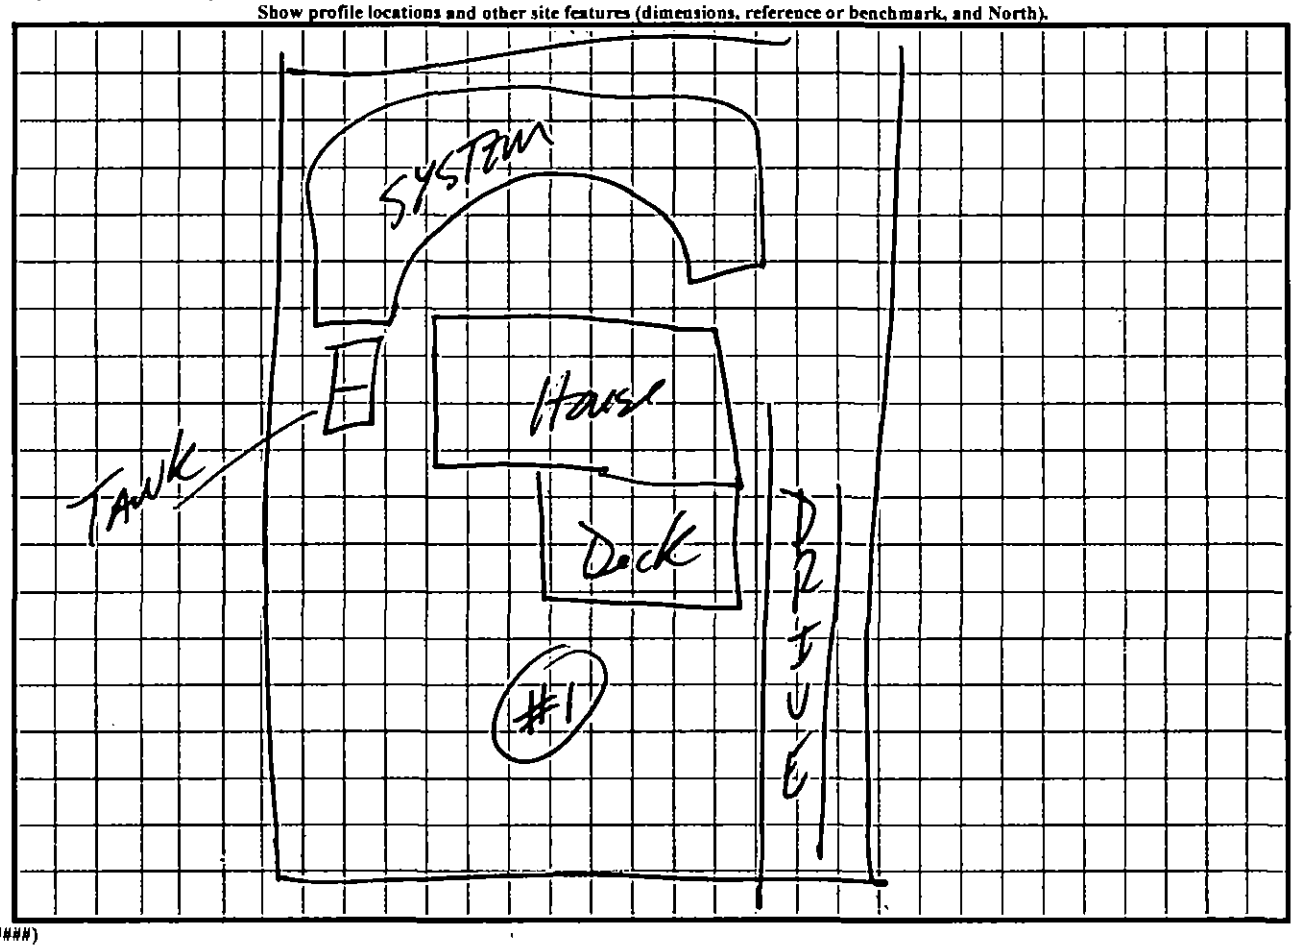

DENR (######)

Review (######)

322931

8628B

MECKLENBURG COUNTY HEALTH DEPARTMENT Rpp# 5922

APPLICATION FOR A RESIDENTIAL SITE IMPROVEMENT PERMIT/ CONSTRUCTION AUTHORIZATION FOR AN ON-SITE WASTEWATER SYSTEM, NEW WELL INSTALLATION, OR REPAIR OF EXISTING WELL

1. SEPTIC / TYPE APPLICATION: ○ N/A ○ NEW SYSTEM ☑ ALTERATION ○ REPAIR ○ MODIFIED PLOT PLAN

2. WELL / TYPE APPLICATION: ○ N/A ○ NEW WELL ☑ MAJOR REPAIR ○ ABANDONMENT

3. JOB LOCATION INFORMATION:
TAX PARCEL NUMBER: 01727611
STREET ADDRESS: 9116 Cheyenne Dr
CITY: Huntersville
STATE: NC ZIP: 28078
SUBDIVISION NAME: Huntington
LOT #: 233 LOT SIZE (acres): _____
TOWNSHIP:
○ MECKLENBURG ○ CORNELIUS ☑ HUNTERSVILLE
○ DAVIDSON ○ CHARLOTTE ○ PINEVILLE
○ MATTHEWS ○ MINT HILL

4. BUILDING INFORMATION:
BUILDING TYPE:
○ SINGLE MOBILE HOME ○ MODULAR HOME
☑ DOUBLE WIDE ○ MULTIPLE FAMILY
○ HOUSE ○ OTHER _____
HEATED SQUARE FOOTAGE: _____
NUMBER OF BEDROOMS: 3
NUMBER OF OCCUPANTS: _____
FOUNDATION TYPE:
○ CONCRETE SLAB ○ BASEMENT WITH PLUMBING
☑ CRAWL SPACE ○ BASEMENT WITH NO PLUMBING

5. IF PLANNING TO EXPAND OR ALTER THE EXISTING SEPTIC SYSTEM PLEASE COMPLETE THE FOLLOWING SECTION: ☐ N/A

NUMBER OF BEDROOMS TO BE ADDED: 0 NUMBER OF ADDITIONAL OCCUPANTS IN THE RESIDENCE: 0

6. WATER SUPPLY: ○ MUNICIPAL ○ PRIVATE WELL ☑ PUBLIC WELL ○ SHARED WELL ○ OTHER _____

7. PROPOSED USE OF WELL: ○ N/A ○ IRRIGATION ☑ POTABLE (DRINKING WATER) ○ OTHER _____

8. PLEASE INDICATE AND RANK DESIRED SEPTIC SYSTEM TYPE(S) IN ORDER OF PREFERENCE *(1-MOST DESIRED 5-LEAST DESIRED)*:

☐ N/A ☐ ANY TYPE ☐ CONVENTIONAL ☐ ACCEPTED ☐ INNOVATIVE ☐ ALTERNATIVE ☐ OTHER _____

8A. RANK: ____ ____ ____ ____ ____

9. DO ANY OF THE FOLLOWING APPLY TO THE PROPERTY IN QUESTION? IF "YES" PLEASE ATTACH SUPPORTING DOCUMENTATION.

BURIED CABLES, LANDFILLS, STUMPHOLES	○ YES ☑ NO	GRADING/SOIL REMOVAL PERFORMED	○ YES ☑ NO
EXISTING WASTEWATER (SEPTIC) SYSTEMS	☑ YES ○ NO	JURISDICTIONAL WETLANDS	○ YES ☑ NO
WELLS, SPRINGS, OR WATER LINES	○ YES ☑ NO	APPROVAL REQUIRED BY ANY OTHER PUBLIC AGENCY	○ YES ☑ NO
EASEMENTS OR RIGHT-OF-WAYS	○ YES ☑ NO	WASTEWATER OTHER THAN DOMESTIC SEWAGE	○ YES ☑ NO
CHEMICAL/PETROLEUM STORAGE TANKS	○ YES ☑ NO	KNOWN UNDERGROUND CONTAMINATION	○ YES ☑ NO
WASTE STORAGE	○ YES ☑ NO	GROUNDWATER USE RESTRICTIONS/VARIANCES	○ YES ☑ NO

10. WHAT DATE WAS THE PROPERTY ORIGINALLY DEEDED AND RECORDED? 2010 ☐ UNKNOWN

11. WHAT IS THE ANTICIPATED CLOSING DATE FOR THIS PROPERTY? _____ ☑ N/A

12. PROPERTY OWNER:
NAME: Gregorio Montoya
ADDRESS: 9716 Rodanthe Pl
CITY: Huntersville
STATE: NC ZIP: 28078
WORK PHONE: _____
MOBILE PHONE: 704-400-2170
FAX: _____
E-MAIL: _____

13. OWNER'S LEGAL REPRESENTATIVE, IF APPLICABLE:
NAME: _____
ADDRESS: _____
CITY: _____
STATE: _____ ZIP: _____
WORK PHONE: _____
MOBILE PHONE: _____
FAX: _____
E-MAIL: _____

MECKLENBURG COUNTY – GROUNDWATER & WASTEWATER SERVICES
700 N. TRYON ST. SUITE 211 CHARLOTTE, NC 28202, OFFICE: 704-336-5103, FAX: 704-336-6894

Revised on: 12/15/10

14. *SEPTIC SYSTEM PERMIT* APPLICATION:

If the information in this application is falsified, changed, or the site is altered, then the Improvement Permit and Authorization to Construct shall become invalid. I have read this application and certify that the information provided herein is true, complete and correct. Authorized county and state officials are granted right of entry to conduct necessary inspections to determine compliance with applicable laws and rules. I understand that I am solely responsible for the proper identification and labeling of all property lines and corners and making the site accessible so that a complete site evaluation can be performed. The permit is valid for either sixty (60) months or is non-expiring depending upon the documentation submitted: complete site plan = 60 months, complete plat = non-expiring.

GM (Initial here for septic system applications)

15. WELL PERMIT APPLICATION:

If the information in this application is falsified, changed, or the site is altered, then the Well Permit shall become invalid. I have read this application and certify that the information provided herein is true, complete and correct. Authorized county and state officials are granted right of entry to conduct necessary inspections to determine compliance with applicable laws and rules. I understand that I am solely responsible for the proper identification and labeling of all property lines and corners and making the site accessible so that a complete site evaluation can be performed. The permit is valid for a period of twelve (12) months from the date of issuance.

_____ (Initial here for well applications)

16. APPLICATION SIGNATURE SECTION:

ONLY COMPLETE APPLICATIONS WILL BE PROCESSED. A proper signature is required in order to process your application. Please review the application carefully and sign in the space provided below. A PROPOSED PLOT PLAN is required to be submitted with each application.

C Montague _____ 11/20/12

Property Owner's or Owner's Legal Representative Signature — Date

---

OFFICE USE ONLY

O SURVEY PLAT TO SCALE SUBMITTED O SCALED SITE PLAN SUBMITTED O UN-SCALED SITE PLAN SUBMITTED

SEPTIC APPLICATION FEE RECEIVED: $ _____ DATE FEE RECEIVED: _____

WELL APPLICATION FEE RECEIVED: $ _____ DATE FEE RECEIVED: _____

APPLICATION PROCESSED BY: lwa

GWS FILE NUMBER ASSIGNED: 8628B

APPLICATION ID NUMBER ASSIGNED: 5922

COMMENTS:

MECKLENBURG COUNTY – GROUNDWATER & WASTEWATER SERVICES
700 N. TRYON ST. SUITE 211 CHARLOTTE, NC 28202, OFFICE: 704-336-5103, FAX: 704-336-6894


File #: _____

PROPOSED PLOT PLAN

A drawing showing the locations of the following items is required: existing and proposed property lines with dimensions, easements or right-of-ways, proposed building pad(s) or existing building footprint(s), all appurtenances (garage, driveway, deck, pool, etc.), location of existing or proposed well(s), location of *existing or proposed* sewer lines and sewage disposal systems, surface water bodies, and any aboveground or underground storage tanks. Provide names for all roads that adjoin the property.

Street Address: 9116 Cheyenne Dr Tax Parcel #: 01727611

Subdivision Name: _____ Lot #: _____

 

_____ _____

Property Owner's or Owner's Legal Representative Signature Date

MECKLENBURG COUNTY – GROUNDWATER & WASTEWATER SERVICES
700 N. TRYON ST. SUITE 211 CHARLOTTE, NC 28202, OFFICE: 704-336-5103, FAX: 704-336-6894

Revised on: 12/15/10