

9830 ARLINGTON CHURCH RD

13929105

1/9/2008

duponbj

Groundwater and Wastewater Services File Imaging Project
May 2007
Barcode Font = IDAutomationHC39M

Mecklenburg County Health Department
Groundwater & Wastewater Services
700 N. Tryon St, Suite 211
Charlotte, NC 28202
Phone: (704) 336-5103
Fax: (704) 336-6894

PERMIT TO CONSTRUCT A WATER SUPPLY WELL

Permit #: 10000268 **File #:** 5909B **Tax Parcel #:** 139-291-05
Property Owner: MICHAEL R. MARTIN
Job Location Address: 9830 ARLINGTON CHURCH RD
City/ETJ: CHARLOTTE **State:** NC **Zip Code:** 28227
Permit Issuance Date: 2/9/2006
Use of Well: Potable
Type of Facility Served by Well: House
Sewage System Type: None

Area of Regulated Groundwater Usage Restrictions Apply: NO

Replacement for Existing Well: If Yes, see requirements in *Other Conditions of This Permit.*

General Conditions of This Permit:

- Water Supply Well construction must meet all requirements set forth in the *Mecklenburg County Groundwater Well Regulations* and any other applicable rules and laws.
- A North Carolina Certified Well Contractor must perform the well construction activities.
- The permitted Water Supply Well shall be located in accordance with the attached SITE PLAN.
- Any alteration of the site (including location of structures and appurtenances) or modification in use of the well, may subject this Permit to revocation.
- The Department will collect an initial sample of water from the Water Supply Well and analyze the sample for total coliform bacteria, nitrate, and nitrite. A review of the analysis by the Department must find the sample to meet the groundwater quality standards specified in Chapter 5 of the Mecklenburg County Groundwater Well Regulations before the Water Supply Well can be placed in service.
- This Permit shall be VALID for a period not to exceed 12 months from the date of issuance.

Specific Conditions of This Permit (Check all that apply):

☐ Grout must be placed the full extent of the casing. ☐ Casing to bedrock

☐ Initial water sample to taken and analyzed for (check all that apply):

☐ Volatile Organic Compounds (VOC's) ☐ Semi-volatile Compounds ☐ Metals (Specify in Other Conditions)

☐ Pesticides ☐ Herbicides ☐ Other (See Below)

The analysis must be submitted to the Department for review and approval prior to the Water Supply well being placed in service.

Other Conditions of This Permit:

DAVID CORNELIUS, RS
Authorized Agent: Print Name
Signature: 2/9/06

MICHAEL R. MARTIN
Owner/Legal Agent: Print Name
Signature:

268

LD 164637

GWS – RES. APP 07/05

SEPTIC FEE:
DATE:
CRT #:

PERMIT APPLICATION FOR A RESIDENTIAL SITE IMPROVEMENT PERMIT / CONSTRUCTION AUTHORIZATION FOR ON-SITE WASTEWATER SYSTEM NEW WELL INSTALLATION OR REPAIR OF EXISTING WELL
MECKLENBURG COUNTY GROUNDWATER & WASTEWATER SERVICES

WELL FEE: 400.00
DATE: 1/31/06
CRT #: 1410-JKA

FILE # 59098

SEPTIC / TYPE APPLICATION: ☐ NONE ☐ NEW SYSTEM ☐ ALTERATION ☐ REPAIR ☐ MODIFY PLOT PLAN

WELL / TYPE APPLICATION: ☐ NONE ☑ NEW WELL ☐ MAJOR REPAIR ☐ ABANDONMENT

JOB LOCATION INFORMATION:

TAX/PARCEL #: 139-291-05
STREET ADDRESS: 9530 ARLINGTON CHURCH RD
CITY: ~~CHARLOTTE~~ MINT HILL
STATE: NC ZIP: 28227
SUBDIVISION OR MOBILE HOME PARK NAME:
LOT #:
TOWNSHIP:

☐ 0-MECKLENBURG ☐ 4-PINEVILLE
☐ 1-CHARLOTTE ☐ 5-MATTHEWS
☐ 2-DAVIDSON ☐ 6-HUNTERSVILLE
☐ 3-CORNELIUS ☑ 7-MINT HILL

BUILDING INFORMATION:

TYPE OF BUILDING:

☐ SINGLE MOBILE HOME (S) ☐ MODULAR HOME (M)
☐ DOUBLE WIDE (D) ☐ MULTIPLE FAMILY (U)
☑ HOUSE (H) ☐ OTHER

HEATED SQUARE FOOTAGE: 3254
NUMBER OF BEDROOMS: 4
NUMBER OF OCCUPANTS: 2

FOUNDATION FOR RESIDENCE:

☐ CONCRETE SLAB ☐ BASEMENT WITH PLUMBING
☑ CRAWLSPACE ☐ BASEMENT WITH NO PLUMBING

IF PLANNING TO EXPAND/ALTER THE EXISTING SYSTEM INDICATE THE FOLLOWING CHANGES:

NUMBER OF BEDROOMS TO BE ADDED: NUMBER OF ADDITIONAL OCCUPANTS IN THE RESIDENCE:
WILL THERE BE A HOME BUSINESS IN THE RESIDENCE? ☐ YES ☐ NO TYPE:

WATER SUPPLY:

☐ MUNICIPAL (M) ☐ PUBLIC (C) ☑ PRIVATE WELL (P) ☐ SHARED WELL (S) ☐ OTHER 'SPRINGS' (O)

PROPOSED USE OF WELL: ☐ N/A ☐ IRRIGATION ☑ POTABLE ☐ GEOTHERMAL ☐ OTHER

ARE ANY OF THE FOLLOWING LOCATED ON THE PROPERTY? IF SO, PLEASE SHOW LOCATION ON SITE PLAN/PLAT.

BURIED CABLES, LANDFILLS, STUMPHOLES	☐ YES	☑ NO	WELLS, SPRINGS, OR WATER LINES	☐ YES	☑ NO
EXISTING WASTEWATER SYSTEMS	☐ YES	☑ NO	DESIGNATED WETLANDS	☐ YES	☑ NO
EASEMENTS OR RIGHT-OF-WAYS	☐ YES	☑ NO	GRADING/SOIL REMOVAL PERFORMED	☐ YES	☑ NO

PROPERTY OWNER:

NAME: MICHAEL R. MARTIN
ADDRESS: 7318 FRANCES IRENE DR
CITY: CHARLOTTE
STATE: NC ZIP: 28215
HOME PHONE: 704-532-6861 WORK PHONE:
MOBILE PHONE: 704-622-8294 FAX:

LEGAL AGENT FOR PROPERTY OWNER, IF APPLICABLE:

NAME:
ADDRESS:
CITY:
STATE: ZIP:
HOME PHONE: WORK PHONE:
MOBILE PHONE: FAX:

WHAT DATE WAS THE PROPERTY ORIGINALLY DEEDED AND RECORDED?

WHAT IS THE ANTICIPATED CLOSING DATE FOR THIS PROPERTY?

*An Improvement Permit is subject to suspension or revocation if site plans or the intended use change or if information submitted in this application is falsified or changed. The undersigned, owner, or legal agent for the owner, of the property described above as the "Job Location" has read the foregoing application, acknowledges that the contents of same are true, and authorizes the Mecklenburg County Health Department to enter onto the property for the purpose of processing this request.

Owner's/Agent's Signature Date

NORTH CAROLINA DEPARTMENT OF
ENVIRONMENT & NATURAL RESOURCES DIVISION
OF ENVIRONMENTAL HEALTH ON-SITE
WASTEWATER SECTION

*A Well Permit is subject to suspension or revocation if site plans or the intended use change or if information submitted in this application is falsified or changed. The undersigned, owner, or legal agent for the owner, of the property described above as the "Job Location" has read the foregoing application, acknowledges that the contents of same are true, and authorizes the Mecklenburg County Health Department to enter onto the property for the purpose of processing this request.

1-31-06

Owner's/Agent's Signature Date

MECKLENBURG COUNTY HEALTH DEPARTMENT
GROUNDWATER & WASTEWATER SERVICES
700 N. TRYON ST., SUITE 211
CHARLOTTE, NC 28202 704-336-5103 / FAX: 704-336-6894

PROPOSED PLOT PLAN

HEALTH DEPARTMENT
ENVIRONMENTAL HEALTH DIVISION
700 NORTH TRYON STREET
CHARLOTTE, NC 28202
PHONE (704) 336-5102

FILE: 59098

TC: 139-291-05

Draw in and name all roads adjoining the property. Draw in and accurately dimension the lot concerned. Accurately indicate property boundaries proposed and/or existing structures and driveways, underground utilities, and wells and springs within 100 feet of the proposed building or drainfield.

PERMIT FOR
9830 ARLINGTON CHURCH ROAD


SCALE 1" = 40'

① THIS IS A TYPE III-B,C SYSTEM UTILIZING AN EFFLUENT PUMP, AND IS REQUIRED BY STATE LAW TO BE INSPECTED AT LEAST ONCE EVERY 5 YEARS BY THE LOCAL HEALTH DEPT, WITH THE OWNER RESPONSIBLE FOR ANY FEES, AS DETERMINED BY THE MECK. CO. BOARD OF COMMISSIONERS

② USE A TYPE III-C ZONE/TRENCH INSTALLATION ACCEPTANCE, THAT ALLOWS FOR A 25% REDUCTION IN TOTAL LINEAR FEET

③ USE A PRESSURE MANIFOLD,

④ LOCATE ALL WELLS AT LEAST 50' FROM ALL PARTS OF SEPTIC SYSTEM, AND 25' FROM BUILDING FOUNDATION.

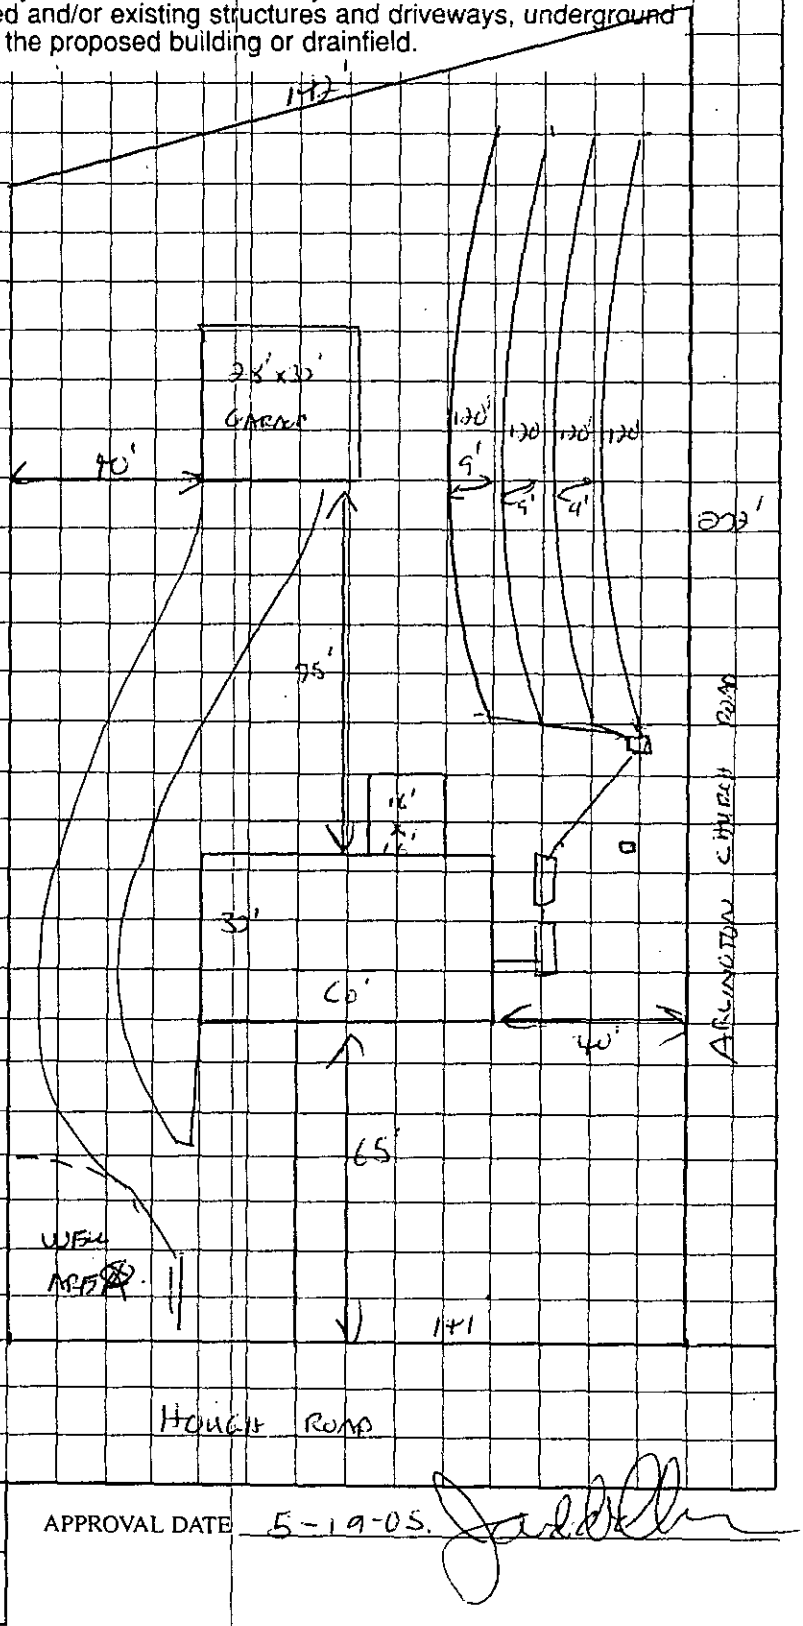

OWNER/AGENT SIGNATURE

DATE 1-30-06

APPROVAL DATE 5-19-05.

White - Health Department's Copy

Canary - E.H.S. Copy

Pink - Owner's Copy