

11958 CANTER LN

19724154

1/9/2008

duponbj

Groundwater and Wastewater Services File Imaging Project
May 2007
Barcode Font = IDAutomationHC39M

EHS CS/DC Reviewer

5991-B **County** Permit Review Worksheet

Rule or Law	Permit Application	1	2	3	4	5	6	7	8	9	10
.1937(d)	Is the Application complete	✓									
.1937(d)	Is there a Site plan/Plat with application	✓									
.1937(d)	Is the Facilityshown?	✓									
.1937(d)	Are appurtenances shown	✓									
	Site Evaluation Information										
.1939 (a)(1)	Topography and Landscape Position Recorded?	✓									
.1940 (a-g)	Slope % Recorded?	✓									
.1939 (a)(2)	Texture Class Recorded?	✓									
.1939 (a)(2)	Structure type Recorded?	✓									
.1939 (a)(2)	Consistence Recorded?	✓									
.1939 (a)(2)	Mineralogy Recorded?	✓									
.1939 (a)(3)	Soil Wetness Condition Recorded?	✓									
.1939 (a)(4)	Soil Depth to Rock or Parent Material Recorded When Encountered?	✓									
.1939 (a)(5)	Depth to Restrictive Horizons Recorded When Encountered?	✓									
.1939 (a)(6)	Sufficient Available Space Recorded?	✓									
.1937(m)	Are the Profile Locations Shown?	✓									
.1939(a) & .1945(b)	Are the S/PS Profiles in system & in repair area?	✓									
	Number of auger borings made:	✓									
	Were sufficient auger borings made?	✓									
.1939(d), .1955, .1956, .1957	LTAR	.3									
	IP/CA										
G.S. 130A-336(a) & .1937(g)	Proposed System Type stated-Initial	✓									
.1945(b)	Proposed System Type stated-Repair	✓									
G.S. 130A-336(a)(3)	System location identifiable by setbacks - Initial	✓									
.1937(g) & .1945(b)	System components shown - Initial	✓									
.1945(b)	Repair area shown	✓									
.1937 (f)(g)	Does System design match facility, flow & WW characteristics?	✓									
.1937 (f)(g)	**Is System design consistent with soil/site conditions?**	✓									
.1937 (f)(g)	Is the System located in the approved area?	✓									
G.S. 130A-336(a)	Is the Design flow (gpd) indicated?	✓									
G.S. 130A-336(a)	**Number of Bedrooms, employees, seats, etc. indicated?**	✓									
.1937(g)	Trench depth indicated?	✓									
.1937(g)	Trench width indicated?	✓									
.1937(g)	Trench length indicated?	✓									
G.S. 130A-336(a)(1)	Proposed/existing well shown?	✓									
G.S. 130A-336(a)(1)	Property line lengths shown?	✓									
G.S. 130A-336(a)	**Facility/appurtenance setbacks shown from fixed points?**	✓									
	OP										
.1937(i)	System type as described in table V(a) of rule .1961										
.1937(i)	Conditions for system performance, operation, maintenance, monitoring and reporting.										

If system design is incorrect or inconsistent with site conditions, indicate why for each below

Mecklenburg County Groundwater & Wastewater Services
700 N. Tryon St., Suite 211 Charlotte, NC 28202
Phone: (704) 336-5103 Fax: (704) 336-6894

NC DENR
Division of Environmental Health
On-Site Wastewater Section

OPERATION PERMIT for an
ON-SITE WASTEWATER TREATMENT & DISPOSAL SYSTEM

File #: 5991B Permit #: _____ Tax Parcel #: 195-241-54

Property Owner: NVR, Inc.

Job Location Address: 11458 CANTER LANE (LOT #1)

City: MINT HILL State: NC Zip Code: 28227

Operation Permit Issuance Date: 3/19/07 Contractor Name: RCS

Permitted Design Flow: 480 GPD

Liquid Capacity of Septic Tank: 1500 gallons

Liquid Capacity of Dosing Tank: N/A gallons

Effluent Pump Model: N/A

Drainfield Installation ☐ N/A

SEPTIC DRAINFIELD
3 LINES @ 3' x 90' = 270'

Trench Depth: 30 inches
Trench Width: 3 feet
Line Spacing: 9 feet (O.C.)
Total line length: 420 feet

WASHER DRAINFIELD
3 LINES @ 3' x 50' = 150'

# of Lines: _____ @ _____ feet
Depth of Media: 12 inches (Type) INNOVATIVE
Depth of Cover: 12 inches
Distribution Device: D-BOX

Inspection Dates
Tank(s) Inspected: 3/19/07
Excavation Inspected: 3/19/07
Pump & Controls Inspected: N/A

Bed Installation *(For Repair Installations ONLY.)* ☑ N/A
Bed Depth: _____ inches
Bed Width: _____ feet
Total line length: _____ feet
# of Lines: _____ @ _____ feet
Depth of Media: _____ inches (Type) _____
Depth of Cover: _____ inches
Distribution Device: _____

Water Supply Source
☑ Municipal ☐ Private Well ☐ Community Well
☐ Other _____

System Installation Setbacks
Distance from Building Foundation: 5 feet
Distance from Property Line: 10 feet
Distance from Water Supply Source: 10 feet

SKETCH OF SYSTEM INSTALLATION
(As-Built Drawing)

INSTALLED IN ACCORD. W/ INSTALLATION APPROVAL CMS 3-19-07

The undersigned has inspected the Septic Tank System described above, and certifies it has been ☑ installed ☐ altered ☐ repaired ☐ as detailed in the plot above ☑ in accordance with the permit issued and meets the provisions of 15A NCAC 18A. 1900, "Laws and Rules for Sewage Treatment and Disposal Systems" in effect on the date of issuance of the permit. The issuance of this Operation Permit does not in any way guarantee that the system will operate properly or relieve any person now or hereafter owning, controlling, or using such system from any liability resulting from the failure of the system to operate properly. This document is issued subject to those restrictions and conditions shown on the permit(s) and the provisions of 15A NCAC 18A. 1900 in addition to those listed below under "Comments." This document shall be null and void if any information contained in the application is untrue or if any additions are made to the property which would increase the requirements for said system.

Notice: Disturbance of the designated repair area may result in the Suspension or Revocation of this permit.

Comments: System Classification & Type: III g EZ Flow; SPLIT SYSTEM

DENR Authorized Agent: Chris Sherrill, RS, LSS Signature: Christopher M Sherrill

Mecklenburg County Groundwater & Wastewater Services
700 N. Tryon St., Suite 211 Charlotte, NC 28202
Phone: (704) 336-5103 Fax: (704) 336-6894

NC DENR
Division of Environmental Health
On-Site Wastewater Section

INSTALLATION APPROVAL for an
ON-SITE WASTEWATER TREATMENT & DISPOSAL SYSTEM

File #: 5991B Permit #: _____ Tax Parcel #: 195-241-54

Property Owner: NVR Inc.

Job Location Address: 11958 CANTER LANE (LOT #1)

City: ~~CHAR~~ MINT HILL State: NC Zip Code: 28227

Installation Approval Issuance Date: 3/8/07

Permission is hereby given to ☑ install ☐ alter ☐ repair an on-site wastewater treatment & and disposal system, with subsurface soil absorption and effluent discharge, as specified herein at the described location. This approval is granted based upon the application information submitted to our office. All work shall be completed on or before 4/9/07, after which date this approval shall be null and void. The system shall meet all of the construction requirements of 15A NCAC 18A .1900 which are in effect on the date of granting this approval. An **Operation Permit** must be obtained from the Mecklenburg County Health Department before any system can be covered up or placed into service. The issuance of this permit does not in any way guarantee that the system anticipated to be constructed will operate properly, or relieve any person now of hereafter owning, controlling or using such system from any liability resulting from the failure of the system to operate properly.

***NOTICE: This system shall not be installed while soils are in a wet condition.**

Permitted Design Flow: 480 GPD Site LTAR: 0.3 GPD/ft² (For new installations only.)

Liquid Capacity of Septic Tank: 1500 gallons Liquid Capacity of Dosing Tank: N/A gallons

Drainfield Design ☐ N/A

SEPTIC DRAINFIELD

Trench Depth: 30 inches

3 LINES @ 3'x90' 270'

Trench Width: 3 feet

Line Spacing: 9 feet (O.C.)

WASHER DRAINFIELD

Total line length: ~~420~~ feet

3 LINES @ 3'x50' 150'

75 GAL WASH-BOX

# of Lines: _____ @ _____ feet

Depth of Media: 12 inches (Type) INNOVATIVE

Distribution Device: D-BOX

Bed Design *(For Repair Installations ONLY.)* ☑ N/A

Bed Depth: _____ inches

Bed Width: _____ feet

Total line length: _____ feet

# of Lines: _____ @ _____ feet

Depth of Media: _____ inches (Type) _____

Distribution Device: _____

Water Supply Source

☑ Municipal ☐ Private Well ☐ Community Well

☐ Other _____


Minimum System Setbacks

Distance from Building Foundation: 5 feet

Distance from Property Line: 10 feet

Distance from Water Supply Source: 10 feet

SKETCH OF SYSTEM LAYOUT
(Proposed Layout)

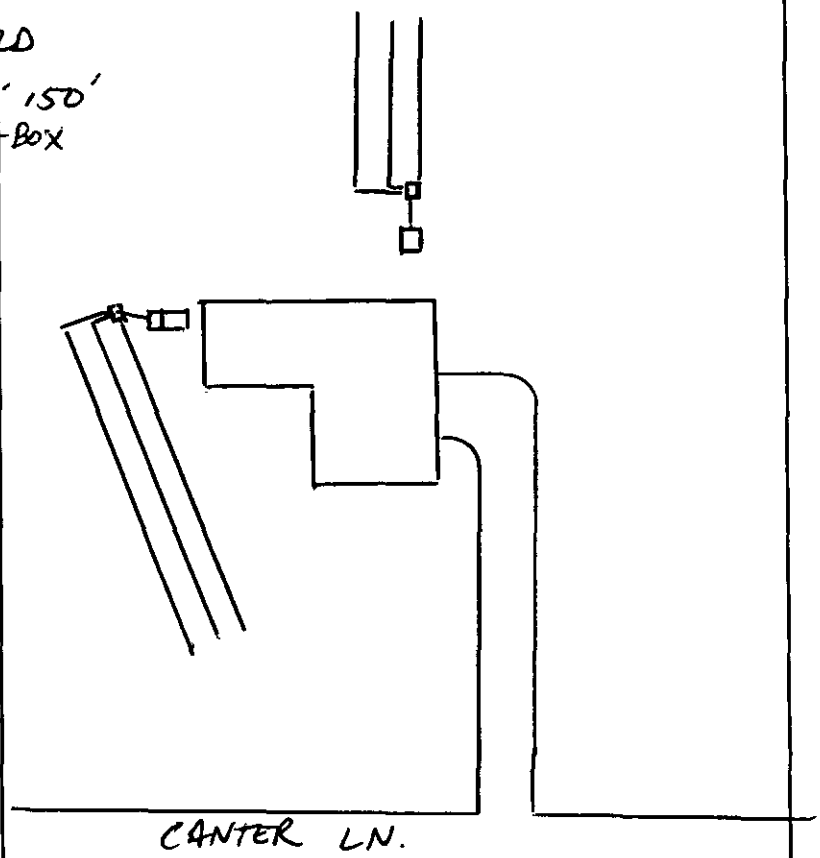


Comments: System Classification & Type: III g GRAVITY 25% REDUCTION

DENR Authorized Agent: Chris Sherrill, RS, LSS Signature: Christopher M Sherrill


PROPOSED MODEL FIT

PREPARED BY:
DELTA LAND SERVICES, INC.
6033 FLORENCE AVENUE, SUITE 100
CHARLOTTE, NORTH CAROLINA 28212
(704) 536-8190

MODEL FIT ONLY
NOT TO BE USED
FOR CONSTRUCTION
OR STAKING

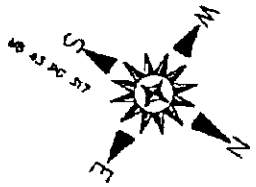

SCALE: 1"=40'

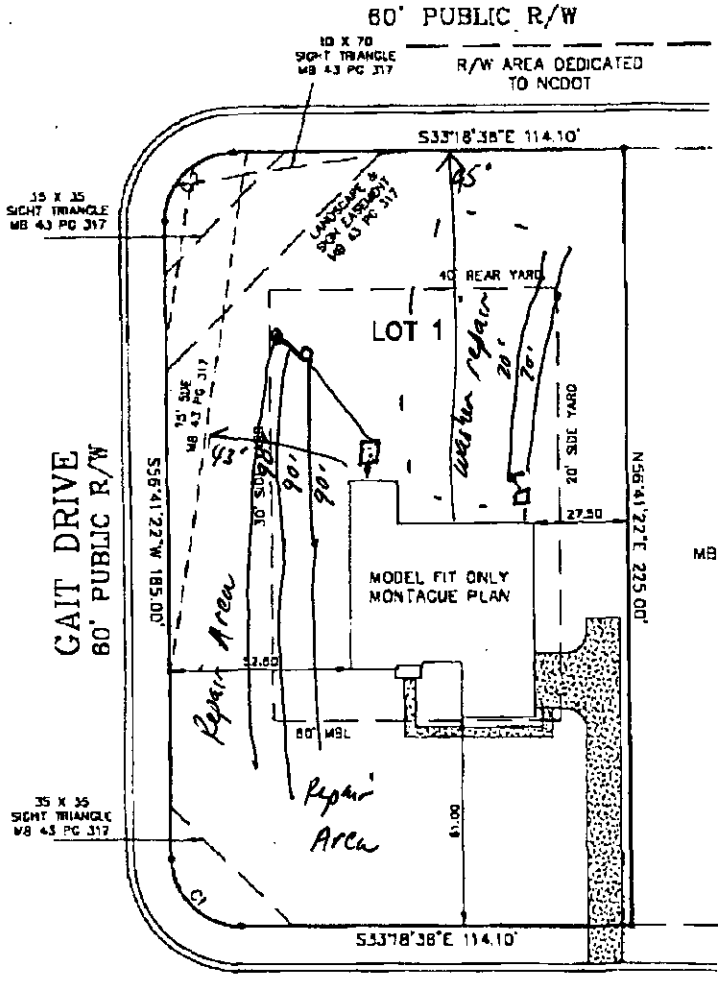

Curve Table					
CURVE	RADIUS	LENGTH	CHORD	BEARING	DELTA
C1	20.00'	31.42'	28.28'	N11°41'22"E	90°00'00"
C2	20.00'	31.42'	28.28'	S78°18'38"E	90°00'00"

NOT FOR RECORDATION, CONVEYANCES OR SALES

Subdivision THE MEADOWS OF MINT HILL, MAP 1 County Mecklenburg
Address 11958 Canter Lane Owner Ryan Homes
Lot 1 Block ___ Plan Montague Elevation B Drive (Left) ___ (Right) Side (Courtyard) ___ Deck ___
Patio ___ Fireplace ___ Garage (1 Car) ___ (2 Car) X (3 Car) ___ Brick Front Basement ___ Curtain Wall X
Crawl ___ Slab ___ Other Morning Room

REVISED: DWN: TLM CKD: [illegible] DATE: 5 / 5 / 05

C:\MEADOWS\MM-0001.DWG - TLM

COMMENTS

4 Bedroom Residence
Innovative Septic System Approval Agreement forms shall be recorded and on file prior to Cons. Metho. release
Septic Tank 1500 Gal
septic Drainfield
3 lines x 90' long x 3' wd 270'
Washer drainfield
Dakeher box, 2 lines x 20' long x 3' wd 140'
Municipal water

Patrice Garner

5991B
9/6/05

Proj. No. 212222

FILE COPY	
FILED FOR REGISTRATION	DOC. # 861923
DATE 8/29/05	TIME 3:37 pm
BOOK 19255	PAGE 984
STAMPS	REC FEE 20.00
JUDITH A. GIBSON REGISTER OF DEEDS MECKLENBURG COUNTY, NC	

STATE OF NORTH CAROLINA

COUNTY OF MECKLENBURG

WASTEWATER TREATMENT AND DISPOSAL SYSTEM DESIGN AGREEMENT: 15A NCAC 18A .1948 AND ANY OF THE FOLLOWING RULES: .1956; .1957(a); .1957(b); or .1957(c); OR .1969

MA1001

FILE # 5991B
PARCEL # 19724154

The undersigned, NUR, INC DBA Ryan Homes, owner of property located at 11938 Canterfare, (the "site") and described in an instrument recorded in Book 43 at Page 317, Mecklenburg Public Registry, hereby acknowledges that the undersigned applied to the Mecklenburg County Health Department (the "Department") for a permit to install a septic tank sewage disposal system on the site; that the Department evaluated the site for suitability for such a system in accordance with the regulations promulgated by the North Carolina Commission for Health Services as 15A NCAC 18A .1900 et seq.; that the Department originally classified the site as "unsuitable" pursuant to the standards set forth in the regulations; that the undersigned requested that the Department reclassify the site as "provisionally suitable" in light of the particular septic tank system proposed by the undersigned; that the Department considered various studies, data, and other information which indicate to the Department that the septic tank system proposed by the undersigned is allowed by the rules; and that the Department therefore reclassified the site as "provisionally suitable" and issued an appropriate permit for such proposed septic tank system.

The undersigned further acknowledges that the proper design, construction, operation and maintenance of such septic tank system is the responsibility of the designer, owner, developer, installer, or user of the system, as applicable, and that neither the Department nor its officials, employees, or agents warrant or guarantee that the said system installed pursuant to the permit issued by the Department will function in a satisfactory manner for any given period of time or that the Department, its officials, employees or agents assume any liability for any damages of any kind which are caused, or which may be caused, by a malfunction of such system.

The undersigned further acknowledges that the following conditions will apply to the site:

This instrument was prepared by: NUR, INC DBA Ryan Homes
Mail after recording to: 10815 David Taylor Dr
Charlotte, NC 28262

X335975

FEE: 300.00
DATE: 9/6/05
JKA

AUTHORIZATION FOR WASTEWATER SYSTEM CONSTRUCTION

212222

LD

PERMIT NUMBER: 5991B
PARCEL NUMBER: 197-241-54

JOB LOCATION ADDRESS: 11958 CATER LANE, LOT 1
PROPERTY OWNER: NVR, INC.
BUILDING CONTRACTOR: RYAN HOMES
SUBDIVISION NAME: MEADOWS OF MINT HILL
AUTHORIZATION ISSUED BY: PHILO WALKER DATE: 09/06/05

Philo Walker Pes 9/6/05
DENR/DEH AUTHORIZED AGENT

AUTHORIZATION CONDITIONS

1. WASTEWATER SYSTEM CONSTRUCTION AND INSTALLATION MUST MEET ALL CONDITIONS AND SPECIFICATIONS AS SET FORTH IN IMPROVEMENT PERMIT NUMBER 5991B, AND THE ATTACHED SITE PLAN WITH SYSTEM DETAILS. CONSTRUCTION AND INSTALLATION MUST ALSO MEET ALL REQUIREMENTS SET FORTH IN THE RULES GOVERNING SANITARY SEWAGE COLLECTION, TREATMENT, AND DISPOSAL AND ANY OTHER APPLICABLE RULES AND LAWS.

2. AN *INSTALLATION, CONSTRUCTION, ALTERATION AND/OR REPAIR APPROVAL* MUST BE SECURED PRIOR TO INSTALLATION OF THE SEPTIC TANK SYSTEM. THE INSTALLER OF THE SYSTEM SHALL BE A REGISTERED SEPTIC TANK CONTRACTOR WITH THE MECKLENBURG COUNTY HEALTH DEPARTMENT.

3. ANY ALTERATION IN SITE OR SOIL CONDITIONS (INCLUDING LOCATION OF STRUCTURES AND APPURTENANCES) OR MODIFICATION IN USE, DESIGN WASTEWATER FLOW, OR WASTEWATER CHARACTERISTICS AS SPECIFIED IN THE ASSOCIATED IMPROVEMENT PERMIT AND APPLICATION, MAY SUBJECT THIS CONSTRUCTION AUTHORIZATION AND ASSOCIATED PERMIT(S) TO REVOCATION.

4. THIS CONSTRUCTION AUTHORIZATION AS PROVIDED IN G.S. 130A-335(f) AND G.S. 130A-336(b) SHALL BE VALID FOR A PERIOD EQUAL TO THE VALIDITY OF THE IMPROVEMENT PERMIT, NOT TO EXCEED 60 MONTHS.

5. OTHER CONDITIONS:
   AGREEMENT FORMS REQUIRED

CONDITIONS OF IMPROVEMENT PERMIT / CONSTRUCTION AUTHORIZATON

Permit Number: **5991B** Tax Number: **195-241-54**

- The IMPROVEMENT PERMIT is subject to revocation if site plans or the intended use change. There is to be **NO** grading, filling, or disturbance of the soil in the area of the septic tank system or repair area.
- CONSTRUCTION AUTHORIZATION must be obtained prior to receiving a Building Permit. The Construction Authorization is **NOT** transferable. Do not clear, grade, fill or disturb soil prior to obtaining a Construction Authorization.
- Domestic-type wastewater only. No industrial process wastewater may be discharged into the system.

Basement: ☐ Yes ☒ No ☐ Partial Basement

Primary Wastewater System

Type: ☐ I ☐ II ☒ III ☐ IV ☐ V ☐ VI

☐ Conventional
☐ Prefabricated, permeable block panel system
☐ Shallow Placed Conventional
☐ Low Pressure Pipe
☐ Large Diameter Pipe
☐ Fill
☐ Other
☒ Innovative or Experimental:

.3 Long-term acceptance rate (GPD/ft^2)	480 Max gallons/day wastewater flow	1200 Absorption Area (ft^2)	9 Trench spacing (min. on centers) (ft)
Serviced by private well: ☐ Yes ☒ No	1500 Gallon septic tank	400 Total trench length (ft)	30 Maximum trench depth (in) (At least 12" of provisionally suitable soil must remain between trench bottom and unsuitable soil conditions.)
4 Bedrooms in residence	NA Gallon pump tank	NA Depth of stone (in)	

Any surface water present: **NO** Type: Minimum separation distance (ft):

Additional conditions: **INNOVATIVE SEPTIC SYSTEM APPROVAL, AGREEMENT FORMS REQUIRED**

Repair Area System

Type: ☐ I ☐ II ☒ III ☐ IV ☐ V ☐ VI

☐ Conventional
☐ Prefabricated, permeable block panel system
☐ Shallow Placed Conventional
☐ Low Pressure Pipe
☐ Large Diameter Pipe
☐ Fill
☐ Other
☒ Innovative or Experimental:

1200 Absorption Area (ft^2) 400 Total trench length (ft)	NA Depth of stone (in)	9 Trench spacing (min. on centers) (ft)	30 Maximum trench depth (in)

The undersigned, an authorized agent of the MECKLENBURG COUNTY HEALTH DEPARTMENT, certifies that the Department has approved the Request for the Job Location contained in this document. The approval is granted in accordance with the provisions of Laws and Rules For Sewage Treatment, and Disposal Systems in effect at the time of issuance of the permit and is subject to the following provisions:

*** No work shall be conducted on the septic tank system until an Installation, Construction, Alteration and/or Repair Approval is granted by this Department.

*** This Improvement permit is transferable.

Phillip J Walker RS 9/6/05
DENR Authorized Agent Date

Patrice Garner 9/6/05
Owner/Agent Signature Date

MECKLENBURG COUNTY HEALTH DEPARTMENT
ENVIRONMENTAL HEALTH DIVISION
700 N. TRYON ST., SUITE 211
CHARLOTTE, NC 28202
PHONE: (704) 336-5103
FAX: (704) 336-6894

NC DENR
DIVISION OF ENVIRONMENTAL HEALTH
ON-SITE WASTEWATER SECTION

Department of Environment, Health, and Natural Resources
Division of Environmental Health
On-site Wastewater Section

Sheet: 1 of 2
Property ID # 197-241-54
Lot #: 1
File #: 5991B
Code: 2

ACS

SOIL/SITE EVALUATION
for ON-SITE WASTEWATER SYSTEM

Owner: NVR, Inc.
Applicant: Kim Stanley
Address: 10815 David Taylor Drive, Ste. 100, Charlotte, N. C. 28262
Date Evaluated: 7/6/2005
Proposed Facility: Residence
Design Flow (.1949): 600gpd
Property Size: .69a
Location of Site: 11958 canter Lane
Property Recorded:
Water Supply: [x] Public [ ] Individual [ ] Well [ ] Spring [ ] Other
Evaluation Method: [x] Auger Boring [ ] Pit [ ] Cut
Type of Wastewater: [x] Sewage [ ] Industrial Process [ ] Mixed

PROFILE #	.1940 Landscape Position/ Slope%	Horizon Depth (IN.)	SOIL MORPHOLOGY .1941 .1941 Structure/ Texture	.1941 Consistence Mineralogy	OTHER PROFILE FACTORS .1942 Soil Wetness/ Color	.1943 Soil Depth (IN.)	.1956 Sapro Class	.1944 Restr Horiz	Profile Class & LTAR
1	LS, 12	0-5	GR/CL	FR/SEXP/SS/SP	>48" TO SOIL WETNESS	48+	N/A	NONE	PS, IV .3GPD/FT^2
		5-41	SBK/C	FI/SEXP/S/P					
		41-48	SBK/CL	FR/SEXP/SS/SP					
2	LS, 8	0-7	GR/CL	"	"	"	"	"	"
		7-48	SBK/C	FI/SEXP/S/P					
3	"	0-4	GR/CL	FR/SEXP/SS/SP	"	"	"	"	"
		4-48	SBK/ABK/C	FI/SEXP/S/P					
4	LS, 6	0-6	SBK/CL	FR/SEXP/SS/SP	"	"	"	"	"
		6-48	SBK/ABK/C	FI/SEXP/S/P					

Description	Initial System	Repair System
Available Space (.1945)	PS	PS
System Type(s)	III g	III g
Site LTAR	.3GPD/FT^2	.3GPD/FT^2


Other Factors (.1946):
Site Classification (.1948): [redacted] PROV. SUITABLE
Evaluated By: W. R. Marlin, LSS, 7/8/2005, W. R. Marlin
Others Present:

COMMENTS:
100% repair

Landscape Position	Group	Texture	.1955 LTAR	Structure
R-Ridge	I	S-Sand	1.2 - 0.8	SG-Single Grain
SS-Shoulder Slope		LS-Loamy Sand		M-Massive
LS-Linear Slope				CR-Crumb
FS-Food Slope	II	SL-Sandy Loam	0.8 - 0.6	GR-Granular
NS-Nose Slope		L-Loam		SBK-Subangular Blocky
HS-Head Slope				ABK-Angular Blocky
CC-Concave Slope	III	SI-Silt	0.6 - 0.3	PL-Platy
CV-Convex Slope		SICL-Silty Clay Loam		PR-Prismatic
T-Terrace		CL-Clay Loam		
FP-Flood Plain		SCL-Sandy Clay Loam		
	IV	SC-Sandy Clay	0.4 - 0.1	
		SIC-Silty Clay		
		C-Clay		

Consistence Moist	Consistence Wet	Mineralogy
VFR-Very Friable	NS-Non-Sticky	SEXP-Slightly Expansive
FR-Friable	SS-Slightly Sticky	EXP-Expansive
FI-Firm	S-Sticky	
VFI-Very Firm	VS-Very Sticky	
EFI-Extremely Firm	NP-Non-Plastic	
	SP-Slightly Plastic	
	P-Plastic	
	VP-Very Plastic	

Sketch of Soil Evaluation Locations

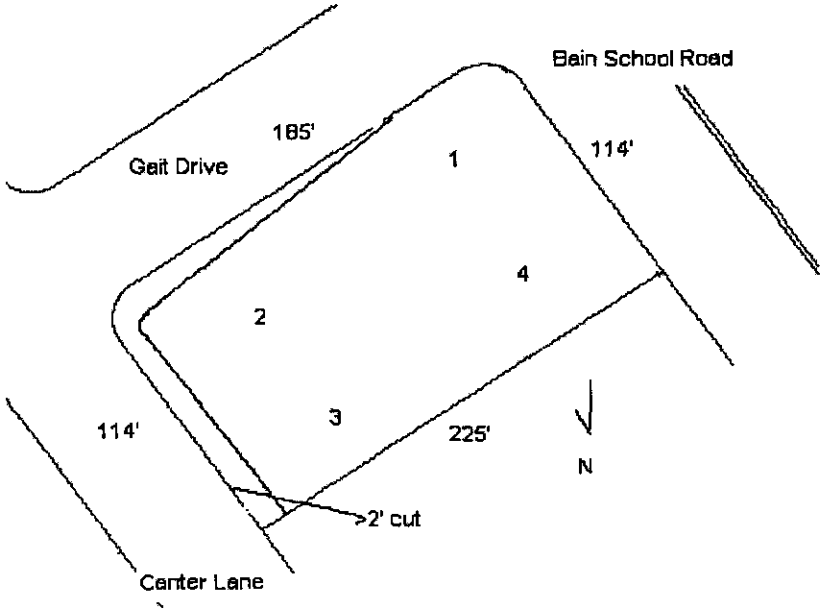

#1744 MA 1001 Drive Right

GWS – RES. APP 12/04

SEPTIC FEE: 200 X acct 33575
DATE: 5/5/05
CRT [ ]

PERMIT APPLICATION FOR A RESIDENTIAL SITE IMPROVEMENT PERMIT / CONSTRUCTION AUTHORIZATION FOR ON-SITE WASTEWATER SYSTEM NEW WELL INSTALLATION OR REPAIR OF EXISTING WELL MECKLENBURG COUNTY GROUNDWATER & WASTEWATER SERVICES

FILE # 5991B

WELL FEE: _____
DATE: _____
CRT [ ]

SEPTIC / TYPE APPLICATION: ☐ NONE ☒ NEW SYSTEM EXISTING SYSTEM: ☐ EXPANSION/ALTERATION ☐ REPAIR

WELL / TYPE APPLICATION: ☒ NONE ☐ NEW WELL ☐ MAJOR REPAIR ☐ ABANDONMENT

JOB LOCATION INFORMATION:

TAX/PARCEL #: 19724154
STREET ADDRESS: 11958 Cauler Lane
CITY: Mint Hill
STATE: NC ZIP: 28227
SUBDIVISION OR MOBILE HOME PARK NAME: Meadows of Mint Hill
LOT #: 1
TOWNSHIP:

☐ 0-MECKLENBURG ☐ 4-PINEVILLE
☐ 1-CHARLOTTE ☐ 5-MATTHEWS
☐ 2-DAVIDSON ☐ 6-HUNTERSVILLE
☐ 3-CORNELIUS ☒ 7-MINT HILL

BUILDING INFORMATION:

TYPE OF BUILDING:

☐ SINGLE MOBILE HOME (S) ☐ MODULAR HOME (M)
☐ DOUBLE WIDE (D) ☐ MULTIPLE FAMILY (U)
☒ HOUSE (H) ☐ OTHER

HEATED SQUARE FOOTAGE: 3,500
NUMBER OF BEDROOMS: 5 4
NUMBER OF OCCUPANTS: 4

FOUNDATION FOR RESIDENCE:

☐ CONCRETE SLAB ☐ BASEMENT WITH PLUMBING
☒ CRAWLSPACE ☐ BASEMENT WITH NO PLUMBING

IF PLANNING TO EXPAND/ALTER THE EXISTING SYSTEM INDICATE THE FOLLOWING CHANGES:

NUMBER OF BEDROOMS TO BE ADDED: NUMBER OF ADDITIONAL OCCUPANTS IN THE RESIDENCE:
WILL THERE BE A HOME BUSINESS IN THE RESIDENCE? ☐ YES ☒ NO TYPE:

WATER SUPPLY:

☒ MUNICIPAL (M) ☐ PUBLIC (C) ☐ PRIVATE WELL (P) ☐ SHARED WELL (S) ☐ OTHER 'SPRINGS' (O)

PROPOSED USE OF WELL: ☒ N/A ☐ IRRIGATION ☐ POTABLE ☐ GEOTHERMAL ☐ OTHER

ARE ANY OF THE FOLLOWING LOCATED ON THE PROPERTY? IF SO, PLEASE SHOW LOCATION ON SITE PLAN/PLAT.

BURIED CABLES, LANDFILLS, STUMPHOLES	☐ YES	☒ NO	WELLS, SPRINGS, OR WATER LINES	☐ YES	☒ NO
EXISTING WASTEWATER SYSTEMS	☐ YES	☒ NO	DESIGNATED WETLANDS	☐ YES	☒ NO
EASEMENTS OR RIGHT-OF-WAYS	☒ YES	☐ NO	GRADING/SOIL REMOVAL PERFORMED	☐ YES	☒ NO

PROPERTY OWNER:

NAME: NVR, INC.
ADDRESS: 10815 David Taylor Dr., Ste 100
CITY: Charlotte
STATE: NC ZIP: 28262
HOME PHONE: WORK PHONE: 548-3534
MOBILE PHONE: FAX:

LEGAL AGENT FOR PROPERTY OWNER, IF APPLICABLE:

NAME: Kim Stanley
ADDRESS: PO Box 176
CITY: Stanfield
STATE: NC ZIP: 28163
HOME PHONE: 752-9639 WORK PHONE:
MOBILE PHONE: 791-6852 FAX: 752-9639

WHAT DATE WAS THE PROPERTY ORIGINALLY DEEDED AND RECORDED? April 2005
WHAT IS THE ANTICIPATED CLOSING DATE FOR THIS PROPERTY? August 2005

*An Improvement Permit is subject to suspension or revocation if site plans or the intended use change or if information submitted in this application is falsified or changed. The undersigned, owner, or legal agent for the owner, of the property described above as the "Job Location" has read the foregoing application, acknowledges that the contents of same are true, and authorizes the Mecklenburg County Health Department to enter onto the property for the purpose of processing this request.

Kim Stanley 5/4/05
Owner's/Agent's Signature Date

NORTH CAROLINA DEPARTMENT OF
ENVIRONMENT & NATURAL RESOURCES DIVISION
OF ENVIRONMENTAL HEALTH ON-SITE
WASTEWATER SECTION

*A Well Permit is subject to suspension or revocation if site plans or the intended use change or if information submitted in this application is falsified or changed. The undersigned, owner, or legal agent for the owner, of the property described above as the "Job Location" has read the foregoing application, acknowledges that the contents of same are true, and authorizes the Mecklenburg County Health Department to enter onto the property for the purpose of processing this request.

Owner's/Agent's Signature Date

MECKLENBURG COUNTY HEALTH DEPARTMENT
GROUNDWATER & WASTEWATER SERVICES
700 N. TRYON ST., SUITE 211
CHARLOTTE, NC 28202
704-336-5103 / FAX: 704-336-6894


MA1001 Drive Right

File # 5991B
Date

Mecklenburg County
Land Use & Environmental Service Agency
Groundwater & Wastewater Services
700 N. Tryon St., Suite 211
Charlotte, NC 28202
Phone: (704) 336-5103
Fax: (704) 336-8894

PROPOSED PLOT PLAN

A map showing existing and proposed property lines and easements with dimensions, the location of the single family residence, non-single family residence, or other facility, and appurtenances, the site for the proposed well, and the location of existing or proposed sewer lines and/or sewage disposal systems, surface water bodies, aboveground or underground storage tanks. Name all roads adjoining the property. If this a repair indicate the type of repair.

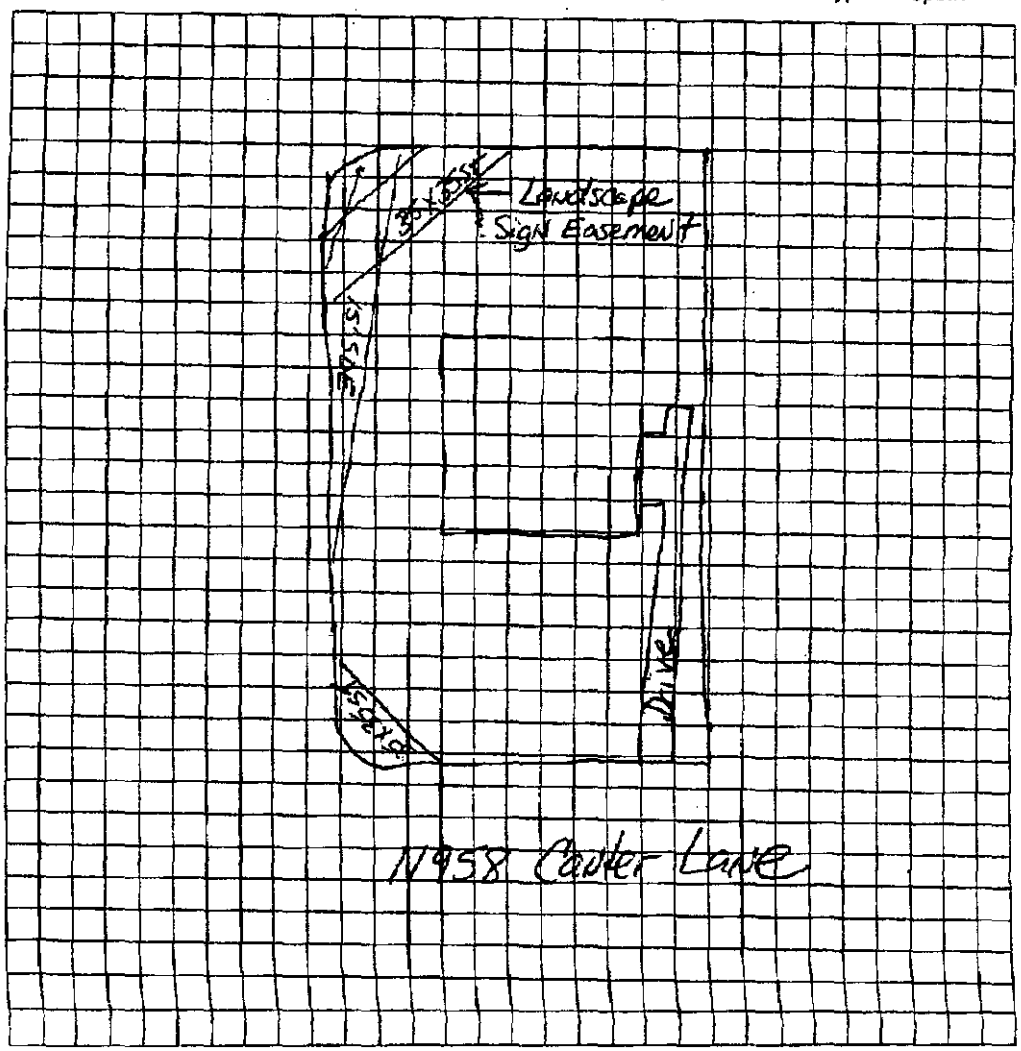

Owner/Agent Signature Kim Stanley
Date 5/4/05

LBC 12/15/04