

2519 BRIAR TRAIL CT

21512145

5/23/07

duponbj

Groundwater and Wastewater Services File Imaging Project
May 2007
Barcode Font = IDAutomationHC39M

4788A

APPLICATION FOR IMPROVEMENT PERMIT FOR RESIDENTIAL SITE INDIVIDUAL WATER AND WASTEWATER SYSTEMS PROGRAM

FEE: DATE: PERMIT #:

SITE APPLICATION: NEW SYSTEM EXPANSION/ALTERATION OF EXISTING SYSTEM REPAIR OF EXISTING SYSTEM

NORTH CAROLINA
DEPARTMENT OF ENVIRONMENT, HEALTH, AND NATURAL RESOURCES
DIVISION OF ENVIRONMENTAL HEALTH
ON-SITE WASTEWATER SECTION

PROPERTY INFORMATION (SEE INSTRUCTIONS TO FILL OUT IF YOU NEED HELP)

TAX/PARCEL NUMBER: 21512145

STREET ADDRESS: 2519 Briar Trail Court

SUBDIVISION OR MOBILE HOME PARK NAME: Blackberry Ridge

LOT NUMBER: 58 Phase II 1989

TYPE OF BUILDING (CHECK ONE):

- ___ SINGLE MOBILE HOME (S)
- ___ DOUBLE WIDE (D)
- ✓ HOUSE (H)
- ___ MODULAR HOME (M)
- ___ MULTIPLE FAMILY (U)
- ___ OTHER (O)

HEATED SQUARE FOOTAGE: 1336

NUMBER OF BEDROOMS: 3 NUMBER OF OCCUPANTS: 2

FOUNDATION FOR RESIDENCE:

- ✓ WITHOUT BASEMENT ON SLAB
- ___ CRAWL SPACE
- ___ WITH BASEMENT /PLUMBING
- ___ WITH BASEMENT /NO PLUMBING

TOWNSHIP (CHECK ONE):

- ___ 0 MECKLENBURG
- ___ 1 CHARLOTTE
- ___ 2 DAVIDSON
- ___ 3 CORNELIUS
- ___ 4 PINEVILLE
- ✓ 5 MATTHEWS
- ___ 6 HUNTERSVILLE
- ___ 7 MINT HILL

CLOSING DATE: ASAP

IF EXPANSION/ALTERATION OF EXISTING SYSTEM, DESCRIBE THE PROPOSED BUILDING ADDITION: Repair

WILL THERE BE A HOME BUSINESS IN THE RESIDENCE: ___ YES X NO TYPE: _____

WATER SUPPLY (CHECK ONE):

- ___ COMMUNITY (C)
- ___ MUNICIPAL (M)
- X PRIVATE WELL (P)
- ___ SHARED WELL (S)
- ___ OTHER 'SPRINGS' (O)

IF ANY OF THE FOLLOWING ARE LOCATED ON THE PROPERTY, PLEASE SHOW LOCATION ON PLAT:

BURIED CABLES, LANDFILLS, STUMPHOLES	___ YES ✓ NO	WELL, SPRINGS OR WATERLINES	___ YES ✓ NO
EXISTING WASTEWATER SYSTEMS	___ YES ✓ NO	DESIGNATED WETLANDS	___ YES ✓ NO
EASEMENTS OR RIGHT-OF-WAYS	✓ YES ___ NO		

PROPERTY OWNER:

NAME: (LAST) DMC Rental Company, INC (FIRST) (MI)

ADDRESS: P.O. Box 350

CITY: Mineral Springs STATE: NC ZIP: 28108

DAYTIME PHONE: ( ) 704 - 843-2182

LEGAL AGENT FOR PROPERTY OWNER, IF APPLICABLE:

NAME: (LAST) (FIRST) (MI)

DAYTIME PHONE: ( ) —

WHAT DATE WAS THE PROPERTY ORIGINALLY DEEDED AND RECORDED? 6/20/88

An Improvement Permit is subject to suspension or revocation if site plans or the intended use change or if information submitted in this application is falsified or changed. The undersigned, owner, or legal agent for the owner, of the property described above as the "Job Location" has read the foregoing application, acknowledges that the contents of same are true, and authorizes agents of the Mecklenburg County Health Department to enter onto the property for the purpose of processing this request.

DATE: 4/16/03

SIGNED: Dan L Moser


MECKLENBURG COUNTY HEALTH DEPARTMENT
ENVIRONMENTAL HEALTH DIVISION
c/o HAL MARSHALL CTR., SUITE 211, 700 N. TRYON ST., CHARLOTTE, N.C. 28202., (704) 336-5102

THIS IS TO CERTIFY THAT ON THE 20 DAY OF JUNE 19 89 I SURVEYED THE PROPERTY SHOWN ON THIS PLAT, AND THAT THE TITLE LINES AND THE WALLS OF THE BUILDINGS IF ANY ARE SHOWN HEREON.

FOUNDATION LOCATION: 24 MAY 1989

SIGNED Walter L Gordon
REGISTERED SURVEYOR

I have consulted the Federal Emergency Management Agency flood map and determined the property shown is not in a special flood hazard zone.

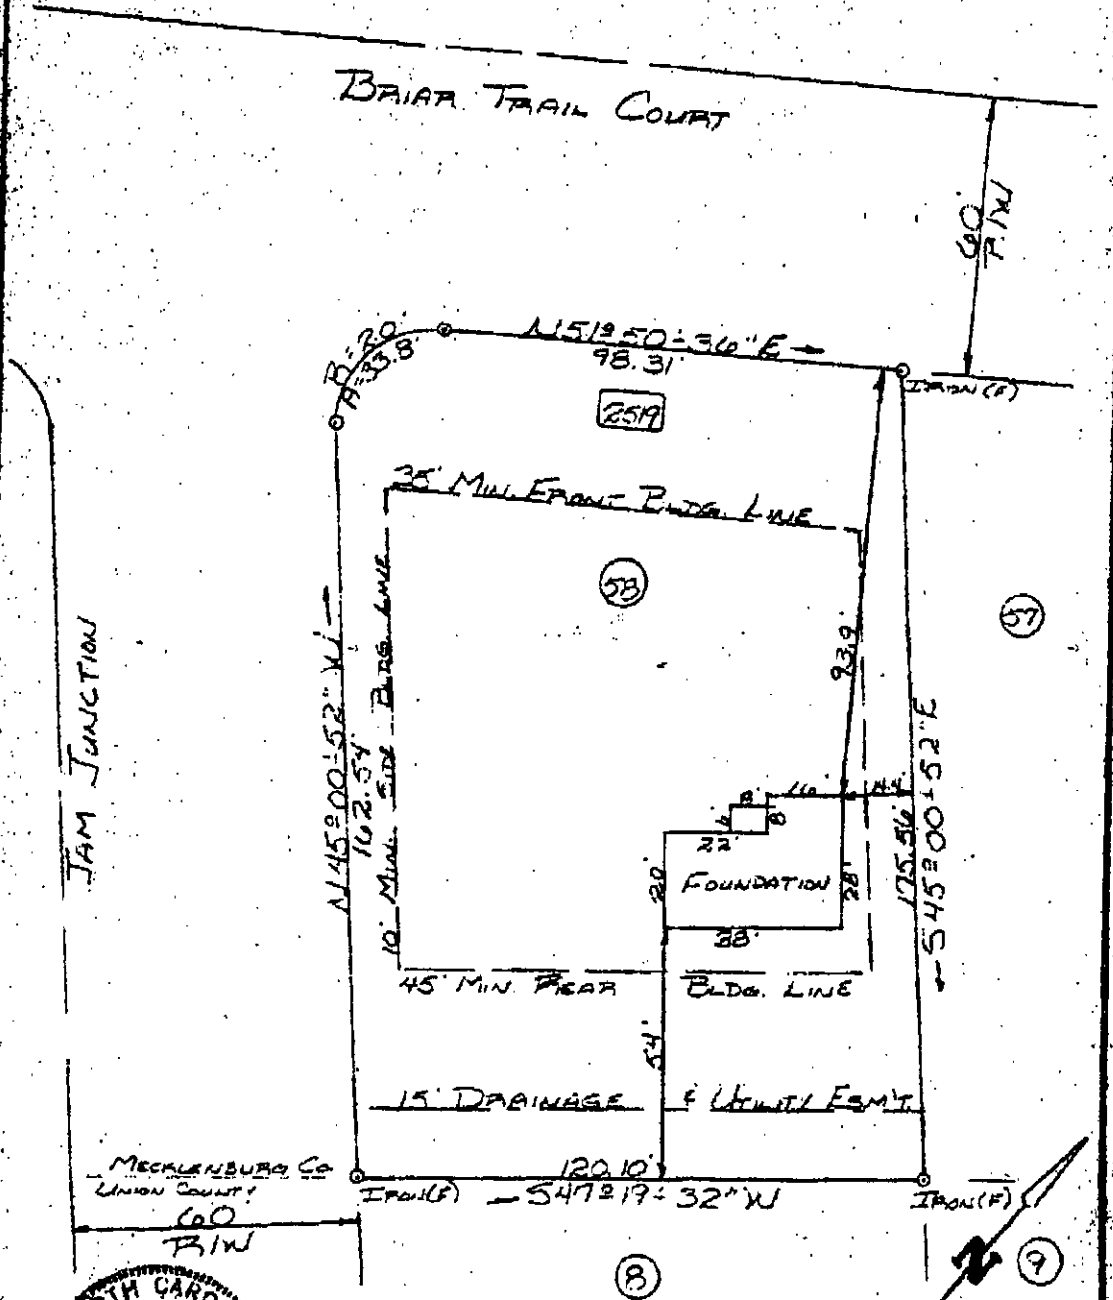

NORTH CAROLINA REGISTERED SEAL L-1372 LAND SURVEYOR WALTER L. GORDON

BLACKBERRY RIDGE, PHASE I
UNION CO. REG. P.C.B-385A

FOUNDATION SURVEY
OF
2519 BRIAR TRAIL COURT
#58 BLACKBERRY RIDGE, PHASE II

SCALE 1" = 30'

THE PROPERTY OF DAN L. MOSER CONST. & REALTY CO, INC.

MAP RECORDED IN BOOK 22 AT PAGE 599 DEED RECORDED IN BOOK PAGE

MORNINGSTAR TWSP. MECKLENBURG CO. NORTH CAROLINA