

11200 MCCOY RD

01527132

7/14/08

marliwr

Groundwater and Wastewater Services File Imaging Project
May 2007
Barcode Font = IDAutomationHC39M

INDIVIDUAL WATER AND WASTEWATER SYSTEMS PROGRAM
APPLICATION FOR SERVICES

[ ] CRT

Mecklenburg County Health Dept.
Environmental Health Division
c/o Hal Marshall Ctr., Suite 211
700 N. Tryon St.
Charlotte, NC 28202

(704)336-5102 14718

Date:

PERSON FILING APPLICATION:
NAME: KERNS (last) HENRY (first) W (mi)
ADDRESS: 6501 HAZELTON PHONE: 704 553-8732
CITY: Charlotte STATE: NC ZIPCODE: 28210

PROPERTY OWNER:
NAME: KERNS (last) HENRY (first) W (mi)
ADDRESS: 6501 HAZELTON PHONE: 704 553-8732
CITY: Charlotte STATE: NC ZIPCODE: 28210

PROPERTY INFORMATION (FROM ENGINEERING FORM):
TAX/PARCEL NUMBER: 215-222-23
STREET ADDRESS: 11200 McCoy Rd
ZONING:

SUBDIVISION OR MOBILE HOME PARK NAME:

Township (check one):
[ ] 0 Mecklenburg County [ ] 2 Davidson [ ] 4 Pineville [ ] 6 Huntersville
[ ] 1 Charlotte [ ] 3 Cornelius [ ] 5 Matthews [ ] 7 Mint Hill

LOT NUMBER: / LOT SIZE (in acres):

TYPE APPLICATION (check one):

[redacted]

[ ] EXCHANGE MOBILE HOME - SAME # BEDROOMS (Y)
[ ] ADDITION - INCREASE ROOMS/OCCUPANCY/MOBILE HOME SIZE (A or M)
[ ] COMMERCIAL OR INDUSTRIAL (N)

[redacted]

[ ] ADDITION - GARAGE OR RENOVATION/NO MAJOR CHANGES (X)

[redacted]

RESIDENTIAL PROPERTY (Type Building, check one):
[X] SINGLE MOBILE HOME (S) [ ] HOUSE (H) [ ] MULTIPLE FAMILY (U)
[ ] DOUBLE WIDE (D) [ ] MODULAR HOME (M) [ ] OTHER _____ (O)

NUMBER BEDROOMS: NUMBER OCCUPANTS:

SYSTEM CLASSIFICATION:

COMMERCIAL/INDUSTRIAL PROPERTY:
Type Business _____ # Employees ___ Per Shift ___ ___ ___
Industrial Wastes (Y/N) /
Underground Storage Tanks On Property (Y/N) ___ Type _____

WATER SUPPLY (check one):
[ ] Community (C) [X] Shared Well (S)
[ ] Municipal (M) [ ] Other 'spring' (O)
[ ] Private Well (P)

FUTURE ADDITIONS - ALL PLANNED ADDITIONS MUST BE ENTERED (check all that apply):
[ ] Swimming Pool [ ] Jacuzzi [ ] Stable/Barn [ ] Workshop [ ] None
[ ] Garage [ ] Storage Building [ ] Deck/Patio [ ] Bedrooms [ ] Other

The undersigned, owner, or legal agent for the owner, of the property described above as the "JOB LOCATION" has read the foregoing application, acknowledges that the contents of same are true, and authorizes agents of the MECKLENBURG COUNTY HEALTH DEPARTMENT to enter onto the property for the purpose of processing this request.

Signed: Henry W. Kerns Date: 6-22-98

NOTICE:

The undersigned, an authorized agent of the MECKLENBURG COUNTY HEALTH DEPARTMENT, certifies that the Department has approved the Request for the Job Location contained in this document. This approval is granted in accordance with the provisions of Laws And Rules for Sanitary Sewage Collection, Treatment And Disposal in effect at the time of issuance of the permit and is subject to the following provisions:

...No work shall be conducted on the septic tank system until an installation, Construction, Alteration and/or Repair approval is granted by this Department.

...This permit is not transferable.

...

Use existing system

[ ] IMPROVEMENT PERMIT - VALID 60 MONTHS FROM ISSUANCE
[ ] MOBILE HOME EXCHANGE APPROVAL - VALID 6 MONTHS FROM ISSUANCE
[ ] ADDITION/RENOVATION APPROVAL - VALID 1 YEAR FROM ISSUANCE

Kelly Randall 5-26-98
Environmentalist Date

WATER : 122


PROPOSED PLOT PLAN

HEALTH DEPARTMENT
ENVIRONMENTAL HEALTH DIVISION
700 NORTH TRYON STREET
CHARLOTTE, NC 28202
PHONE (704) 336-5102

FILE: 14718

TC: 015-222-23

Draw in and name all roads adjoining the property. Draw in and accurately dimension the lot concerned. Accurately indicate property boundaries proposed and/or existing structures and driveways, underground utilities, and wells and springs within 100 feet of the proposed building or drainfield.

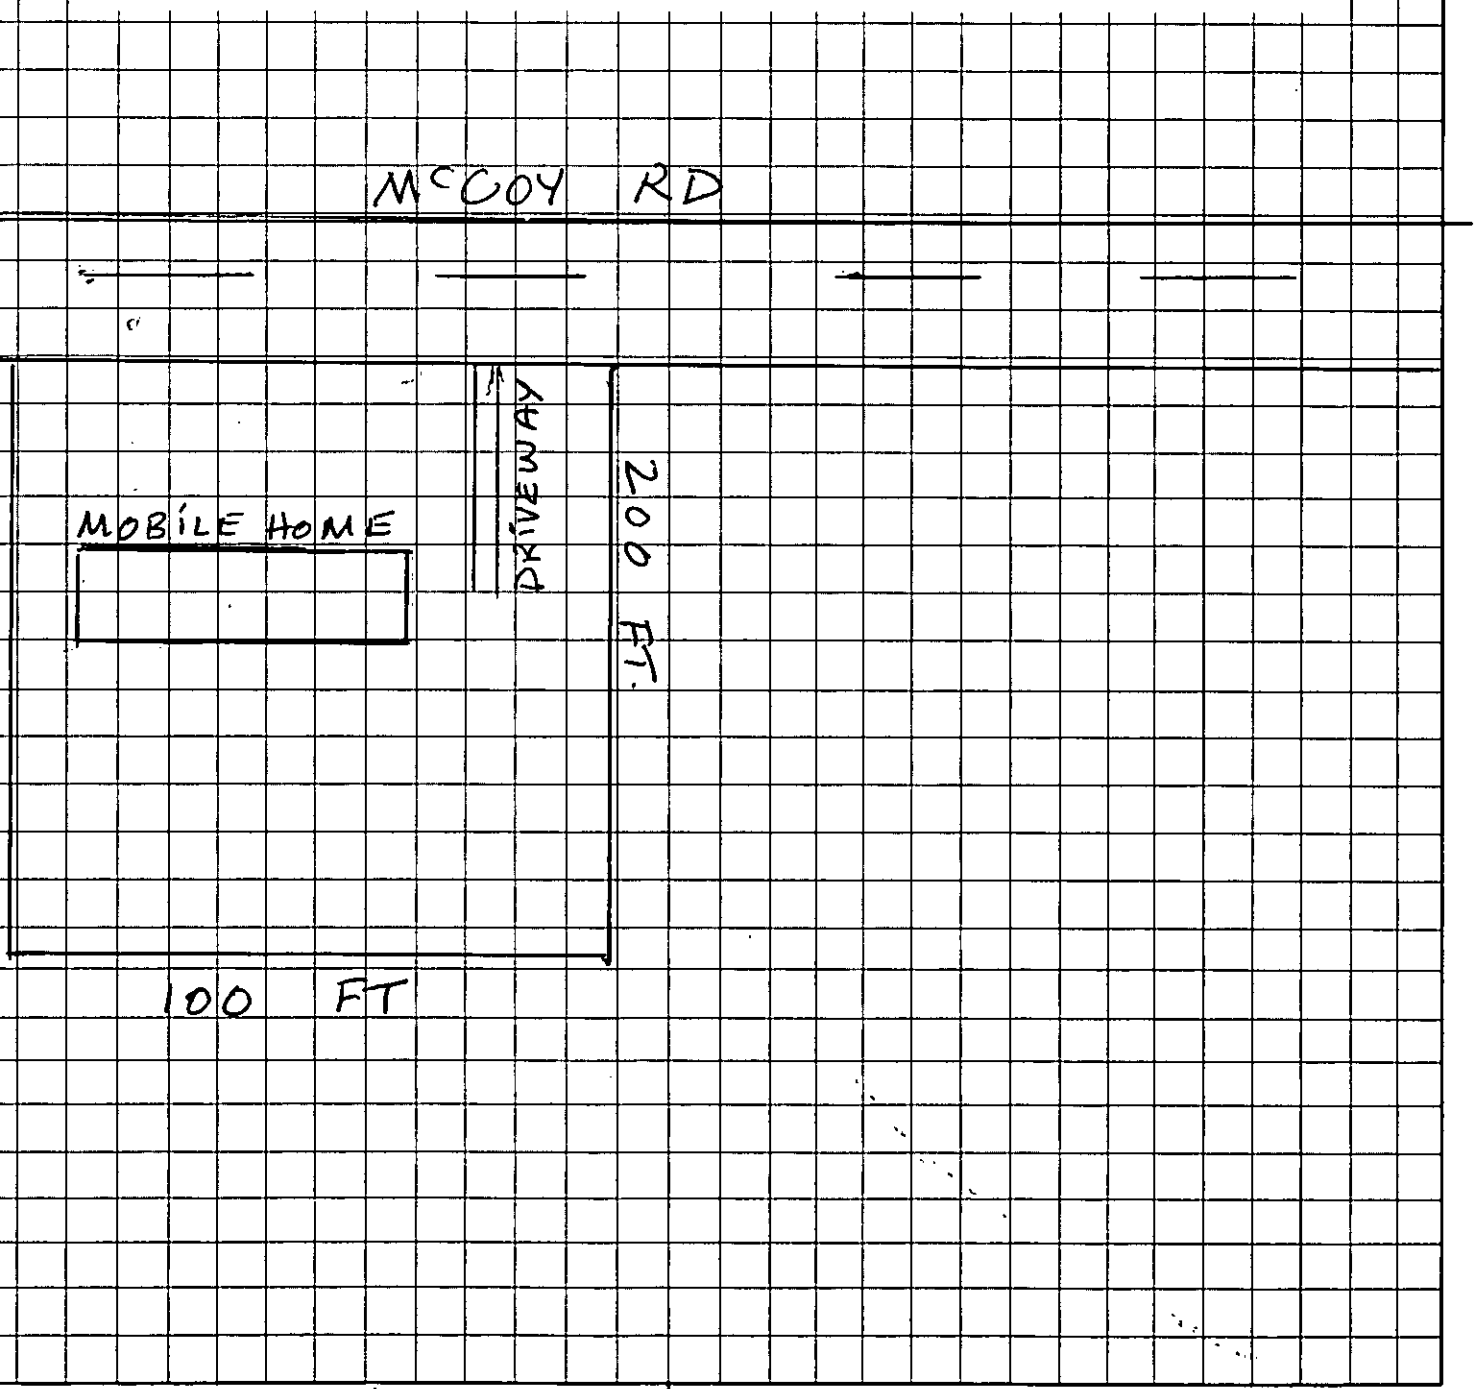

Henry W. Kerr
OWNER/AGENT SIGNATURE

DATE 6-22-98

APPROVAL DATE _____

White - Health Department's Copy Canary - E.H.S. Copy Pink - Owner's Copy

PROPOSED PLOT PLAN

400


X

HEALTH DEPARTMENT
ENVIRONMENTAL HEALTH DIVISION
700 NORTH TRYON STREET
CHARLOTTE, NC 28202
PHONE (704) 336-5102

FILE: 14718

TC: 015-222-23

Draw in and name all roads adjoining the property. Draw in and accurately dimension the lot concerned. Accurately indicate property boundaries proposed and/or existing structures and driveways, underground utilities, and wells and springs within 100 feet of the proposed building or drainfield.

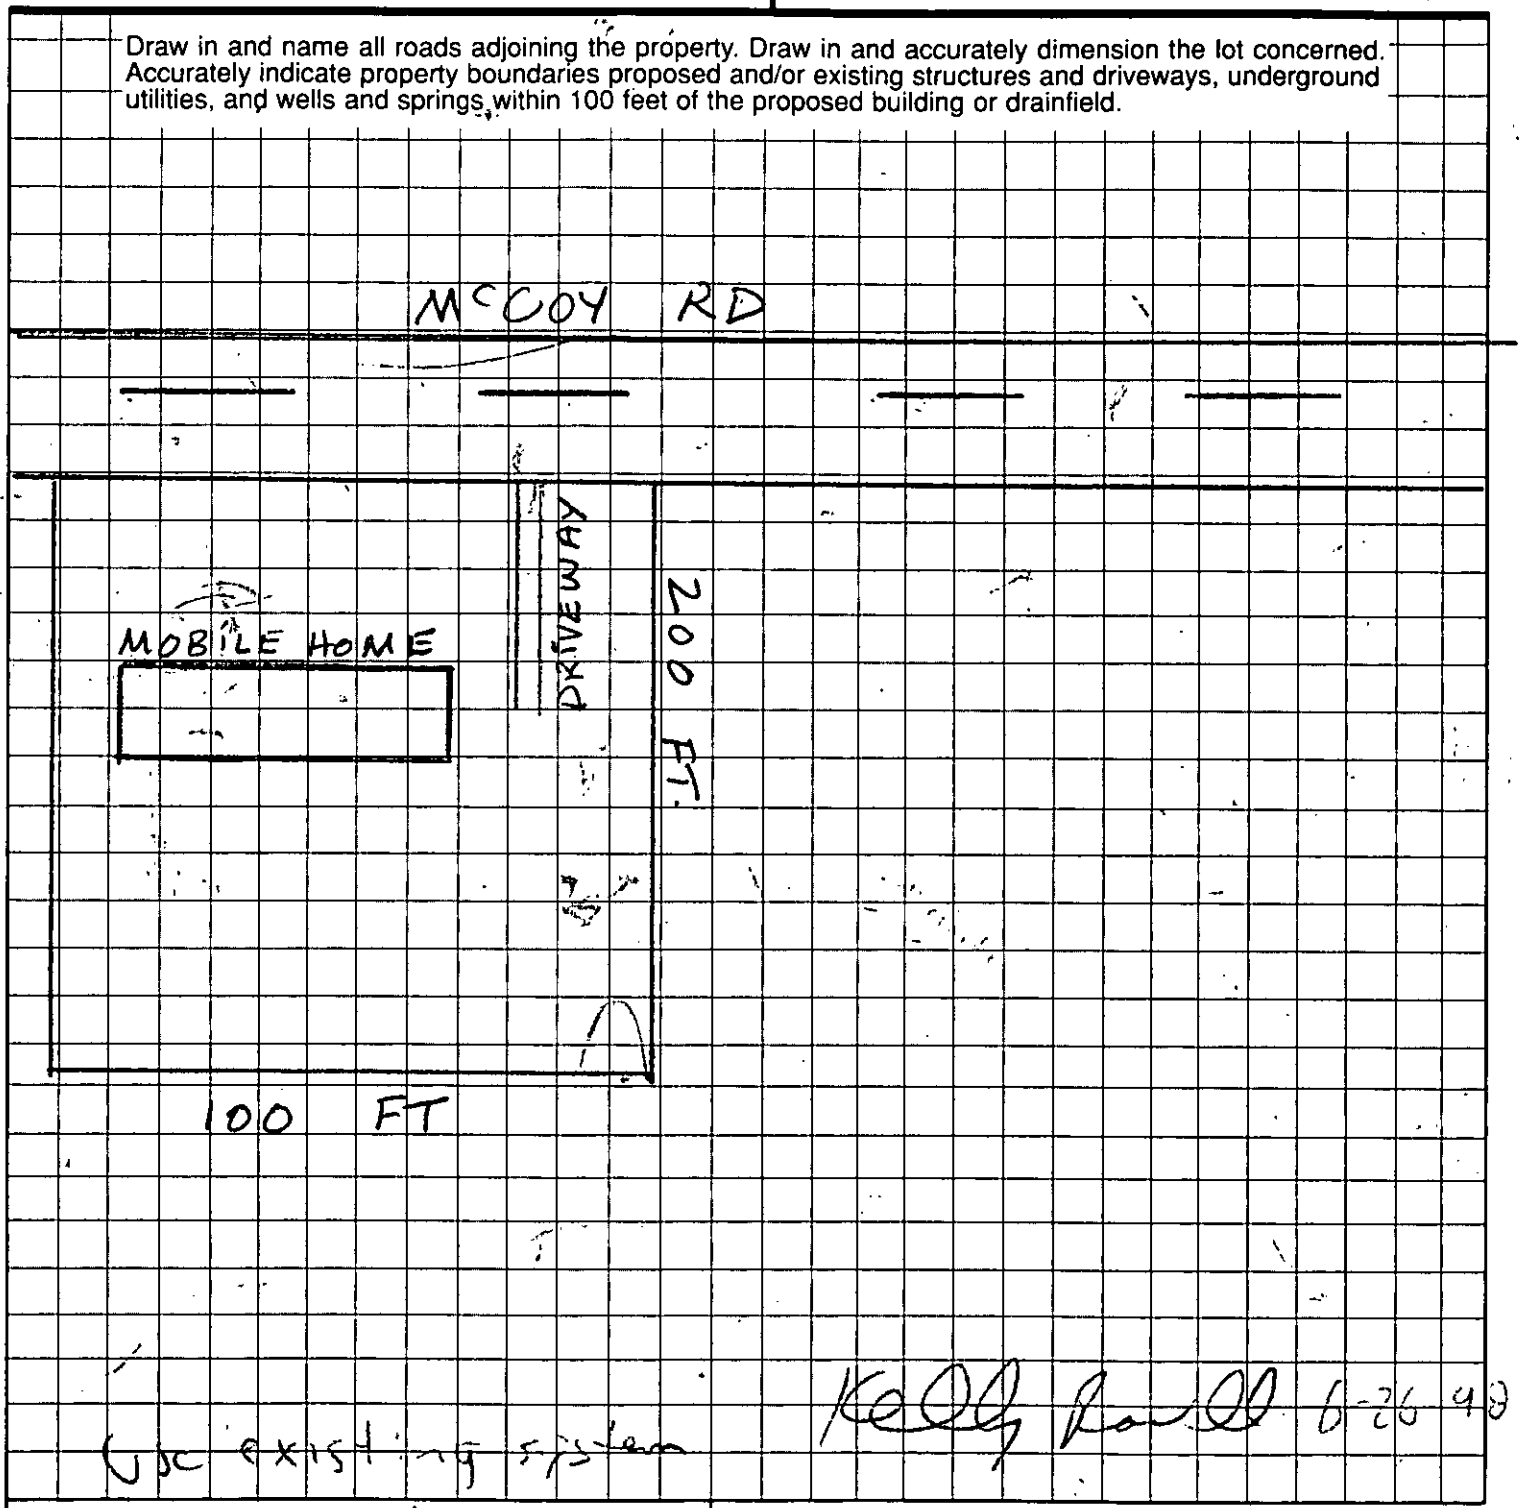

Henry W. Kern
OWNER/AGENT SIGNATURE

DATE 6-22-98

APPROVAL DATE _____

White - Health Department's Copy

Canary - E.H.S. Copy

Pink - Owner's Copy


PROPOSED PLOT PLAN

HEALTH DEPARTMENT
ENVIRONMENTAL HEALTH DIVISION
700 NORTH TRYON STREET
CHARLOTTE, NC 28202
PHONE (704) 336-5102

FILE: 14718

TC: 015-222-23

Draw in and name all roads adjoining the property. Draw in and accurately dimension the lot concerned. Accurately indicate property boundaries proposed and/or existing structures and driveways, underground utilities, and wells and springs within 100 feet of the proposed building or drainfield.

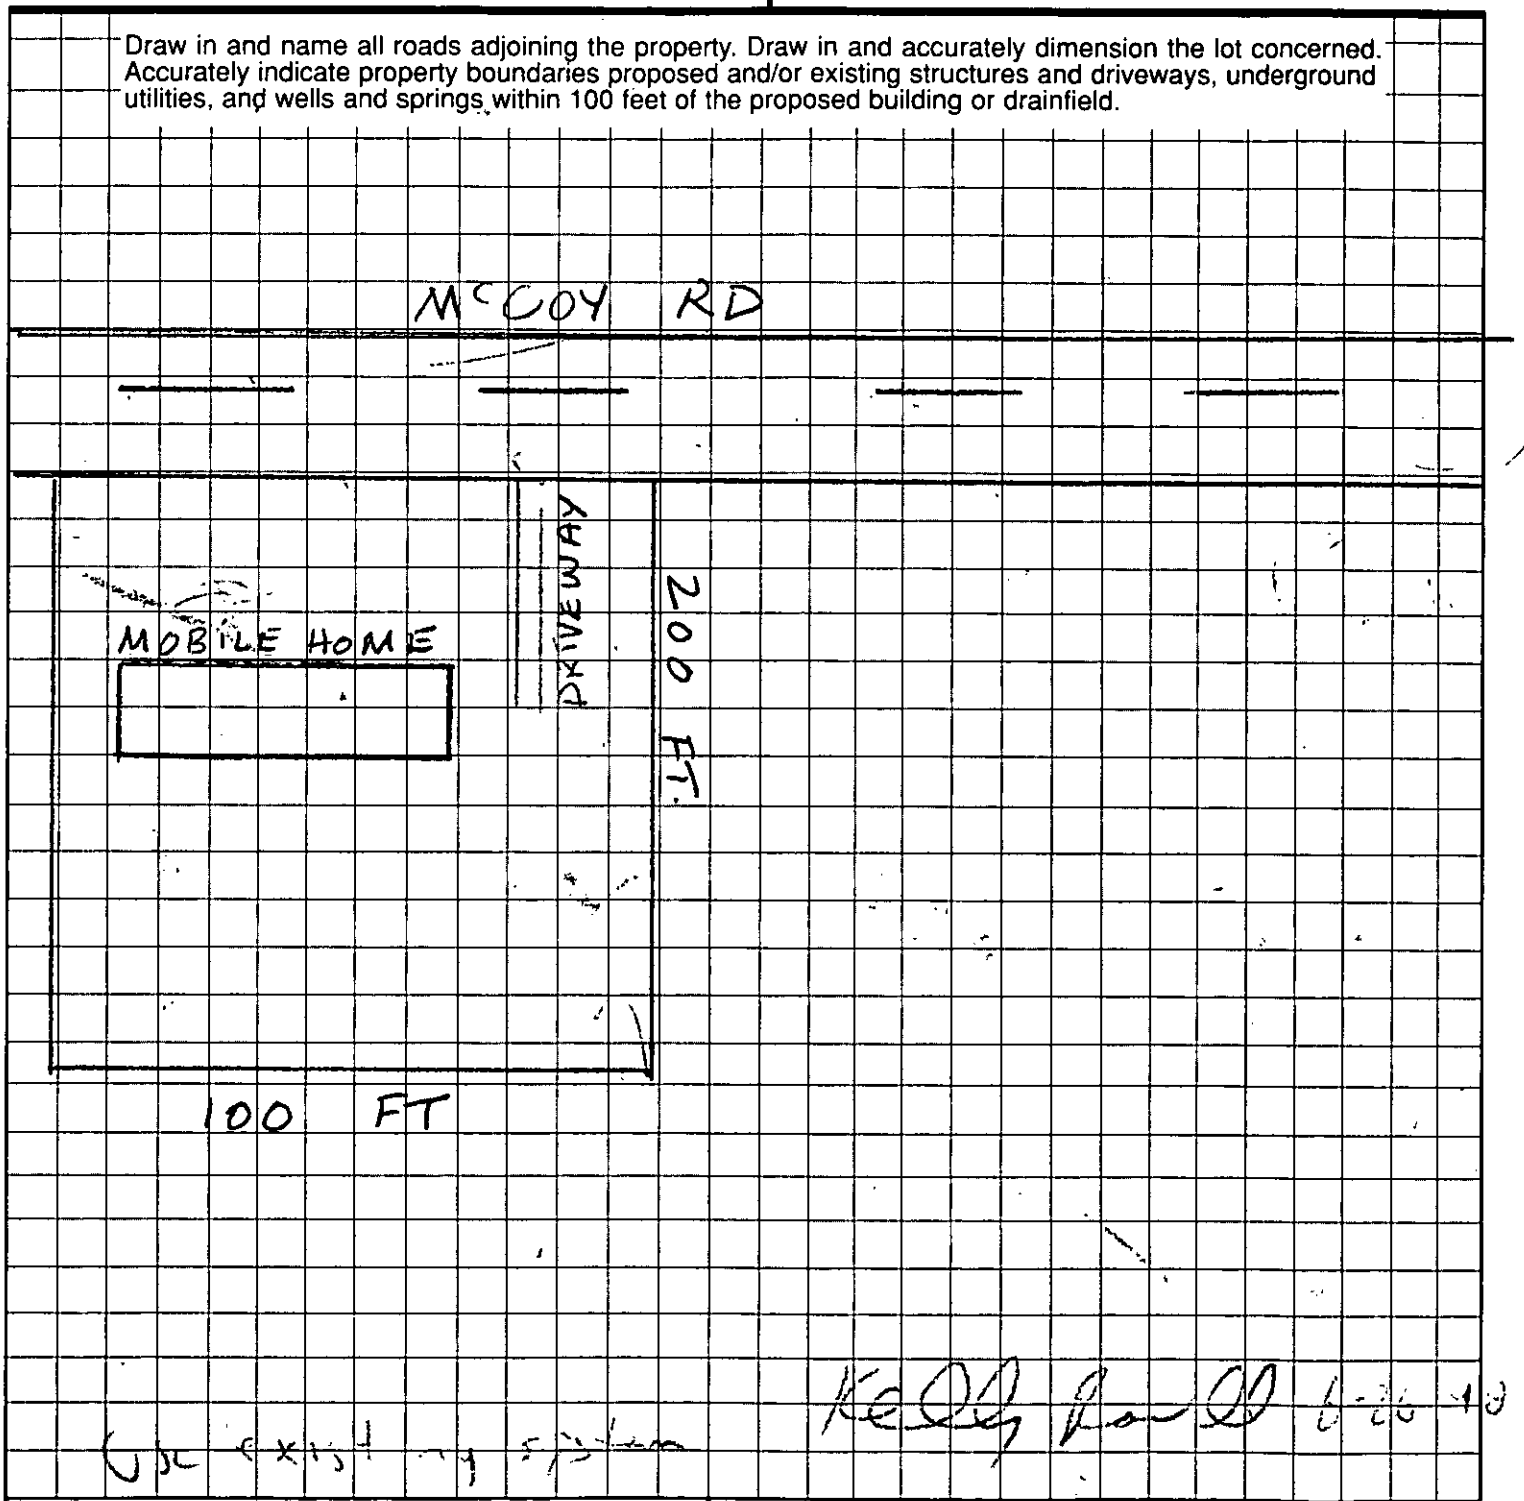

Henry W. Kern
OWNER/AGENT SIGNATURE

DATE 6-22-98

APPROVAL DATE _____

White - Health Department's Copy Canary - E.H.S. Copy Pink - Owner's Copy

INDIVIDUAL WATER AND WASTEWATER SYSTEMS PROGRAM
APPLICATION FOR SERVICES

[] CRT

Mecklenburg County Health Dept.
Environmental Health Division
c/o Hal Marshall Ctr., Suite 211
700 N. Tryon St.
Charlotte, NC 28202

(704)336-5102 14718

PERSON FILING APPLICATION:
NAME: KERNS (last) HENRY (first) W (mi)
ADDRESS: 6501 HAZELTON PHONE: 704 553-8732
CITY: Charlotte STATE NC ZIPCODE: 28210

Date:

PROPERTY OWNER:
NAME: KERNS (last) HENRY (first) W (mi)
ADDRESS: 6501 HAZELTON PHONE: 704 553-8732
CITY: Charlotte STATE NC ZIPCODE: 28210

PROPERTY INFORMATION (FROM ENGINEERING FORM):
TAX/PARCEL NUMBER: 015-222-23
STREET ADDRESS: 11200 McCoy Rd
ZONING:

SUBDIVISION OR MOBILE HOME PARK NAME:

Township (check one):
[] 0 Mecklenburg County [] 2 Davidson [] 4 Pineville [] 6 Huntersville
[] 1 Charlotte [] 3 Cornelius [] 5 Matthews [] 7 Mint Hill

LOT NUMBER: 1 LOT SIZE (in acres):

TYPE APPLICATION (check one):

[] EXCHANGE MOBILE HOME - SAME # BEDROOMS (Y)
[] ADDITION - INCREASE ROOMS/OCCUPANCY/MOBILE HOME SIZE (A or M)
[] COMMERCIAL OR INDUSTRIAL (N)
[] ADDITION - GARAGE OR RENOVATION/NO MAJOR CHANGES (X)

RESIDENTIAL PROPERTY (Type Building, check one):
(S) SINGLE MOBILE HOME (S) [] HOUSE (H) [] MULTIPLE FAMILY (U)
[] DOUBLE WIDE (D) [] MODULAR HOME (M) [] OTHER _____ (O)

NUMBER BEDROOMS: NUMBER OCCUPANTS:
SYSTEM CLASSIFICATION:

COMMERCIAL/INDUSTRIAL PROPERTY:
Type Business _____ # Employees ___ Per Shift ___ ___ ___
Industrial Wastes (Y/N) ___
Underground Storage Tanks On Property (Y/N) ___ Type _____

WATER SUPPLY (check one):
[] Community (C) (S) Shared Well (S)
[] Municipal (M) [] Other 'spring' (O)
[] Private Well (P)

FUTURE ADDITIONS - ALL PLANNED ADDITIONS MUST BE ENTERED (check all that apply):
[] Swimming Pool [] Jacuzzi [] Stable/Barn [] Workshop [] None
[] Garage [] Storage Building [] Deck/Patio [] Bedrooms [] Other

The undersigned, owner, or legal agent for the owner, of the property described above as the "JOB LOCATION" has read the foregoing application, acknowledges that the contents of same are true, and authorizes agents of the MECKLENBURG COUNTY HEALTH DEPARTMENT to enter onto the property for the purpose of processing this request.

Signed: Henry W. Kerns Date: 6-22-98

NOTICE:

The undersigned, an authorized agent of the MECKLENBURG COUNTY HEALTH DEPARTMENT, certifies that the Department has approved the Request for the Job Location contained in this document. This approval is granted in accordance with the provisions of Laws And Rules For Sanitary Sewage Collection, Treatment And Disposal in effect at the time of issuance of the permit and is subject to the following provisions:

...No work shall be conducted on the septic tank system until an installation, Construction, Alteration and/or Repair approval is granted by this Department.

...This permit is not transferable.

...

[] IMPROVEMENT PERMIT - VALID 60 MONTHS FROM ISSUANCE
[] MOBILE HOME EXCHANGE APPROVAL - VALID 6 MONTHS FROM ISSUANCE
[] ADDITION/RENOVATION APPROVAL - VALID 1 YEAR FROM ISSUANCE

Environmentalist Date

WATER : 1227


PROPOSED PLOT PLAN

HEALTH DEPARTMENT
ENVIRONMENTAL HEALTH DIVISION
700 NORTH TRYON STREET
CHARLOTTE, NC 28202
PHONE (704) 336-5102

FILE: 14718

TC: 015-222-23

Draw in and name all roads adjoining the property. Draw in and accurately dimension the lot concerned. Accurately indicate property boundaries proposed and/or existing structures and driveways, underground utilities, and wells and springs within 100 feet of the proposed building or drainfield.

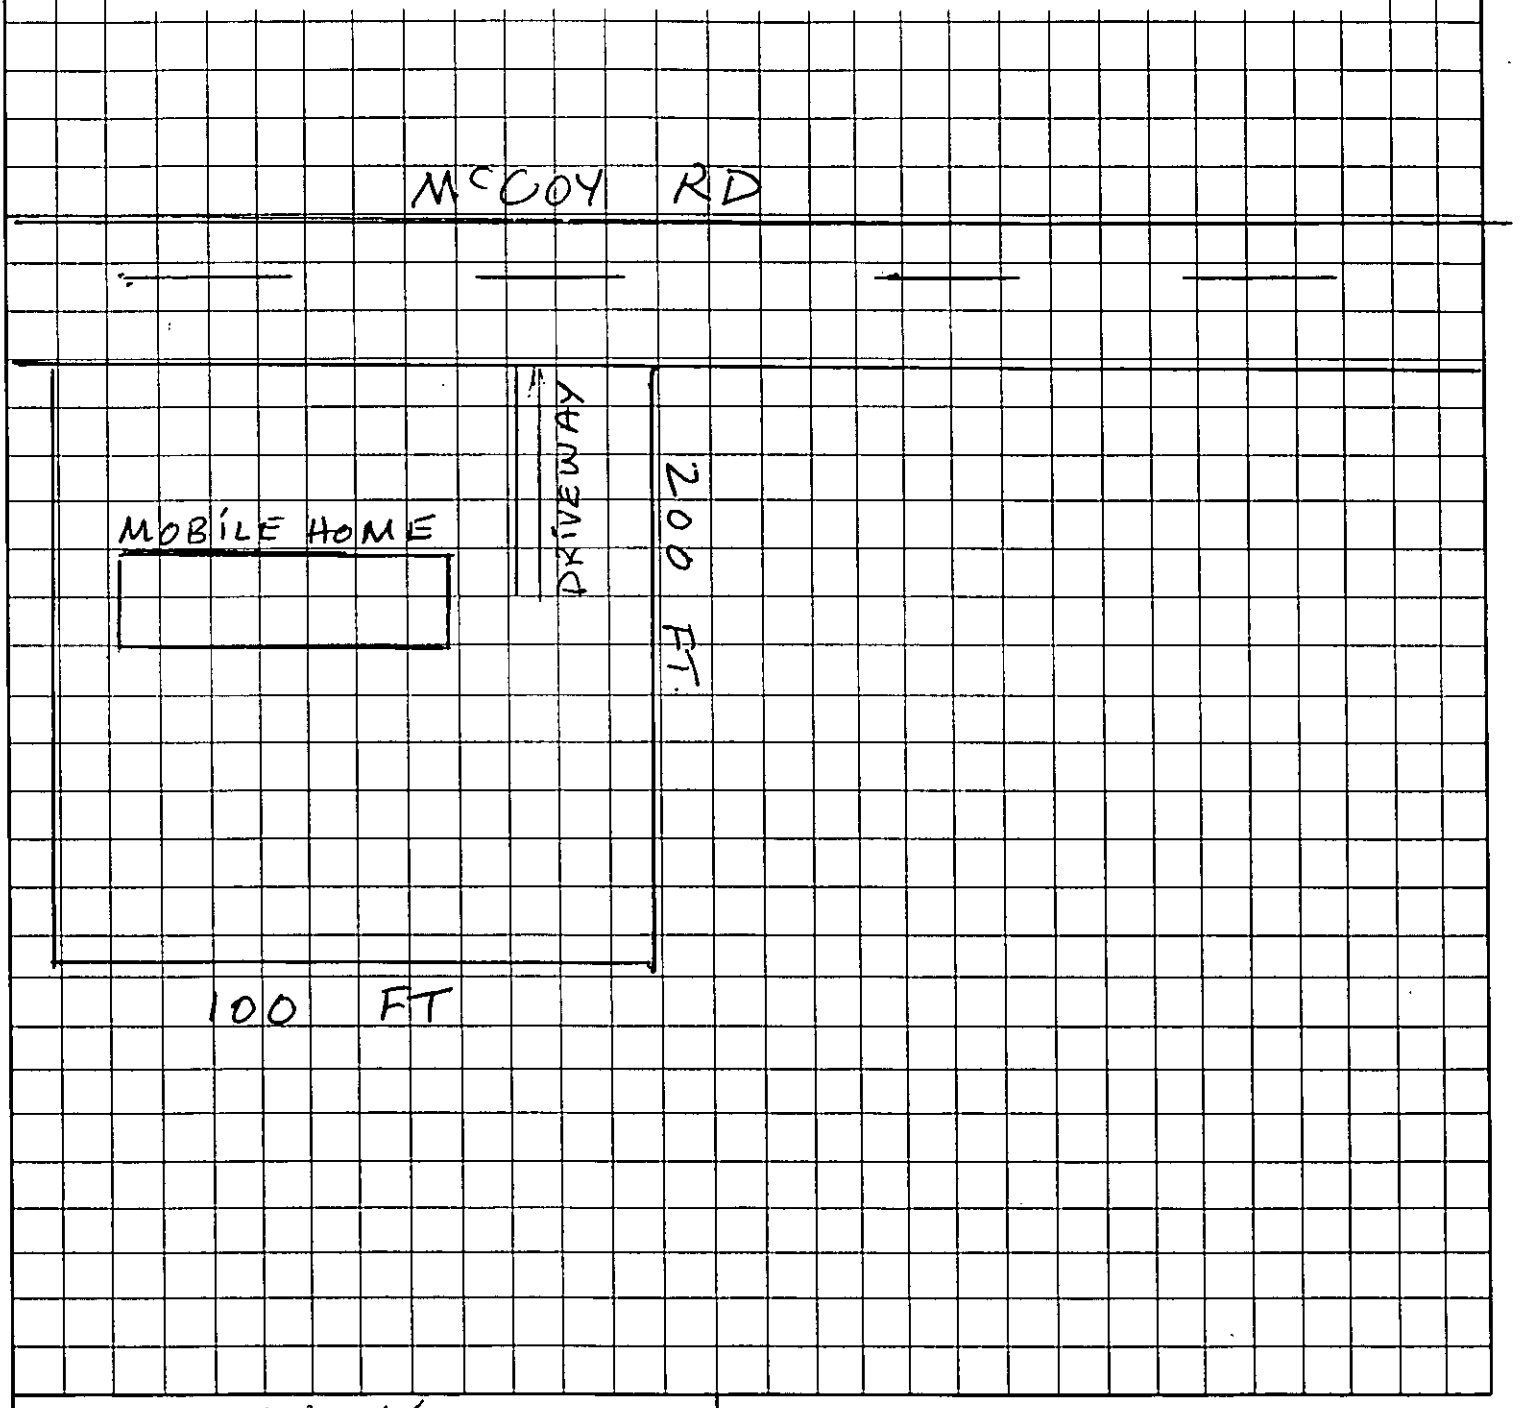

Henry W. Kerr
OWNER/AGENT SIGNATURE

DATE 6-22-98

APPROVAL DATE _____

White - Health Department's Copy Canary - E.H.S. Copy Pink - Owner's Copy

14-718 for 12955
12910 12956

INDIVIDUAL WATER AND WASTEWATER SYSTEMS PROGRAM
APPLICATION FOR SERVICES

$150.00 5/12/95 ck. #1131 for

Mecklenburg County Health Dept.
Environmental Health Division
c/o Hal Marshall Ctr., Suite 211
700 N. Tryon St.
Charlotte, NC 28202

(704)336-5102

Date:

PERSON FILING APPLICATION:

NAME: Nichols (last) Kay (first) ___ (mi)

ADDRESS: 7808 Waterford Lake #1332 PHONE: (704) 643-0007

CITY: Charlotte STATE: NC ZIPCODE: 28210

PROPERTY OWNER:

NAME: Kerneo (last) Henry (first) / (mi)

ADDRESS: ___ PHONE: (__) ___

CITY: STATE: ZIPCODE:

PROPERTY INFORMATION (FROM ENGINEERING FORM):

TAX/PARCEL NUMBER: 015-222-23

STREET ADDRESS: 11200 McCoy Rd

ZONING: Huntersville, NC 28078-6924

SUBDIVISION OR MOBILE HOME PARK NAME:

Township (check one):
- [x] 0 Mecklenburg County
- [ ] 1 Charlotte
- [ ] 2 Davidson
- [ ] 3 Cornelius
- [ ] 4 Pineville
- [ ] 5 Matthews
- [ ] 6 Huntersville
- [ ] 7 Mint Hill

LOT NUMBER: 11 LOT SIZE (in acres):

TYPE APPLICATION (check one):

- [ ] SOIL TEST - INDIVIDUAL LOT (D)
- [ ] NEW CONSTRUCTION ON VACANT LOT - 4 BEDROOMS OR LESS (N)
- [x] EXCHANGE MOBILE HOME - SAME # BEDROOMS (T)
- [ ] ADDITION - INCREASE ROOMS/OCCUPANCY/MOBILE HOME SIZE (A or M)
- [ ] COMMERCIAL OR INDUSTRIAL (N)
- [ ] SOIL TEST DEVELOPMENT (P)
- [ ] ADDITION - GARAGE OR RENOVATION/NO MAJOR CHANGES (X)
- [ ] MODIFIED /ALTERNATIVE/ OR RESIDENCE > 4 BEDROOMS (Z)
- [ ] REPAIR TO SYSTEM (R)

RESIDENTIAL PROPERTY (Type Building, check one):

- [x] SINGLE MOBILE HOME (S)
- [ ] DOUBLE WIDE (D)
- [ ] HOUSE (H)
- [ ] MODULAR HOME (M)
- [ ] MULTIPLE FAMILY (U)
- [ ] OTHER ___ (O)

NUMBER BEDROOMS: 3 NUMBER OCCUPANTS:

SYSTEM CLASSIFICATION:

COMMERCIAL/INDUSTRIAL PROPERTY:

Type Business ___ # Employees ___ Per Shift ___ ___ ___

Industrial Wastes (Y/N) ___

Underground Storage Tanks On Property (Y/N) ___ Type ___

WATER SUPPLY (check one):

- [ ] Community (C)
- [ ] Municipal (M)
- [x] Private Well (P)
- [ ] Shared Well (S)
- [ ] Other 'spring' (O)

FUTURE ADDITIONS - ALL PLANNED ADDITIONS MUST BE ENTERED (check all that apply):

- [ ] Swimming Pool
- [ ] Garage
- [ ] Jacuzzi
- [ ] Storage Building
- [ ] Stable/Barn
- [ ] Deck/Patio
- [ ] Workshop
- [ ] Bedrooms
- [ ] None
- [ ] Other

The undersigned, owner, or legal agent for the owner, of the property described above as the "JOB LOCATION" has read the foregoing application, acknowledges that the contents of same are true, and authorizes agents of the MECKLENBURG COUNTY HEALTH DEPARTMENT to enter onto the property for the purpose of processing this request.

Signed: ✓ K Nichols Date: ✓ 5-12-95

NOTICE:

The undersigned, an authorized agent of the MECKLENBURG COUNTY HEALTH DEPARTMENT, certifies that the Department has approved the the Request for the Job Location contained in this document. This approval is granted in accordance with the provisions of Laws And Rules For Sanitary Sewage Collection, Treatment And Disposal in effect at the time of issuance of the permit and is subject to the following provisions:

...No work shall be conducted on the septic tank system until an installation, Construction, Alteration and/or Repair approval is granted by this Department.

...This permit is not transferable.

...mobile home exchange - use existing system; keep mobile home a minimum of 5' from septic tank.

- [ ] IMPROVEMENT PERMIT - VALID 60 MONTHS FROM ISSUANCE
- [x] MOBILE HOME EXCHANGE APPROVAL - VALID 6 MONTHS FROM ISSUANCE
- [ ] ADDITION/RENOVATION APPROVAL - VALID 1 YEAR FROM ISSUANCE

Lbia B. Mialik 5/18/95
Environmentalist Date

Director or Authorized Section Head Program Chief 5/18/95 Date

WATER : 22791

5/17/95 OSV. Existing m.h. vacant - no visible malfunction or apparent damage to system fsm
5/18/95 PC to mo. Nichols. NC. LM of approval fsm

PROPOSED PLOT PLAN


HEALTH DEPARTMENT
ENVIRONMENTAL HEALTH DIVISION
700 NORTH TRYON STREET
CHARLOTTE, NC 28202
PHONE (704) 336-5102

~~12750~~

FILE: ~~12770~~ 14-718 jbm

TC: 015-222-23

Draw in and name all roads adjoining the property. Draw in and accurately dimension the lot concerned. Accurately indicate property boundaries proposed and/or existing structures and driveways, underground utilities, and wells and springs within 100 feet of the proposed building or drainfield.

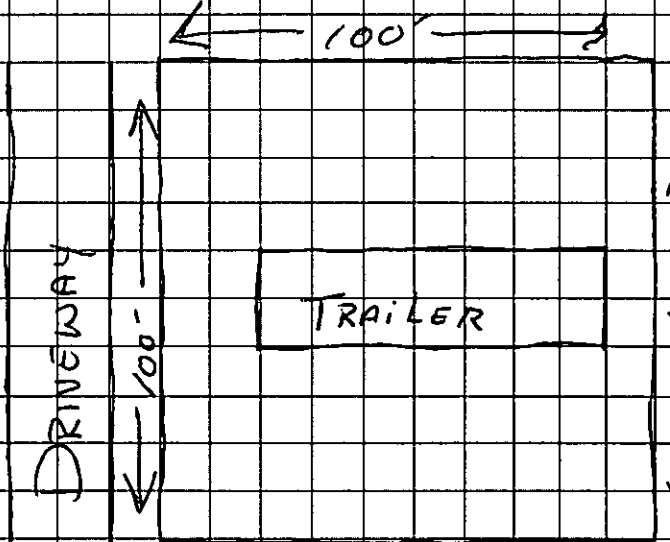

5/18/95
System via probing appears to match installation approval issued 11/21/78 Permit No. 14-718 (See attached) jbm

McCoy Road

Comments:
Keep mobile home a minimum of 5' from septic tank. jbm

APPROVAL DATE 5/18/95
Joab B. Mialik, RS.

OWNER/AGENT SIGNATURE

DATE

White - Health Department's Copy Canary - E.H.S. Copy Pink - Owner's Copy

SEE INSTRUCTIONS ON BACK

Date Received 10/31/78

ICAR(S) Application No. 14118 2

T.C. No. 045-282-01


Map Date 5-23-74

MECKLENBURG COUNTY
DEPARTMENT OF ENVIRONMENTAL HEALTH

Application for an
Installation, Construction, Alteration, and/or Repair Permit
(Individual Septic Tank System with Subsurface, Soil Absorption, Effluent Discharge)

The owner of that property described hereinafter hereby applies to the Mecklenburg County Department of Environmental Health for a permit to:

1) ✓ Install or Construct 2) _____ Alter or Repair an individual septic tank wastewater treatment system with a subsurface, soil absorption, effluent discharge.

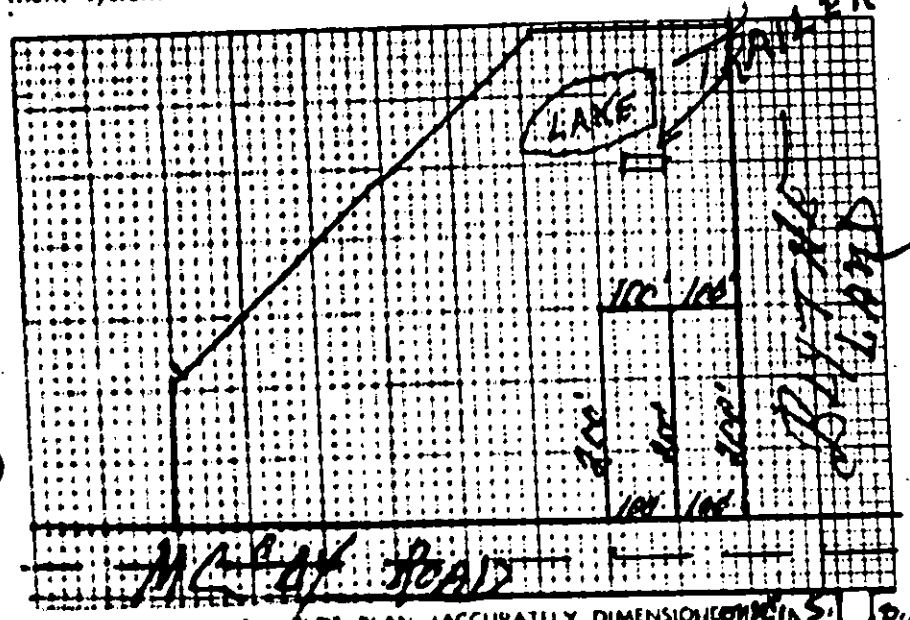

8) PLOT PLAN (ACCURATELY DIMENSIONED)

Mobile Home ✓ Yes ___ No
Residence ___ Yes ✓ No

4) No. of Bedrooms 4

5) Business Use — Max No Employees _____

6) Washing Machine ✓ Yes ___ No

7) Garbage Disposal ✓ Yes ___ No

8) Dishwasher ✓ Yes ___ No

9) Water Supply:
A) Individual Well ✓
B) Governmental System _____
C) Community System:
1. Well source _____
2. Governmental source _____

10) Sewage System:
House located within 200 feet of public sewer ___ Yes ✓ No
House located within 200 feet of community sewer ___ Yes ✓ No

11) FHA Case No. _____

12) VA Case No. _____

P.P. OK'D PIEDMONT NAT. GAS

13) NAME OF OWNER KERNS (LAST) HENRY (FIRST) WILSON (MIDDLE)

14) ADDRESS OF OWNER 1420 MONT FORD Drive

15) PHONE NO Home 523-3766 Office 394-3994

16) LOCATION OF SYSTEM McCoy ROAD (STREET OR COUNTY ROAD)

17) SUBDIVISION _____ Lot No. 1 Block No. _____

Map Book No _____ Page No. _____

18) DEED REFERENCE — DEED BOOK _____ AT PAGE _____

19) HAS A SOIL INVESTIGATION BEEN RUN? YES ✓ NO DATE RUN _____

20) PTR NUMBER (See Instructions) _____

The undersigned person hereby agrees that he has read the foregoing application and that the contents of same are true. It is understood that any permit applied for herein shall be void and of no effect if any of the above facts are not true.

DATE OF APPLICATION

OWNER Henry Kerns

EHD-5-76

Environmental Health Department's Copy

Date Issued 11-16-78

Serial No. 2189


ICAR(S) Permit No. 14718

T.C. No. 015-222-01

Map Date _____

MECKLENBURG COUNTY
DEPARTMENT OF ENVIRONMENTAL HEALTH
INSTALLATION, CONSTUCTION, ALTERATION, AND/OR REPAIR PERMIT
(Individual Septic Tank System with Subsurface, Soil Absorption, Effluent Discharge)

Permission is hereby given to ✓ Install or Construct, ____ Alter or Repair the individual septic tank wastewater treatment system with subsurface, soil absorption, effluent discharge as specified herein at the described location. This permit is granted based upon the information supplied in application 14718 dated 11-30-78 and this permit shall be void and of no effect if the information provided in the application is not true or is erroneous. All work shall be completed on or before 12-16-78 after which date this permit shall be null and void.

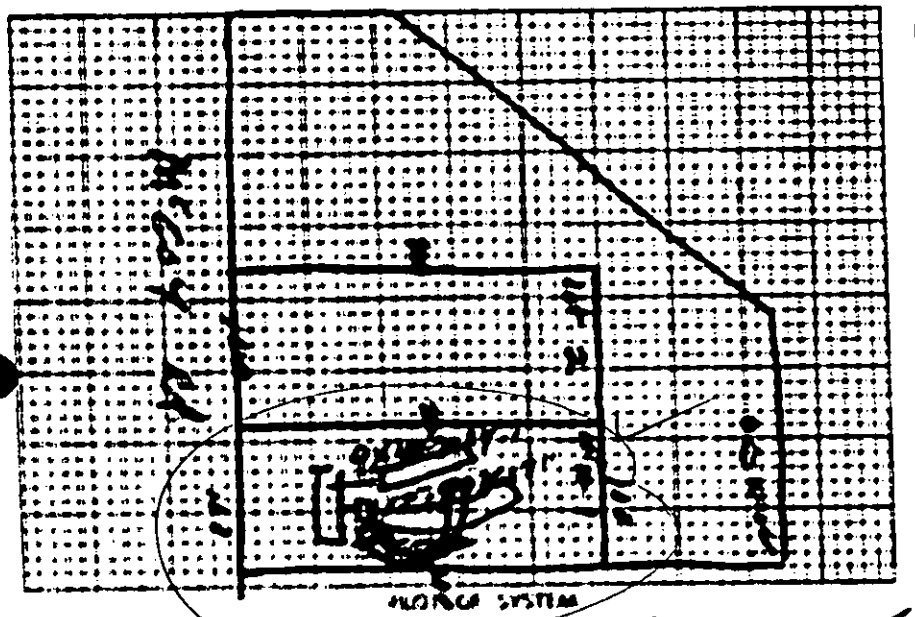

Permeability Rate P/E

Liquid Capacity of Tank 1500

Tank Construction PRECAST

Absorption and/or Nitrification Lines:

Total Line Length 495-135

Number of Lines 5-3

Distance from House 10'+

Distance from Property Line 10'+

Distance from Well 50'+

NAME OF OWNER Henry Wilson Kerns

LOCATION OF PROPERTY McCoy Rd

The system shall meet all of the construction requirements as set forth in the Regulations of the Mecklenburg County Health Commission which are in effect on the date of the granting of this permit. A certificate of approval must be issued by the Environmental Health Director before any system can be covered up or otherwise rendered uninspectable or can be used. **The issuance of this permit does not in any way guarantee that the system anticipated to be constructed will operate properly, or relieve any person now or hereafter owning, controlling or using such system from any liability resulting from the failure of the system to operate properly.**

Comments: Septic Tank Field (15'x99'x17" Stone)
Washing Machine Field (9'x42'x17" Stone)

Division or Section Head

Environmentalist

* If this permit is for the installation or construction of a new system, it must be signed by the division or a section head of the Department of Environmental Health in order to be valid. Only the signature of the Environmentalist is required where an existing system is being altered or repaired.

EHD-5-76

Environmental Health Department's Copy

BK. 17-28

PG. 27

PG. 23

PG. 19

PG. 24

PG. 20

KERNS RD.

I RD. #2117

INSET

INSET:
1"=200'

McCOY RD.

BLOCK LINE

BLOCK LINE

#2120

DUKE POWER CO. R/W

200' R/W

1188

222

221

223

1523.43

11.10 AC.

2.38 AC.

2.17 AC

24' ESMT

7.98 AC(CA)

10.011 AC

3 AC.

1.92 AC.

2 AC.

3.21 AC.

4.66 AC.

3.67 AC.

2.95 AC.

2.824 AC.

5.42 AC.

4.403 AC.

5.637 AC.

2.689 AC.

2.95 AC.

3.7 AC.

3.77 AC

1.66 AC

31.99 AC (CA)

742.37'

236.75'

1223.07'

1168.32'

1070.55'

1015.79'

1069.91

1039.92'

963.85'

848.32'

710.63'

608.32'

435.25'

412.11'

498.53'

415.42'

401.13'

396.79'

737.14'

506.28'

395.28'

382.85'

217.22'

167.89'

187.16'

187.08'

608.32

458.2

435.46'

429'

1006'

930'±

345.17'

325.74'

309.64'

299.64'

299.64'

1038.12'

145.38'

155.36'

108.38'

124.33'

135'

100'

150'

312.74'

308.96'

148.08'

428.18'

544.85'

714.42'

765.34'

929.11'

925.01'

320.99'

254.76'

139.27'

140'

100'

122'

106.01'

86.51'

76.75'

947.5'

850.3'

652.71'

230'±

200'±

155'±

141.18'

590.81'







































































































