14M

MECKLENBURG COUNTY
GROUNDWATER & WASTEWATER SERVICES

JBM 4089

APPLICATION FOR A RESIDENTIAL SITE IMPROVEMENT PERMIT/ CONSTRUCTION AUTHORIZATION FOR AN ON-SITE WASTEWATER SYSTEM, NEW WELL INSTALLATION, OR REPAIR OF EXISTING WELL

1. SEPTIC / TYPE APPLICATION: ☐ N/A ☐ NEW SYSTEM ☒ ALTERATION ☐ REPAIR ☐ MODIFIED PLOT PLAN

2. WELL / TYPE APPLICATION: ☐ N/A ☐ NEW WELL ☐ MAJOR REPAIR ☐ ABANDONMENT

3. JOB LOCATION INFORMATION:
TAX PARCEL NUMBER: 017-255-05
STREET ADDRESS: 12126 Gibraltar Dr
CITY: Huntersville NC 28078
STATE: NC ZIP: 28078
SUBDIVISION NAME:
LOT #: LOT SIZE (acres):
TOWNSHIP:
☐ 0-MECKLENBURG ☐ 3-CORNELIUS ☒ 6-HUNTERSVILLE
☐ 1-CHARLOTTE ☐ 4-PINEVILLE ☐ 7-MINT HILL
☐ 2-DAVIDSON ☐ 5-MATTHEWS

4. BUILDING INFORMATION:
BUILDING TYPE:
☐ SINGLE MOBILE HOME ☒ MODULAR HOME
☐ DOUBLE WIDE ☐ MULTIPLE FAMILY
☐ HOUSE ☐ OTHER _____
HEATED SQUARE FOOTAGE: 1523
NUMBER OF BEDROOMS: 3
NUMBER OF OCCUPANTS: 1
FOUNDATION TYPE:
☐ CONCRETE SLAB ☐ BASEMENT WITH PLUMBING
☒ CRAWL SPACE ☐ BASMENT WITH NO PLUMBING

5. IF PLANNING TO EXPAND OR ALTER THE EXISTING SEPTIC SYSTEM PLEASE COMPLETE THE FOLLOWING SECTION: ☐ N/A

NUMBER OF BEDROOMS TO BE ADDED: _____ NUMBER OF ADDITIONAL OCCUPANTS IN THE RESIDENCE: _____

6. WATER SUPPLY: ☐ MUNICIPAL ☐ PRIVATE WELL ☒ PUBLIC WELL ☐ SHARED WELL ☐ OTHER _____

7. PROPOSED USE OF WELL: ☐ N/A ☐ IRRIGATION ☐ POTABLE (DRINKING WATER) ☐ OTHER _____

8. PLEASE INDICATE AND RANK DESIRED SEPTIC SYSTEM TYPE(S) IN ORDER OF PREFERENCE *(1-MOST DESIRED 5-LEAST DESIRED)*
☐ N/A ☒ ANY TYPE ☐ CONVENTIONAL ☐ ACCEPTED ☐ INNOVATIVE ☐ ALTERNATIVE ☐ OTHER _____

8A. RANK: ____ ____ ____ ____ ____

9. DO ANY OF THE FOLLOWING APPLY TO THE PROPERTY IN QUESTION? IF "YES" PLEASE ATTACH SUPPORTING DOCUMENTATION.

BURIED CABLES, LANDFILLS, STUMPHOLES	☐ YES	☒ NO	GRADING/SOIL REMOVAL PERFORMED	☐ YES	☒ NO
EXISTING WASTEWATER (SEPTIC) SYSTEMS	☒ YES	☐ NO	JURISDICTIONAL WETLANDS	☐ YES	☒ NO
WELLS, SPRINGS, OR WATER LINES	☐ YES	☒ NO	APPROVAL REQUIRED BY ANY OTHER PUBLIC AGENCY	☐ YES	☒ NO
EASEMENTS OR RIGHT-OF-WAYS	☐ YES	☒ NO	WASTEWATER OTHER THAN DOMESTIC SEWAGE	☐ YES	☒ NO
CHEMICAL/PETROLEUM STORAGE TANKS	☐ YES	☒ NO	KNOWN UNDERGROUND CONTAMINATION	☐ YES	☒ NO
WASTE STORAGE	☐ YES	☒ NO	GROUNDWATER USE RESTRICTIONS/VARIANCES	☐ YES	☒ NO

10. WHAT DATE WAS THE PROPERTY ORIGINALLY DEEDED AND RECORDED? 1-6-07 ☐ UNKNOWN

11. WHAT IS THE ANTICIPATED CLOSING DATE FOR THIS PROPERTY? _____ ☐ N/A

12. PROPERTY OWNER:
NAME: Melba H. Adams
ADDRESS: 12126 Gibraltar Dr.
CITY: Huntersville
STATE: NC ZIP: 28078
HOME PHONE: 704 9478253
WORK PHONE:
MOBILE PHONE: 704 6614118
FAX:

13. OWNER'S LEGAL REPRESENTATIVE, IF APPLICABLE:
NAME:
ADDRESS:
CITY:
STATE: ZIP:
HOME PHONE:
WORK PHONE:
MOBILE PHONE:
FAX:

MECKLENBURG COUNTY – GROUNDWATER & WASTEWATER SERVICES
700 N. TRYON ST. SUITE 211 CHARLOTTE, NC 28202, OFFICE: 704-336-5103, FAX 704-336-6984

Revised on: 7/1/08

14. SEPTIC SYSTEM PERMIT APPLICATION:

If the information in this application is falsified, changed, or the site is altered, then the Improvement Permit and Authorization to Construct shall become invalid. I have read this application and certify that the information provided herein is true, complete and correct. Authorized county and state officials are granted right of entry to conduct necessary inspections to determine compliance with applicable laws and rules. I understand that I am solely responsible for the proper identification and labeling of all property lines and corners and making the site accessible so that a complete site evaluation can be performed. The permit is valid for either sixty (60) months or is non-expiring depending upon the documentation submitted. complete site plan = 60 months, complete plat = non-expiring. MHA (Initial here for septic system applications)

15. WELL PERMIT APPLICATION:

If the information in this application is falsified, changed, or the site is altered, then the Well Permit shall become invalid. I have read this application and certify that the information provided herein is true, complete and correct. Authorized county and state officials are granted right of entry to conduct necessary inspections to determine compliance with applicable laws and rules. I understand that I am solely responsible for the proper identification and labeling of all property lines and corners and making the site accessible so that a complete site evaluation can be performed. The permit is valid for a period of twelve (12) months from the date of issuance.

_____ (Initial here for well applications)

16. APPLICATION SIGNATURE SECTION:

ONLY COMPLETE APPLICATIONS WILL BE PROCESSED. A proper signature is required in order to process your application. Please review the application carefully and sign in the space provided below.

Melba H. Adams — Property Owner's or Owner's Legal Representative Signature

2-27-09 — Date

OFFICE USE ONLY

☐ SURVEY PLAT TO SCALE SUBMITTED ☐ SCALED SITE PLAN SUBMITTED ☐ UN-SCALED SITE PLAN SUBMITTED

SEPTIC APPLICATION FEES RECEIVED: $ 200.00 CK 1990 DATE FEE RECEIVED: 2/27/09

WELL APPLICATION FEES RECEIVED. $ _____ DATE FEE RECEIVED: _____

APPLICATION PROCESSED BY: SC


GWS FILE NUMBER ASSIGNED: 14M

APPLICATION ID NUMBER ASSIGNED: 4089

COMMENTS:

MECKLENBURG COUNTY – GROUNDWATER & WASTEWATER SERVICES
700 N. TRYON ST. SUITE 211 CHARLOTTE, NC 28202, OFFICE: 704-336-5103, FAX: 704-336-6984

Revised on: 7/1/08

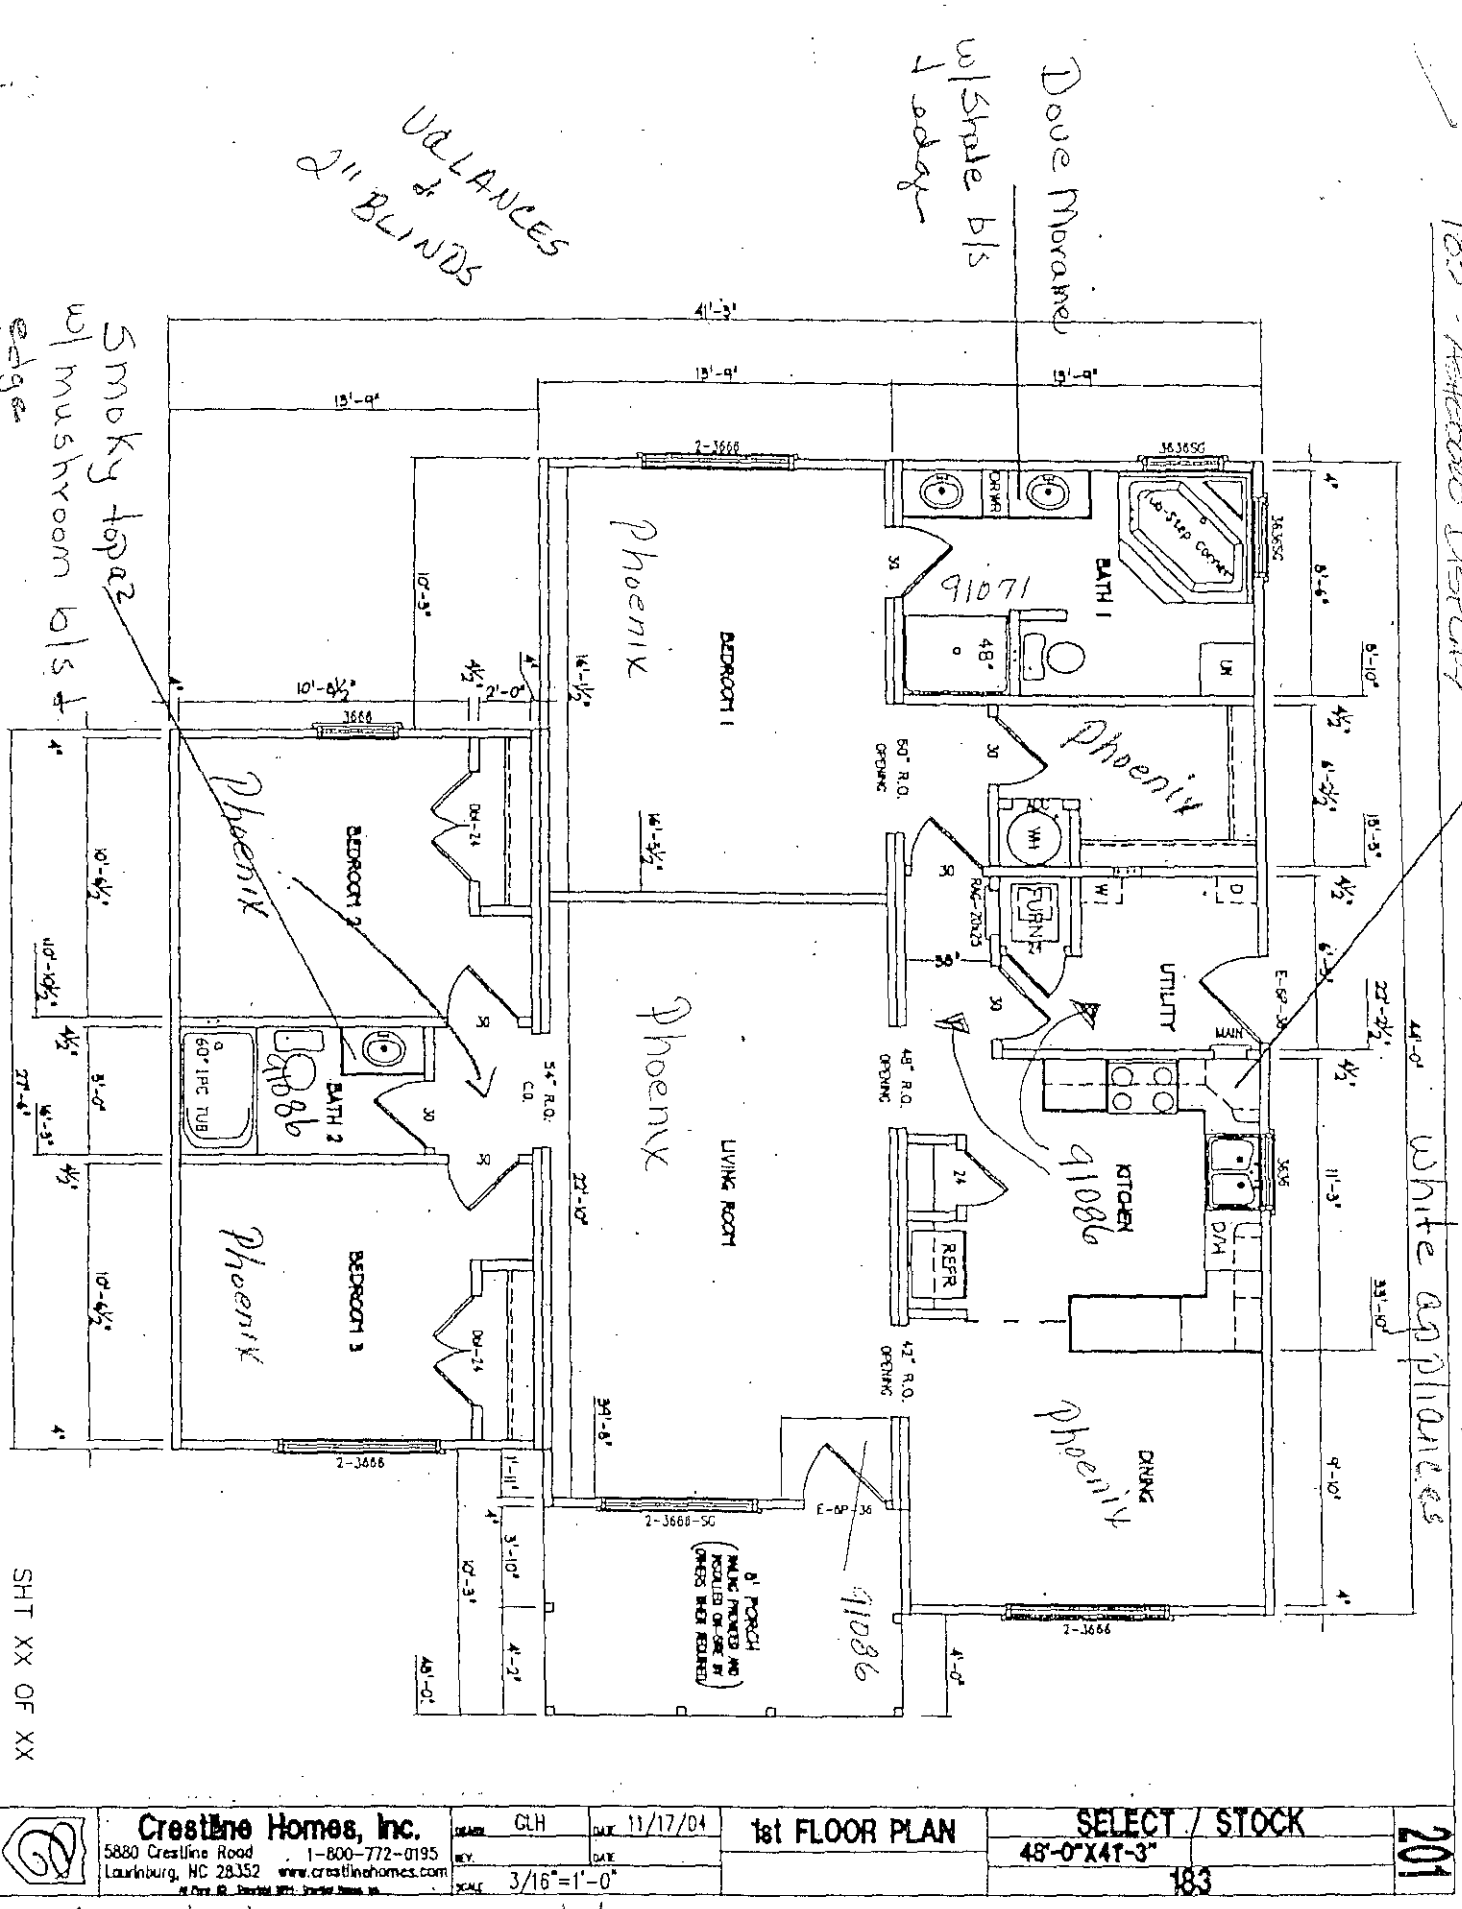

Crestline Homes, Inc. 5880 Crestline Road Laurinburg, NC 28352 1-800-772-0195 www.crestlinehomes.com	DRAWN GLH	DATE 11/17/04	1st FLOOR PLAN	SELECT / STOCK 48'-0"X41'-3"	201
	REV.	DATE		183	
	SCALE 3/16"=1'-0"				

Select Asheboro Model #9

1 of 1 11/11

CONDITIONS OF IMPROVEMENT PERMIT for an ALTERATION TO AN EXISTING ON-SITE WASTEWATER TREATMENT & DISPOSAL SYSTEM

Permit Number: **14 M** Tax Number: **017-295-05**

- The IMPROVEMENT PERMIT is subject to revocation if site plans or the intended use change. There is to be **NO** grading, filling, or disturbance of the soil in the area of the septic tank system or repair area.
- CONSTRUCTION AUTHORIZATION must be obtained prior to receiving a Building Permit. The Construction Authorization is **NOT** transferable. Do not clear, grade, fill or disturb soil prior to obtaining a Construction Authorization.
- Domestic-type wastewater only. No industrial process wastewater may be discharged into the system.

Basement: ☐ Yes ☒ No ☐ Partial Basement

Primary Wastewater System

Type. ☐ I ☒ II ☐ III ☐ IV ☐ V ☐ VI

☒ Conventional
☐ Prefabricated, permeable block panel system
☐ Shallow Placed Conventional
☐ Low Pressure Pipe
☐ Large Diameter Pipe
☐ Fill
☐ Other
☐ Innovative or Experimental:

0.3 Long-term acceptance rate (GPD/ft^2)	360 Max gallons/day wastewater flow	1200 Absorption Area (ft^2)	NA Trench spacing (min. on centers) (ft)
Serviced by private well: ☐ Yes ☒ No	1500 Gallon septic tank	BED Total trench length (ft)	30 Maximum trench depth (in) (At least 12" of provisionally suitable soil must remain between trench bottom and unsuitable soil conditions.)
3 Bedrooms in residence	NA Gallon pump tank	17 Depth of media (in)	

Any surface water present: **NO** Type: Minimum separation distance (ft):

Additional conditions: **Remove existing drainfield to stay 5' from the foundation.**

Repair Area System

Type ☐ I ☒ II ☐ III ☐ IV ☐ V ☐ VI

☒ Conventional
☐ Prefabricated, permeable block panel system
☐ Shallow Placed Conventional
☐ Low Pressure Pipe
☐ Large Diameter Pipe
☐ Fill
☐ Other
☐ Innovative or Experimental:

1200 Absorption Area (ft^2) 400 Total trench length (ft)	18 Depth of media (in)	NA Trench spacing (min on centers) (ft)	30 Maximum trench depth (in)

The undersigned, an authorized agent of the MECKLENBURG COUNTY HEALTH DEPARTMENT, certifies that the Department has approved the Request for the Job Location contained in this document. The approval is granted in accordance with the provisions of Laws and Rules For Sewage Treatment, and Disposal Systems in effect at the time of issuance of the permit and is subject to the following provisions:

*** No work shall be conducted on the septic tank system until an Installation Approval is granted by this Department.

*** This Improvement permit is transferable.


Jenny Mark, R.S. 3/3/09

DENR Authorized Agent Date

Owner/Agent Signature Date

MECKLENBURG COUNTY
GROUNDWATER & WASTEWATER SERVICES
700 N. TRYON ST., SUITE 211
CHARLOTTE, NC 28202
PHONE: (704) 336-5103
FAX: (704) 336-6894

NC DENR
DIVISION OF ENVIRONMENTAL HEALTH
ON-SITE WASTEWATER SECTION

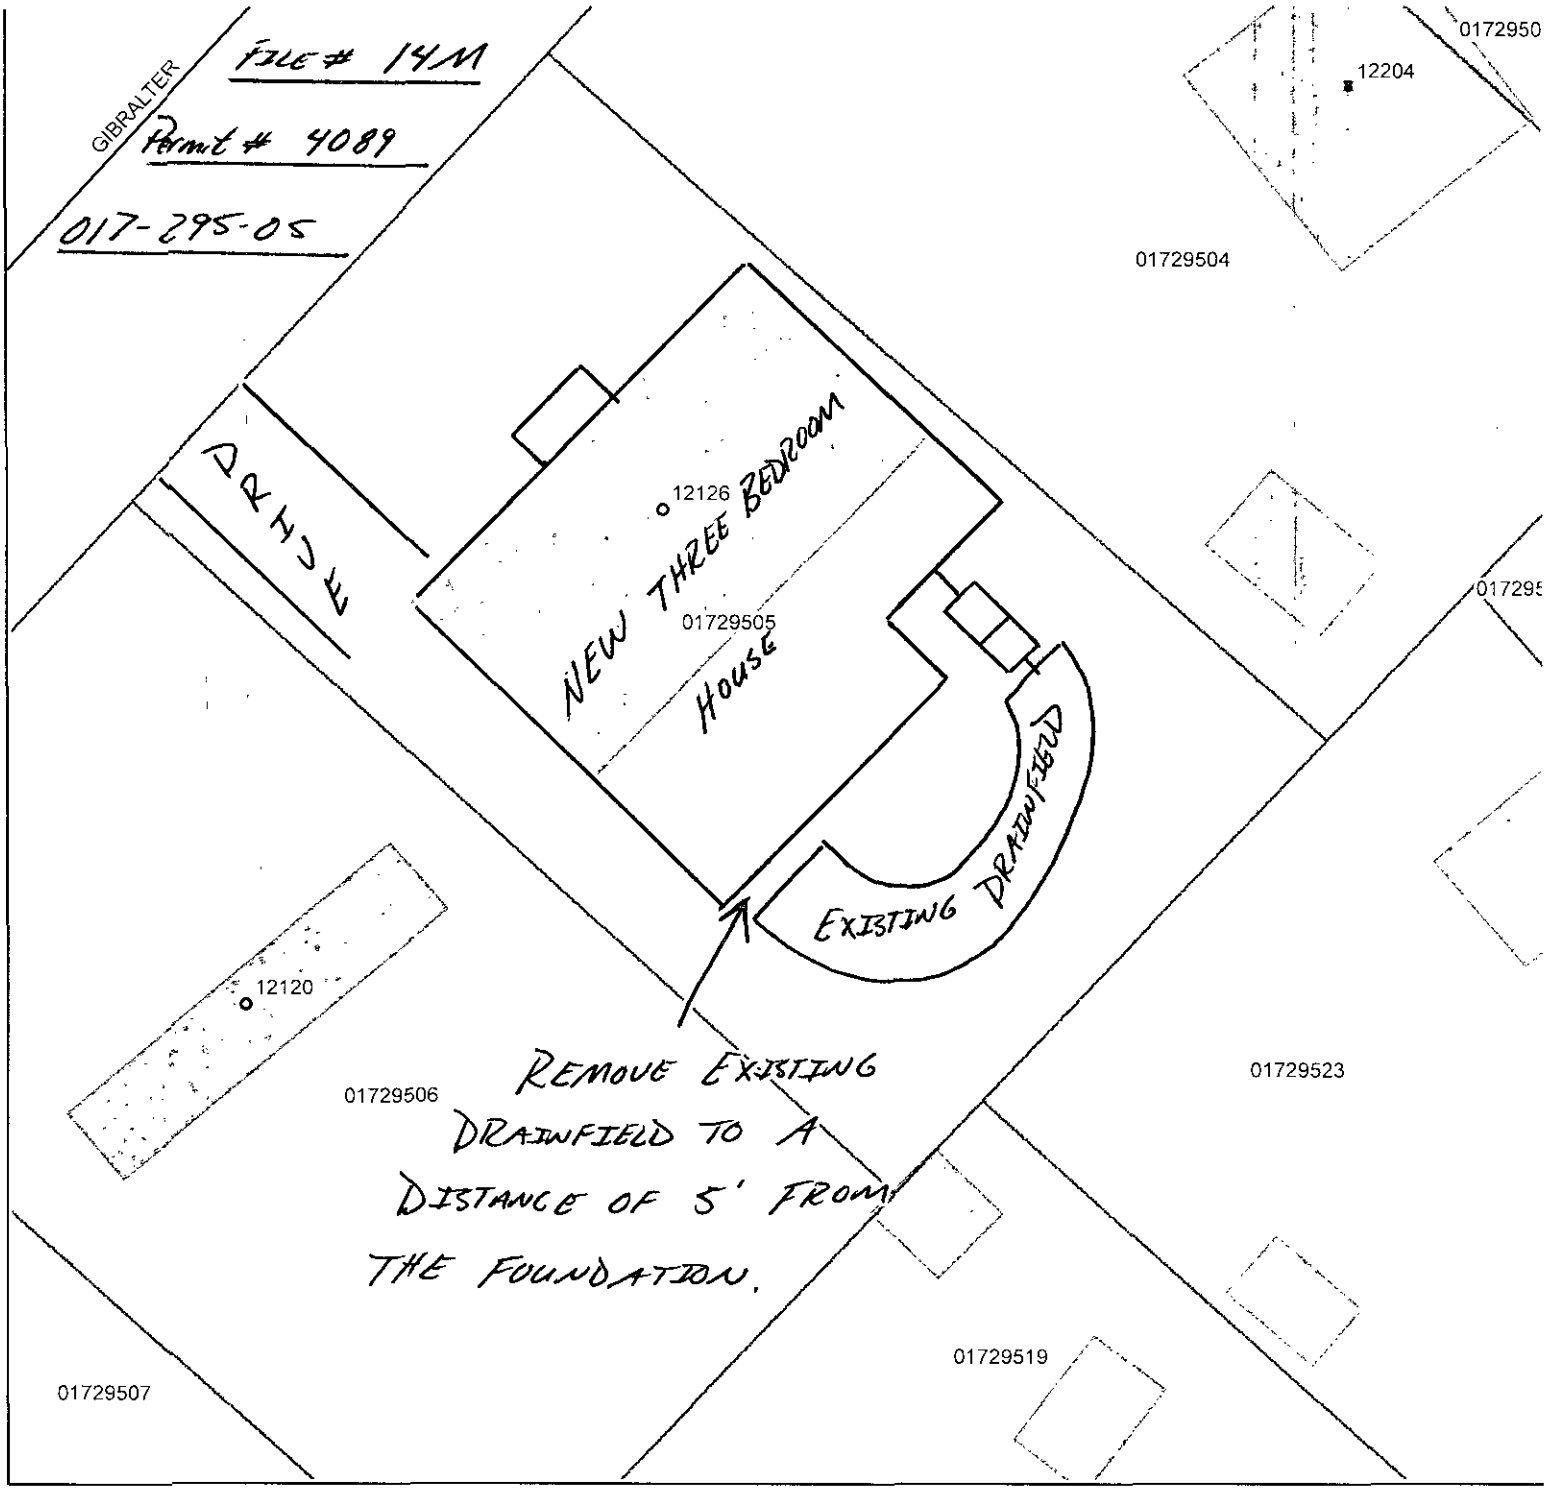

OWNER/LEGAL AGENT(PRINT NAME)

SIGNATURE

DATE

Jeremy Nicholone, R.S.

AUTHORIZED AGENT (PRINT NAME)

Jeremy Nicholone, R.S.

SIGNATURE

3/3/09

DATE

0 15 30 60 Feet

Mecklenburg County Groundwater & Wastewater Services
700 N. Tryon St., Suite 211 Charlotte, NC 28202
Phone: (704) 336-5103 Fax: (704) 336-6894

NC DENR
Division of Environmental Health
On-Site Wastewater Section

INSTALLATION APPROVAL for an ON-SITE WASTEWATER TREATMENT & DISPOSAL SYSTEM

File #: 14M Permit #: 4089 Tax Parcel #: 017-295-05

Property Owner: Melba Adams

Job Location Address: 12126 Gibralter Drive

City: Huntersville State: NC Zip Code: 28078

Installation Approval Issuance Date: 3/5/09

Permission is hereby given to ☐ install ☒ alter ☐ repair an on-site wastewater treatment & and disposal system, with subsurface soil absorption and effluent discharge, as specified herein at the described location. This approval is granted based upon the application information submitted to our office. All work shall be completed on or before 9/5/09, after which date this approval shall be null and void. The system shall meet all of the construction requirements of 15A NCAC 18A. 1900 which are in effect on the date of granting this approval. An **Operation Permit** must be obtained from the Mecklenburg County Health Department before any system can be covered up or placed into service. The issuance of this permit does not in any way guarantee that the system anticipated to be constructed will operate properly, or relieve any person now of hereafter owning, controlling or using such system from any liability resulting from the failure of the system to operate properly.

***NOTICE: This system shall not be installed while soils are in a wet condition.**

Permitted Design Flow: 360 GPD

Site LTAR: 0.3 GPD/ft² (For new installations only.)

Liquid Capacity of Septic Tank: existing gallons

Liquid Capacity of Dosing Tank: — gallons

Drainfield Design ☒ N/A

Trench Depth: _____ inches

Trench Width: _____ feet

Line Spacing: _____ feet (O.C.)

Total line length: _____ feet

# of Lines: _____ @ _____ feet

Depth of Media: _____ inches (Type) _____

Distribution Device: _____

Bed Design *(For Repair Installations ONLY.)* ☒ N/A

Bed Depth: _____ inches

Bed Width: _____ feet

Total line length: _____ feet

# of Lines: _____ @ _____ feet

Depth of Media: _____ inches (Type) _____

Distribution Device: _____

Water Supply Source

☐ Municipal ☐ Private Well ☒ Community Well

☐ Other _____


Minimum System Setbacks

Distance from Building Foundation: 5 feet

Distance from Property Line: 10 feet

Distance from Water Supply Source: 100' feet

SKETCH OF SYSTEM LAYOUT
(Proposed Layout)

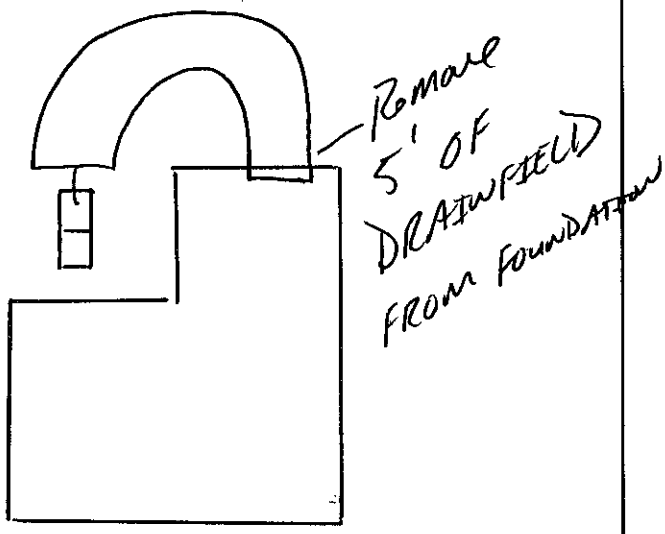

Comments: System Classification & Type: IIa Conventional System

DENR Authorized Agent: Jeremy Nicholson Signature: Jeremy Nicholson

Mecklenburg County Groundwater & Wastewater Services
700 N. Tryon St., Suite 211 Charlotte, NC 28202
Phone: (704) 336-5103 Fax: (704) 336-6894

NC DENR
Division of Environmental Health
On-Site Wastewater Section

OPERATION PERMIT for an ON-SITE WASTEWATER TREATMENT & DISPOSAL SYSTEM

File #: 14M Permit #: 4089 Tax Parcel #: 017-295-05

Property Owner: Melba Adams

Job Location Address: 12126 Gibraltar Drive

City: Huntersville State: NC Zip Code: 28078

Operation Permit Issuance Date: 3/5/09 Contractor Name: _____

Permitted Design Flow: 360 GPD

Liquid Capacity of Septic Tank: 1500 gallons

Liquid Capacity of Dosing Tank: — gallons

Effluent Pump Model: —

Drainfield Installation ☒ N/A

Trench Depth: _____ inches

Trench Width: _____ feet

Line Spacing: _____ feet (O.C.)

Total line length: _____ feet

# of Lines: _____ @ _____ feet

Depth of Media: _____ inches (Type) _____

Depth of Cover: _____ inches

Distribution Device: _____

Inspection Dates

Tank(s) Inspected: existing

Excavation Inspected: 3/5/09

Pump & Controls Inspected: —

SKETCH OF SYSTEM INSTALLATION
(As-Built Drawing)

Bed Installation *(For Repair Installations ONLY.)* ☒ N/A

Bed Depth: _____ inches

Bed Width: _____ feet

Total line length: _____ feet

# of Lines: _____ @ _____ feet

Depth of Media: _____ inches (Type) _____

Depth of Cover: _____ inches

Distribution Device: _____

Water Supply Source

☐ Municipal ☐ Private Well ☒ Community Well

☐ Other _____

System Installation Setbacks

Distance from Building Foundation: 5' feet

Distance from Property Line: >10' feet

Distance from Water Supply Source: >100' feet

The undersigned has inspected the Septic Tank System described above, and certifies it has been ☐ installed ☒ altered ☐ repaired ☐ as detailed in the plot above ☒ in accordance with the permit issued and meets the provisions of 15A NCAC 18A. 1900, "Laws and Rules for Sewage Treatment and Disposal Systems" in effect on the date of issuance of the permit. The issuance of this Operation Permit does not in any way guarantee that the system will operate properly or relieve any person now or hereafter owning, controlling, or using such system from any liability resulting from the failure of the system to operate properly. This document is issued subject to those restrictions and conditions shown on the permit(s) and the provisions of 15A NCAC 18A. 1900 in addition to those listed below under "Comments." This document shall be null and void if any information contained in the application is untrue or if any additions are made to the property which would increase the requirements for said system.

Notice: Disturbance of the designated repair area may result in the Suspension or Revocation of this permit.

Comments: System Classification & Type: IIa, GBD, Gravity, NA, NA

DENR Authorized Agent: Jeremy Michelsen, L.S. Signature: Jeremy Michelsen, L.S.

Mecklenburg County Groundwater & Wastewater Services
700 N. Tryon St., Suite 211 Charlotte, NC 28202
Phone: (704) 336-5103 Fax: (704) 336-6894

NC DENR
Division of Environmental Health
On-Site Wastewater Section

OPERATION PERMIT for an
ON-SITE WASTEWATER TREATMENT & DISPOSAL SYSTEM

File #: 14M Permit #: 4089 Tax Parcel #: 017-295-05

Property Owner: Melba Adams

Job Location Address: 12126 Gibraltar Drive

City: Huntersville State: NC Zip Code: 28078

OPERATION PERMIT CONDITIONS:

I. Performance: System shall perform in accordance with 15A NCAC 18A .1961.

II. Monitoring: System shall be monitored as required by 15A NCAC 18A .1961.

III. Maintenance: Ground absorption sewage treatment and disposal systems shall be checked, and the contents of the septic tank removed, periodically from all compartments, to ensure proper operation of the system. The contents shall be pumped whenever the solids level is found to be more than 1/3 of the liquid depth in any compartment.

IV. Operation: System shall be operated in accordance with 15A NCAC 18A .1961.

System Classification: IIa

*Operation Permits for Type V and VI systems expire five (5) years from the date of issuance (in accordance with Table V(a)). The system owner must contact GWS six (6) months prior to expiration for permit renewal.

Subsurface system operator required: Yes ☐ No ☒

☐ This type of system requires the system owner to maintain a contract with a certified operator to perform system inspection, maintenance, and reporting as required in 15A NCAC 18A .1961. and Table V(a). The system owner is responsible for all fees associated with these services.

☒ System does not require inspection by GWS on a routine frequency.

☐ System requires inspection by GWS once every five (5) years. The system owner is responsible for all fees associated with the inspection.

☐ System requires inspection by GWS once every three (3) years. The system owner is responsible for all fees associated with the inspection.

☐ System requires inspection by GWS once every twelve (12) months. The system owner is responsible for all fees associated with the inspection.

☐ System requires inspection by GWS once every six (6) months. The system owner is responsible for all fees associated with the inspection.

V. Other: 2009 A Houston

DENR Authorized Agent: Jeremy Mickelson, R.S. Date: 3/5/09

Signature: Jeremy Mickelson, R.S.

FEE: 100 CHK 1959
DATE: 12/23/08
CRT [ ]

APPLICATION FOR APPROVAL TO USE AN EXISTING ON-SITE WASTEWATER TREATMENT & DISPOSAL SYSTEM
MECKLENBURG COUNTY - GROUNDWATER & WASTEWATER SERVICES
700 N. Tryon St., Suite 211 Charlotte, NC 28202
Phone: (704) 336-5103 Fax: (704) 336-6894

GWS – UES.APP 06/07

FILE #: 14M

TYPE APPLCATION: JPM 4021

- ☐ ADDITION - INCREASE ROOMS/OCCUPANCY/MOBILE HOME SIZE (A / M)
- ☐ ADDITION - RENOVATION OR GARAGE WITH NO MAJOR CHANGES (X)
- ☑ EXCHANGE MOBILE HOME - SAME # BEDROOMS (Y)
- ☐ COMMERCIAL OR INDUSTRIAL (N)

PERSON FILING APPLICATION:
NAME: Melba H Adams
ADDRESS: 12126 Gibraltar Dr.
CITY: Huntersville
STATE: NC ZIP: 28078
PHONE: 704 9478253
ALTERNATE PHONE:

PROPERTY OWNER:
NAME: Sandra Durham
ADDRESS: 9742 Rodanthe Pl.
CITY: Huntersville ~~NC 28078~~
STATE: NC ZIP: 28078
PHONE: 704 948-9216 - W - 948-5830
ALTERNATE PHONE:

JOB LOCATION INFORMATION
TAX/PARCEL #: 01729505
STREET ADDRESS: 12126 Gibraltar
CITY: Huntersville
STATE: NC ZIP: 28078
SUBDIVISION OR MOBILE HOME PARK NAME: Wildwood Crest
LOT #: 126

TOWNSHIP:
- ☐ 0-MECKLENBURG
- ☐ 1-CHARLOTTE
- ☐ 2-DAVIDSON
- ☐ 3-CORNELIUS
- ☐ 4-PINEVILLE
- ☐ 5-MATTHEWS
- ☑ 6-HUNTERSVILLE
- ☐ 7-MINT HILL

WATER SUPPLY:
☐ MUNICIPAL (M) ☑ COMMUNITY (C) ☐ PRIVATE WELL (P) ☐ SHARED WELL (S) ☐ OTHER 'SPRINGS' (O)

RESIDENTIAL PROPERTY TYPE:
- ☐ HOUSE (H)
- ☑ MODULAR HOME (M)
- ☐ MULTIPLE FAMILY (U)
- ☐ SINGLE MOBILE HOME (S)
- ☐ DOUBLE WIDE (D)
- ☐ OTHER (O)

OCCUPANCY (both fields are required):
NUMBER OF BEDROOMS: 3
NUMBER OF OCCUPANTS: 1

COMMERCIAL / INDUSTRIAL PROPERTY TYPE:
TYPE OF BUSINESS:
EMPLOYEES PER SHIFT:
OF SHIFTS:
INDUSTRIAL WASTES? ☐ YES ☐ NO
UNDERGROUND STORAGE TANKS? ☐ YES ☐ NO

ADDITION TYPE ATTACHED TO EXISTING STRUCTURE:
☐ BEDROOM ☐ BATHROOM ☐ KITCHEN ☐ DINING ROOM ☐ LIVING ROOM ☐ DEN
☐ GARAGE ☐ SUNROOM ☐ PORCH ☐ DECK ☐ OTHER

ADDITION TYPE DETACHED FROM EXISTING STRUCTURE:
☐ DETACHED GARAGE ☐ DETACHED GARAGE WITH PLUMBING ☐ POOL HOUSE ☐ SHOP ☐ BARN
☐ STORAGE SHED ☐ DETACHED PORCH / DECK ☐ OTHER

*The undersigned, owner, or legal agent for the owner, of the property described above as the "Job Location" has read the foregoing application, acknowledges that the contents of same are true, and authorizes the Mecklenburg County Health Department to enter onto the property for the purpose of processing this request.

Melba H. Adams 12-23-08
Owner's/Agent's Signature Date

*The undersigned, an authorized agent of the Mecklenburg County Health Department, certifies that the Department has approved the Request for the Job Location contained in this document. This approval is granted in accordance with the provisions of Laws and Rules for Sanitary Sewage Collection, Treatment and Disposal in effect at the time of issuance of the permit and is subject to the following provisions:

- No work shall be conducted on the septic tank system until an installation, construction, alteration and/or repair approval is granted y this Department.
- This permit is not transferable.

☐ ADDITION / RENOVATION APPROVAL - VALID 1 YEAR FROM ISSUANCE
☐ MOBILE HOME EXCHANGE APPROVAL - VALID 6 MONTHS FROM ISSUANCE


Approval granted for mobile home exchange use existing system
Philo S. Walker RS 12/31/08
EHS Signature Date

Mecklenburg County
Land Use & Environmental Service Agency
Groundwater & Wastewater Services
700 N. Tryon St., Suite 211
Charlotte, NC 28202
Phone: (704) 336-5103
Fax: (704) 336-6894

File # 14M
Date 12-23-08

PROPOSED PLOT PLAN

A map showing existing and proposed property lines and easements with dimensions, the location of the single family residence, non-single family residence, or other facility, and appurtenances, the site for the proposed well, and the location of existing or proposed sewer lines and/or sewage disposal systems, surface water bodies, aboveground or underground storage tanks. Name all roads adjoining the property. If this a repair indicate the type of repair.

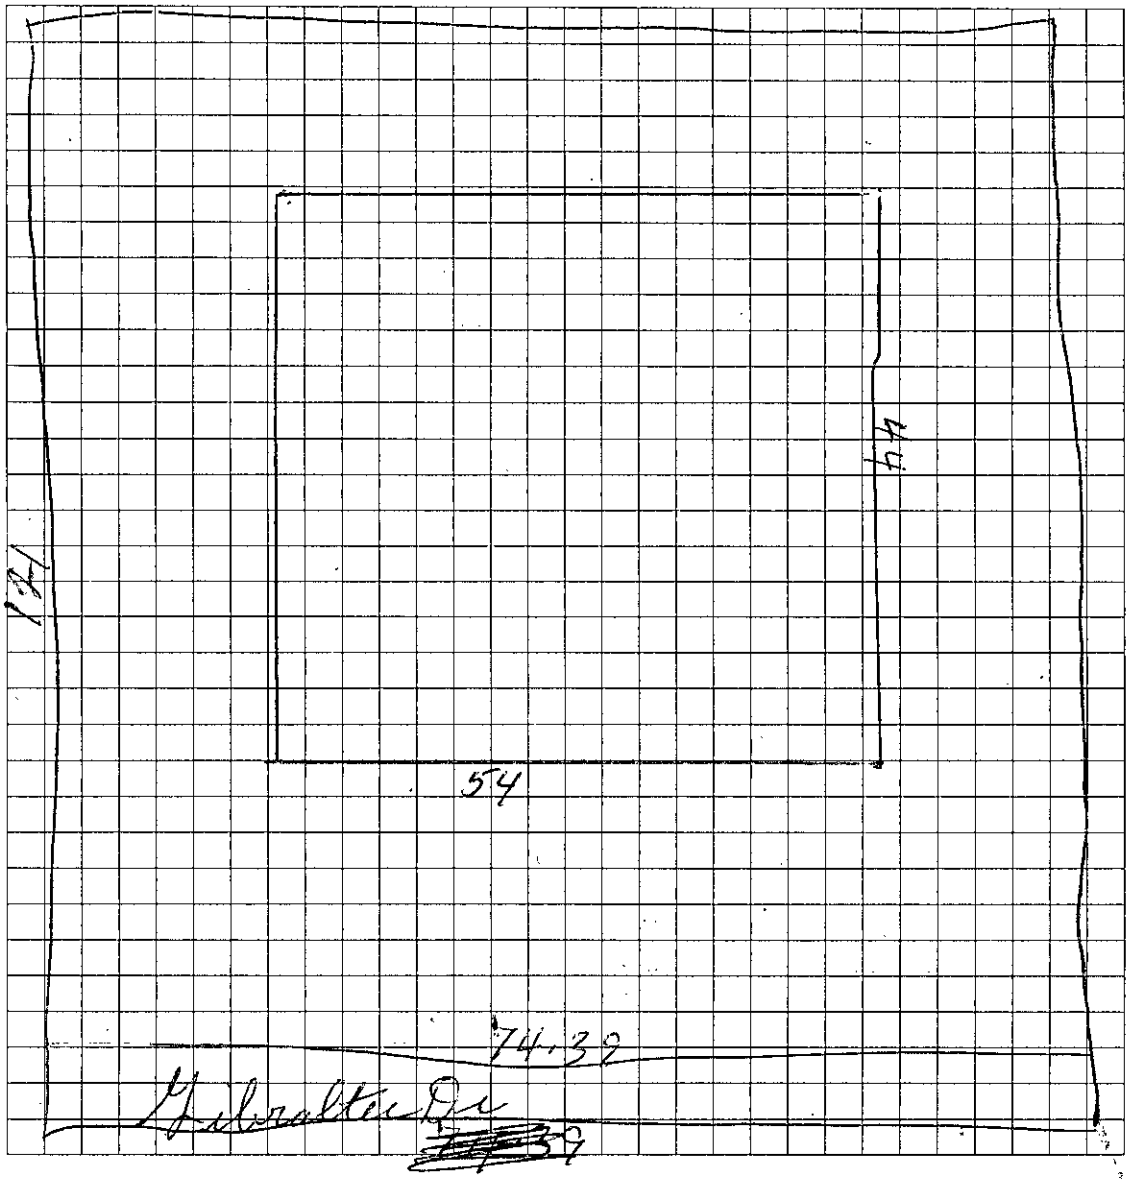

Owner/Agent Signature
Date

LBC 12/15/04