JUN 3 1983
ENVIRONMENTAL HEALTH

Date Received 6-3-83

SEE INSTRUCTIONS ON BACK

ICAR(S) Application No. 19734

T. C. No. 047-162-08


Map Date _____

# MECKLENBURG COUNTY
# DEPARTMENT OF ENVIRONMENTAL HEALTH

**Application for an**
**Installation, Construction, Alteration, and/or Repair Permit**
**(Individual Septic Tank System with Subsurface, Soil Absorption, Effluent Discharge)**

The owner of that property described hereinafter hereby applies to the Mecklenburg County Department of Environmental Health for a permit to:

1) _____ Install or Construct 2) XXX Alter or Repair an individual septic tank wastewater treatment system with a subsurface, soil absorption, effluent discharge.

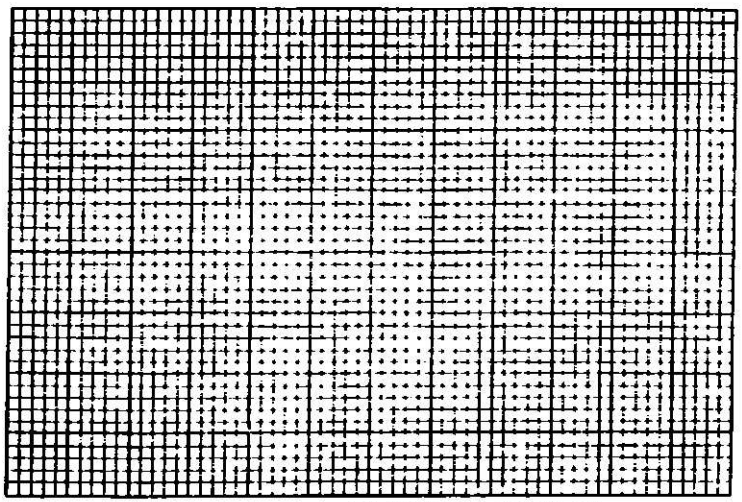

3) PLOT PLAN (ACCURATELY DIMENSIONED)

Mobile Home ____Yes____No
Residence ____Yes____No

4) No of Bedrooms _____
5) Business Use — Max No Employees _____
6) Washing Machine ____Yes ____No
7) Garbage Disposal ____Yes ____No
8) Dishwasher ____Yes ____No
9) Water Supply
   A) Individual Well _____
   B) Governmental System _____
   C) Community System
      1. Well source _____
      2 Governmental source _____
10) Sewage System
   House located within 200 feet of public sewer ____Yes ____No
   House located within 200 feet of community sewer ____Yes ____No
11) FHA Case No _____
12) VA Case No. _____

13) NAME OF OWNER [illegible] (LAST) (FIRST) (MIDDLE)

14) ADDRESS OF OWNER [illegible] 28202

15) PHONE NO. Home [illegible] Office 332711

16) LOCATION OF SYSTEM [illegible] (STREET OR COUNTY ROAD)

17) SUBDIVISION _____ Lot No. _____ Block No. _____

Map Book No. _____ Page No. _____

18) DEED REFERENCE — DEED BOOK _____ AT PAGE _____

19) HAS A SOIL INVESTIGATION BEEN RUN? ____ YES ____ NO DATE RUN _____

20) PTR NUMBER (See Instructions) _____

The undersigned person hereby agrees that he has read the foregoing application and that the contents of same are true. It is understood that any permit applied for herein shall be void and of no effect if any of the above facts are not true.

6/2/83
DATE OF APPLICATION

David P. Johnson
OWNER
Secretary-Treasurer

EHD-5-76

ENVIRONMENTAL HEALTH DEPARTMENT'S COPY


Date Issued 6-20-83

C of A (s) No. 19734

T. C. No. 047-062-08

# MECKLENBURG COUNTY
# DEPARTMENT OF ENVIRONMENTAL HEALTH

PLOT PLAN SHEET

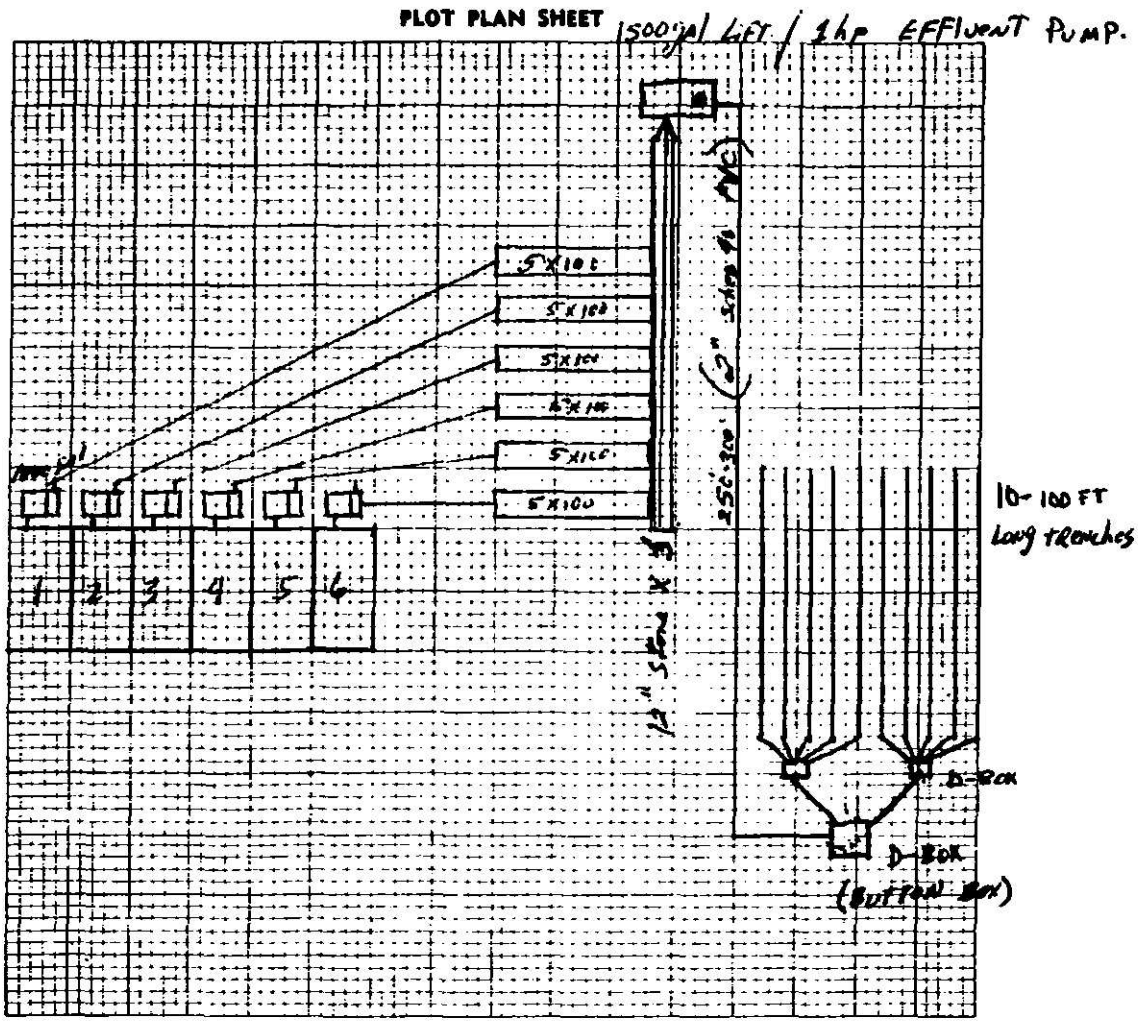


PLOT PLAN

ACCURATE DIAGRAM OF SYSTEM AS INSTALLED

Environmentalist

EHD-S-76

Environmental Health Department's Copy

Date Issued 6-20-83

Serial No. 6361


ICAR(S) Permit No. 19734

T. C. No. 047-062-08

Map Date _____

# MECKLENBURG COUNTY
# DEPARTMENT OF ENVIRONMENTAL HEALTH
## INSTALLATION, CONSTUCTION, ALTERATION, AND/OR REPAIR PERMIT
### (Individual Septic Tank System with Subsurface, Soil Absorption, Effluent Discharge)

Permission is hereby given to ___ Install or Construct, ✓ Alter or Repair the individual septic tank wastewater treatment system with subsurface, soil absorption, effluent discharge as specified herein at the described location. This permit is granted based upon the information supplied in application 19734, dated 6-2-83 and this permit shall be void and of no effect if the information provided in the application is not true or is erroneous. All work shall be completed on or before 7-8-83, after which date this permit shall be null and void.

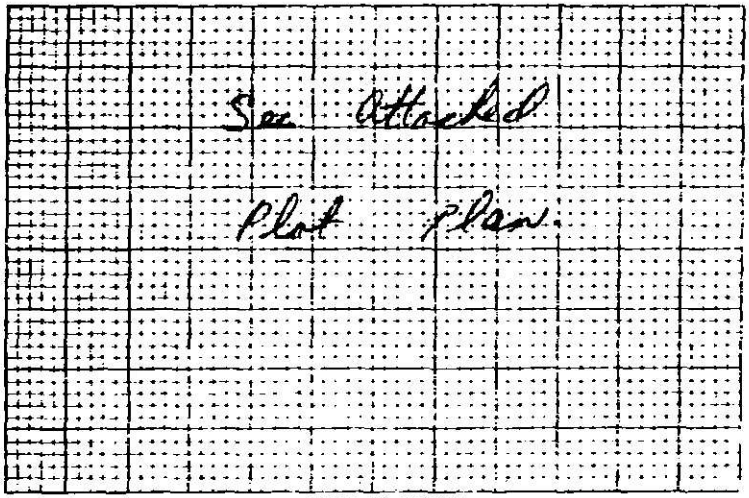


PLOT OF SYSTEM

Permeability Rate Repair

Liquid Capacity of Tank 1500gal Lift

Tank Construction Plc Concrete

Absorption and/or Nitrification Lines

Total Line Length 1000 ft

Number of Lines 5+5

Distance from House >10'

Distance from Property Line >10'

Distance from Well >100'

NAME OF OWNER Robinson and Waters Realty Company

LOCATION OF PROPERTY Dee Ita Apts., Purple Road.

The system shall meet all of the construction requirements as set forth in the Regulations of the Mecklenburg County Health Commission which are in effect on the date of the granting of this permit. A certificate of approval must be issued by the Environmental Health Director before any system can be covered up or otherwise rendered uninspectable or can be used. The issuance of this permit does not in any way guarantee that the system anticipated to be constructed will operate properly, or relieve any person now or hereafter owning, controlling or using such system from any liability resulting from the failure of the system to operate properly.

Comments: 1 hp effluent pump - 2" Set to pump 12" - 10-100 ft long x 3 ft wide x 12" stone trenches on grade - Bushhog all kudzu from field before beginning work.

Division or Section Head _____

Environmentalist R. Phelps.

* If this permit is for the installation or construction of a new system, it must be signed by the division or a section head of the Department of Environmental Health in order to be valid. Only the signature of the Environmentalist is required where an existing system is being altered or repaired.

EHD-S-76

ENVIRONMENTAL HEALTH DEPARTMENT'S COPY