Date Received 3-7-74

APT No. 7581

T C No.

Map Date

MECKLENBURG COUNTY HEALTH DEPARTMENT

ENVIRONMENTAL HEALTH DIVISION

APPLICATION FOR PERCOLATION TEST

1) NAME OF OWNER [illegible] (LAST) [illegible] (FIRST) P. (MIDDLE)

2) ADDRESS OF OWNER [illegible] ZIP [illegible]

3) PHONE NO Home [illegible] Office [illegible]


4) LOCATION OF PROPERTY [illegible] (STREET OR COUNTY ROAD)

5) SUBDIVISION [illegible] LOT NO [illegible] BLOCK NO [illegible]

MAP BOOK NO [illegible] PAGE NO [illegible]

6) DEED REFERENCE DEED BOOK [illegible] PAGE NO [illegible]

Application is hereby made to the Mecklenburg County Health Department for the conduct of a percolation test and an on site inspection of the lot hereinabove described for the purpose of determining if the lot is suitable for the installation of an individual septic tank wastewater treatment system with subsurface, soil absorption, effluent discharge

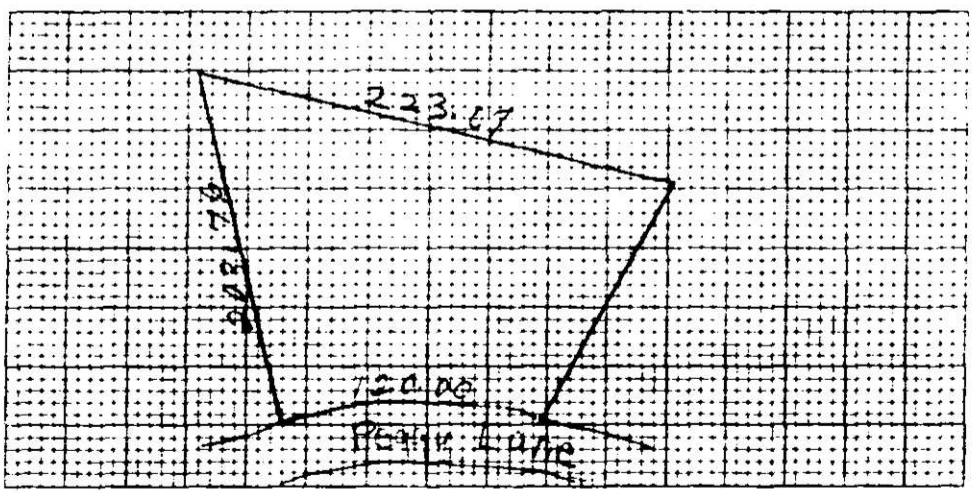

7) ACCURATELY DIAGRAM & DIMENSION LOT

W. P. Thomas
OWNER

FORM NO. E-1-11-1-70

HEALTH DEPARTMENT'S COPY

Serial No. 4117

PTR No 7581
P.O.
T C No 195-041-22

Date Issued March 12, 1974

Map Date 12-14-73

Do Not Issue A Building Permit Based On This Form

MECKLENBURG COUNTY HEALTH DEPARTMENT

ENVIRONMENTAL HEALTH DIVISION


PERCOLATION TEST REPORT

NAME OF OWNER Thomas (LAST) William (FIRST) P. (MIDDLE)

ADDRESS OF OWNER 4901 Melissa Lane, Matthews, N.C. ZIP 28105

LOCATION OF PROPERTY 3936 Peggy Lane (STREET OR COUNTY ROAD)

SUBDIVISION W. P. THomas Property LOT NO 8 BLOCK NO A

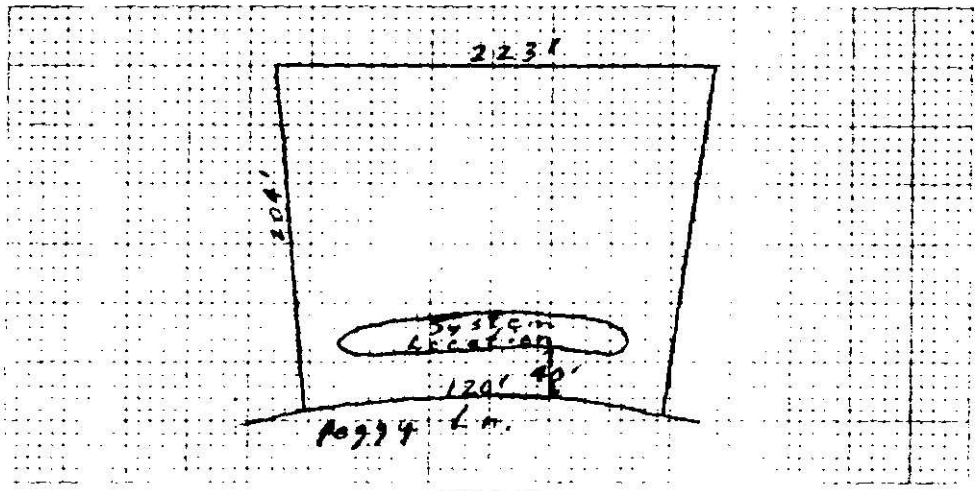

PLOT PLAN

This is to certify that a percolation test has been run and observed by a representative of the Mecklenburg County Health Department on the date indicated above. The percolation test was run on that portion of the lot as indicated on above plot.

The percolation rate determined by the test was 60*min/in. The lot is approved for the installation of a single family residential septic tank wastewater treatment system with a conventional absorption field discharge subject to the following terms and conditions:

1. A permit must be issued prior to the construction of the system by the Mecklenburg County Health Department. Application for a permit must be made by the owner of the property on which the wastewater treatment system is to be installed.
2. The size of the septic tank wastewater treatment system which may be installed will be determined by the Health Department pursuant to rules adopted by the Commission based on the percolation rate determined above, and on the size and type of building to be constructed thereon.
3. The approval is for the system as installed in the immediate area where the percolation test was run.
4. This approval is valid for one year pending the issuance of a permit for the construction of the system. If construction is not commenced within one year after the date this approval is granted, a new percolation test must be performed on the lot which is the subject of this approval. The Health Department reserves the right to withdraw approval if conditions on the lot have changed so as to render the site where the percolation test was run unsuitable for the installation, maintenance, alteration, and or repair of such a system.

This approval is granted based on the laws of the State of North Carolina, the rules and regulations of the North Carolina State Board of Health and the Mecklenburg County Board of Health which were in effect on the date of issuance and is void if at any time on the future prior to the completion of the system, these laws, rules, and regulations are changed such that this lot would not have been approved had the new or revised laws, rules, and regulations been in effect on the issue date.

*Results determined by soil analysis.

W. Reuben Cooper Jr. — Soil Scientist

Director, Environmental Health Division or Authorized Section Head

FORM NO E-2-9-1-72

HEALTH DEPARTMENT'S COPY