

1011 SAM NEWELL RD

19324107

12/19/2007

duponbj

Groundwater and Wastewater Services File Imaging Project
May 2007
Barcode Font = IDAutomationHC39M

CERTIFICATE OF COMPLETION/OPERATION PERMIT

HEALTH DEPARTMENT
ENVIRONMENTAL HEALTH DIVISION
1200 BLYTHE BOULEVARD
CHARLOTTE, NC 28203
PHONE (704) 376-4603

FILE: 9776/8849A DATE: 12/8/93

TC: 193-241-07 ☐ L ☐ CRT

SERIAL Nº 15765

Name of Owner REA CONSTRUCTION CO. Juris.:

Address of Property 1011 Sam Newell Rd.

Inspection Data:

Tank Material 1500

Total Length of Drainfield 240'

Number of Lines 3 @ 80'

Cover Depth 12"

Water Supply Source N/A

Distance to Water Source —

Excavation Inspected 12/23/93

Tank(s) Inspected 12/23/93

Wash Line Inspected —

High Water Alarm Inspected —

PLOT

Design: 1993, 1500ST, CONV, 1, 12"G, CECIL-LIKE, 720 Sq.Ft. CTR# 90

The undersigned has inspected the Septic Tank System described above, and certifies it has been

☐ installed or constructed ☐ altered or repaired

☑ in accordance with the permit issued ☐ as detailed in the plot above

and meets the provisions of 10 NCAC 10A .1900, "Laws And Rules For Sanitary Sewage Collection, Treatment, And Disposal" in effect on the date of issuance of the permit. The issuance of this

☑ Certificate of Completion ☐ Operation Permit

does not in any way guarantee that the system will operate properly or relieve any person now or hereafter owning, controlling, or using such system from any liability resulting from the failure of the system to operate properly. This document is issued subject to those restrictions and conditions shown on the permit(s) and the provisions of 10 NCAC 10A .1900 in addition to those listed below under "COMMENTS." This document shall be null and void if any information contained in the application is untrue or if any additions are made to the property which would increase the requirements for said system.

COMMENTS: Installed in wet conditions. - soil dry.

Type II

P. Walker P.S. Jr S. Daniel
12/30/93

Ron H Newell, R.S.
Environmentalist

Mecklenburg County services are available without regard to ethnic origin, sex, or disability.

INSTALLATION, CONSTRUCTION, ALTERATION, AND/OR REPAIR PERMIT


HEALTH DEPARTMENT
ENVIRONMENTAL HEALTH DIVISION
1200 BLYTHE BOULEVARD
CHARLOTTE, NC 28203
PHONE (704) 376-4603

FILE: 9778/8849A DATE: 12/8/93

TC: 193-241-07 ☐ L

SERIAL Nº 15580

Permission is hereby given to ✓ Install or Construct, _____ Alter or Repair the individual septic tank wastewater treatment system with subsurface, soil absorption, effluent discharge as specified herein at the described location. This permit is granted based upon the information supplied in the application dated 5/11/93. All work shall be completed on or before 12/30/93, after which date this permit shall be null and void. The system shall meet all of the construction requirements of 10 NCAC 10A .1900 which are in effect on the date of the granting of this permit. A Certificate of Completion or an Operation Permit must be obtained from the Mecklenburg County Health Department before any system can be covered up or placed into service. The issuance of this permit does not in any way guarantee that the system anticipated to be constructed will operate properly, or relieve any person now or hereafter owning, controlling or using such system from any liability resulting from the failure of the system to operate properly.

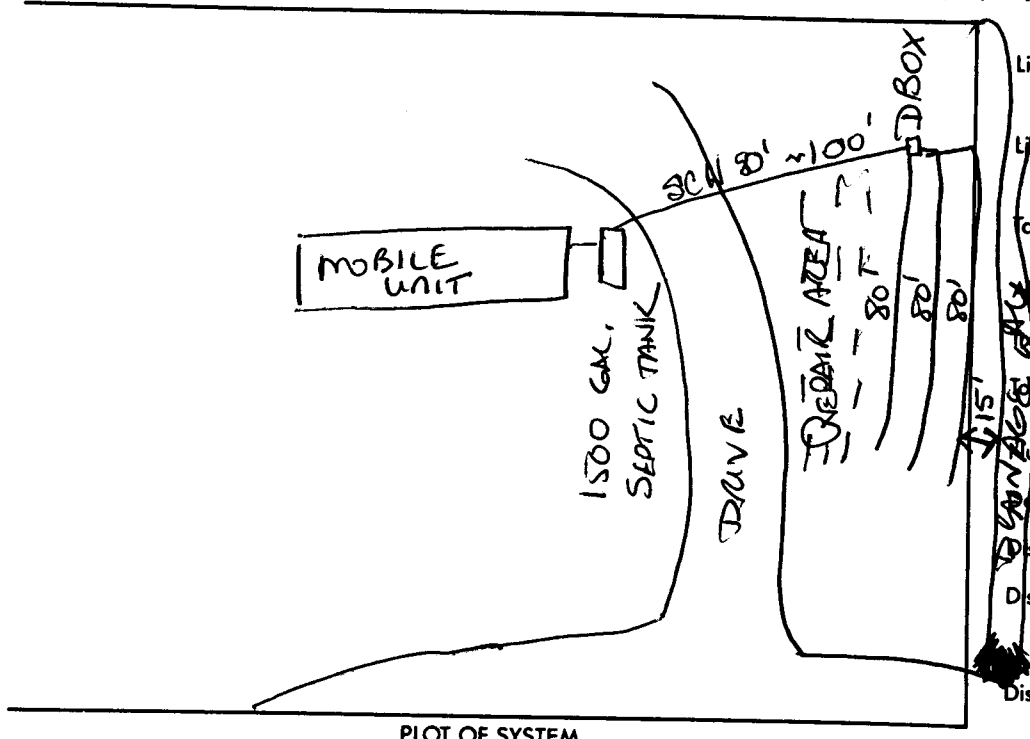

PLOT OF SYSTEM

Liquid Capacity of Septic Tank 1500 gallons

Liquid Capacity of Dosing Tank — gallons

Tank Construction PCC

Absorption and/or Nitrification Lines:

Trench Width 3 feet

Total Line Length 240' feet

Number of Lines 3

Depth of Stone 12 inches

Distance from House 5 feet

Distance from Property Line 10 feet

Distance from Well N/A feet

NAME OF OWNER REA CONSTRUCTION CO.

LOCATION OF PROPERTY 1011 Sam Newell Rd.

Comments: ① THERE SHALL BE NO DRIVE OR PARKING OVER ANY PART OF THE SEPTIC TANK SYSTEM.
② SUPPLY LINE SHALL BE SCH 80 PVC OR EQUAL.

Division or Section Head

Jon Newell, RS
Environmentalist

* If this permit is for the installation or construction of a new system, it must be signed by the division or a section head of the Mecklenburg County Health Department in order to be valid. Only the signature of the Environmentalist is required where an existing system is being altered or repaired.

WHITE - HEALTH DEPARTMENT'S COPY • CANARY - ENVIRONMENTALIST'S COPY • PINK - OWNER OR AGENT'S COPY

977B

TO: ENVIRONMENTAL HEALTH DEPT.
BUILDING STANDARDS DEPT.
DEPT. OF ENVIRONMENTAL PROTECTION/
SOLID AND HAZARDOUS WASTE

DATE: 4/30/93

FROM: COUNTY ENGINEERING DEPARTMENT

EHD FILE _____ JURISDICTION CODE [redacted] Unk

PARCEL NUMBER # 193-241-07

ASSIGNED ADDRESS 1011 San Newell Rd

EXISTING ADDRESS _____

PROJECT NAME NA

THE ABOVE DESCRIBED LOCATION HAS BEEN CHECKED CONCERNING:

		APPROVED	DISAPPROVED
1.	SUBDIVISION REGULATIONS		*
2.	FLOODWAY REGULATIONS		*
3.	EROSION CONTROL REGULATIONS		*
4.	PUBLIC UTILITY EASEMENT		*

		PRESENT	NOT PRESENT
5.	PUBLIC UTILITY EASEMENT	*	
6.	PROPERTY FRONTS ON THOROUGHFARE	*	
7.	DRIVEWAY PERMIT REQUIRED	*	

*If checked, further investigation will be required to determine whether a building permit can be issued by Building Standards for the site.

REMARKS: [redacted] Address Verified

NOTE: THIS FORM MUST BE TURNED IN AT THE CASHIER'S OFFICE AT BUILDING STANDARDS WHEN PAYING PERMIT FEES.

A CERTIFICATE OF OCCUPANCY WILL NOT BE GRANTED UNTIL THE TRANSPORTATION DIVISION GRANTS FINAL APPROVAL ON DRIVEWAYS.

SIGNED: [redacted]

OPWEAR 06-88

NEW ADDRESS ✓*

FORM 100

9778/8849A

(2400)

INDIVIDUAL WATER AND WASTEWATER SYSTEMS PROGRAM
APPLICATION FOR SERVICES

PD 200' clk 2933 5/11/93 [ ] CRT

Mecklenburg County Health Dept.
Environmental Health Division
c/o Hal Marshall Ctr., Suite 211
700 N. Tryon St.
Charlotte, NC 28202

(704)336-5102

Date:

PERSON FILING APPLICATION:
NAME: FARMER (last) Anthony (first) F (mi)
ADDRESS: P.O. Box 32487 PHONE: (704) 394-8354
CITY: Charlotte, N.C. STATE: ZIPCODE: 28232

PROPERTY INFORMATION (FROM ENGINEERING FORM):
TAX/PARCEL NUMBER: 193-24-107
STREET ADDRESS: 1011 Sam Newell Rd
ZONING:

PROPERTY OWNER:
NAME: ReA Construction Co (last) (first) (mi)
ADDRESS: P.O. Box 32487 PHONE: (704) 373-1331
CITY: Charlotte STATE: NC ZIPCODE: 28232

SUBDIVISION OR MOBILE HOME PARK NAME:

Township (check one):
[X] 0 Mecklenburg County [ ] 2 Davidson [ ] 4 Pineville [ ] 6 Huntersville
[ ] 1 Charlotte [ ] 3 Cornelius [ ] 5 Matthews [ ] 7 Mint Hill

TYPE APPLICATION (check one):

LOT NUMBER: LOT SIZE (in acres):

[ ] SOIL TEST - INDIVIDUAL LOT (D)
[ ] NEW CONSTRUCTION ON VACANT LOT - 4 BEDROOMS OR LESS (N)
[ ] EXCHANGE MOBILE HOME - SAME # BEDROOMS (Y)
[ ] ADDITION - INCREASE ROOMS/OCCUPANCY/MOBILE HOME SIZE (A or M)
[X] COMMERCIAL OR INDUSTRIAL (N)
[ ] SOIL TEST DEVELOPMENT (P)
[ ] ADDITION - GARAGE OR RENOVATION/NO MAJOR CHANGES (X)
[ ] MODIFIED /ALTERNATIVE/ OR RESIDENCE > 4 BEDROOMS (Z)
[ ] REPAIR TO SYSTEM (R)

RESIDENTIAL PROPERTY (Type Building, check one):
[ ] SINGLE MOBILE HOME (S) [ ] HOUSE (H) [ ] MULTIPLE FAMILY (U)
[ ] DOUBLE WIDE (D) [ ] MODULAR HOME (M) [ ] OTHER _____ (O)

NUMBER BEDROOMS: NUMBER OCCUPANTS:
SYSTEM CLASSIFICATION:

COMMERCIAL/INDUSTRIAL PROPERTY:
Type Business Asphalt Plant # Employees 4 Per Shift ___ ___ ___
Industrial Wastes (Y/N) N
Underground Storage Tanks On Property (Y/N) N Type _____

WATER SUPPLY (check one):
[ ] Community (C) [ ] Shared Well (S)
[ ] Municipal (M) [ ] Other 'spring' (O)
[X] Private Well (P)

FUTURE ADDITIONS - ALL PLANNED ADDITIONS MUST BE ENTERED (check all that apply):
[ ] Swimming Pool [ ] Jacuzzi [ ] Stable/Barn [ ] Workshop [ ] None
[ ] Garage [ ] Storage Building [ ] Deck/Patio [ ] Bedrooms [ ] Other

The undersigned, owner, or legal agent for the owner, of the property described above as the "JOB LOCATION" has read the foregoing application, acknowledges that the contents of same are true, and authorizes agents of the MECKLENBURG COUNTY HEALTH DEPARTMENT to enter onto the property for the purpose of processing this request.

Signed: Anthony F. Farmer Date: 5/11/93

NOTICE:

The undersigned, an authorized agent of the MECKLENBURG COUNTY HEALTH DEPARTMENT, certifies that the Department has approved the the Request for the Job Location contained in this document. This approval is granted in accordance with the provisions of Laws And Rules For Sanitary Sewage Collection, Treatment And Disposal in effect at the time of issuance of the permit and is subject to the following provisions:

...No work shall be conducted on the septic tank system until an installation, Construction, Alteration and/or Repair approval is granted by this Department.

...This permit is not transferable.

... 240 Conventional design. Minor Changes made on engineered plan. JW

[X] IMPROVEMENT PERMIT - VALID 60 MONTHS FROM ISSUANCE
[ ] MOBILE HOME EXCHANGE APPROVAL - VALID 6 MONTHS FROM ISSUANCE
[ ] ADDITION/RENOVATION APPROVAL - VALID 1 YEAR FROM ISSUANCE

Jan H Newell, RS 5/20/93
Environmentalist Date

Director or Authorized Section Head RS 5/25/93 Date

WWATER : 122791

MECKLENBURG COUNTY HEALTH DEPARTMENT
SITE EVALUATION REPORT
SERIAL NUMBER 19331

File: [illegible] Action: /

Parcel: [illegible] ☐ PC

Location:

Subdivision:


Lot: Block: Acres:


Owner:
Address:

Comments:

Described by:

Date:

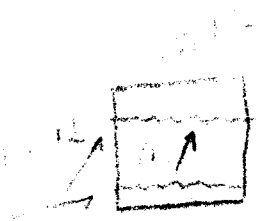

 

***** EVALUATION KEY *****

S = Suitable U = Unsuitable
PS = Provisionally Suitable
The "Area Classification" below indicates the suitability of areas in the diagram.

FACTORS	AREA 1	AREA 2	AREA 3	AREA 4	AREA 5	AREA 6
Topography	S PS U	S PS U	S PS U	S PS U	S PS U	S PS U
Texture	S PS U	S PS U	S PS U	S PS U	S PS U	S PS U
Structure	S PS U	S PS U	S PS U	S PS U	S PS U	S PS U
Drainage	S PS U	S PS U	S PS U	S PS U	S PS U	S PS U
Depth	S PS U	S PS U	S PS U	S PS U	S PS U	S PS U
Restrictive Horizons	S PS U	S PS U	S PS U	S PS U	S PS U	S PS U
Available Space	S PS U	S PS U	S PS U	S PS U	S PS U	S PS U
Other (specify)	S PS U	S PS U	S PS U	S PS U	S PS U	S PS U
Soil Group/Series						
Area Classification	S PS U	S PS U	S PS U	S PS U	S PS U	S PS U

Mecklenburg County
Health Department

Betty S. Snow, R.N., M.A.
Health Director

May 5, 1993

Rea Construction Company
P. O. Box 32487
Charlotte, NC 28232

RE: Property located on Sam Newell Road
FILE: 977B/8849A
PARCEL: 193-241-07PO

Dear Sir:

At your request, a field investigation was conducted on the property designated above for the purpose of determining site suitability for the installation of a ground absorption sewage disposal system. The property was found to contain a limited area of soils which were classified as PROVISIONALLY SUITABLE for such an installation. A copy of the Site Evaluation Report (Serial Number 19331) is enclosed for your information.

While this classification indicates the site is acceptable for the installation of a septic tank system, no specific system or plans have been approved. The area available for such an installation may impose limitations on the size and/or type construction permitted on the lot. Specific plan approval will be provided upon submission of an Application for an Improvement Permit with an **ACCURATELY** dimensioned plot plan detailing the location of current and/or proposed buildings, wells and sewage disposal systems and determination that the area is adequate to accommodate the proposed construction.

Please note that this classification may be revoked if any filling, grading or construction (including the drilling of a well) is performed on the lot which in the opinion of this department renders any area previously designated suitable for system installation, unsuitable. Furthermore, this approval may be revoked should any changes occur in the regulations under which it was granted, if such changes would have prevented its approval had they been in effect on the date of issuance.

If there are any questions concerning this matter, please contact Bill Marlin, Soil Scientist at 336-5574.

Sincerely,

Kelly Randall, R.S., Soil Scientist
Individual Water and Wastewater Systems

Enclosure

MECKLENBURG COUNTY HEALTH DEPARTMENT
SITE EVALUATION REPORT
SERIAL NUMBER 19331

File: 9773/8849A Action 1

Parcel: PO 193-241-671 ☐ PC

Location: Sam Newell Road

Subdivision:


Lot: Block: Acres: .5

Owner: Rea Construction Co.
Address: PO Box 32487
Charlotte, NC. 28232

Comments: ~~.3gal/ft2/day LTAR~~
~~may require 100% repair~~

Described by: William R. Marks

Date: 4-29-93

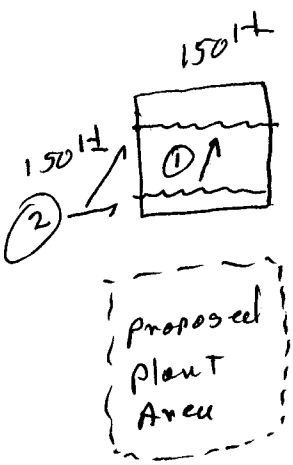

***** EVALUATION KEY *****

S = Suitable U = Unsuitable
PS = Provisionally Suitable
The "Area Classification" below indicates the suitability of areas in the diagram.

FACTORS	AREA 1	AREA 2	AREA 3	AREA 4	AREA 5	AREA 6
Topography	(S) PS U 2-8%	S PS (U) old Terraces	S PS U	S PS U	S PS U	S PS U
Texture	(S) PS U Slightly Expansive clay	S PS U	S PS U	S PS U	S PS U	S PS U
Structure	S (PS) U Sub Blocky	S PS U	S PS U	S PS U	S PS U	S PS U
Drainage	S (PS) U 7 TO 40" water	S PS U	S PS U	S PS U	S PS U	S PS U
Depth	S (PS) U >36"	S PS U	S PS U	S PS U	S PS U	S PS U
Restrictive Horizons	S (PS) U >36"	S PS U	S PS U	S PS U	S PS U	S PS U
Available Space	S (PS) U	S PS U	S PS U	S PS U	S PS U	S PS U
Other (specify)	S PS U	S PS U	S PS U	S PS U	S PS U	S PS U
Soil Group/Series	IV Cecil-Lloyd	old Terraces				
Area Classification	S (PS) U	S PS (U)	S PS U	S PS U	S PS U	S PS U

$150.00 4-20-93

977B/8849A

INDIVIDUAL WATER AND WASTEWATER SYSTEMS PROGRAM
APPLICATION FOR SERVICES

CR#29303

[] CRT

Mecklenburg County Health Dept.
Environmental Health Division
c/o Hal Marshall Ctr., Suite 211
700 N. Tryon St.
Charlotte, NC 28202

(704)336-5102

Date:

PERSON FILING APPLICATION:
NAME: FARMER (last) ANTHONY (first) (mi)
ADDRESS: P.O. Box 32487 PHONE: 704 394-8354
CITY: Charlotte STATE: NC ZIPCODE: 28232

PROPERTY INFORMATION (FROM ENGINEERING FORM):
TAX/PARCEL NUMBER: 193-241-07
STREET ADDRESS: SAM NEWELL Road
ZONING:

PROPERTY OWNER:
NAME: REA Construction Co. (last) (first) (mi)
ADDRESS: P.O. Box 32487 PHONE: (704 373-1331
CITY: Charlotte STATE: N.C. ZIPCODE: 28232

SUBDIVISION OR MOBILE HOME PARK NAME:

Township (check one):
[X] 0 Mecklenburg County [] 2 Davidson [] 4 Pineville [] 6 Huntersville
[] 1 Charlotte [] 3 Cornelius [] 5 Matthews [] 7 Mint Hill

TYPE APPLICATION (check one):

LOT NUMBER: LOT SIZE (in acres): 1 acre

[X] SOIL TEST - INDIVIDUAL LOT (D)
[] NEW CONSTRUCTION ON VACANT LOT - 4 BEDROOMS OR LESS (N)
[] EXCHANGE MOBILE HOME - SAME # BEDROOMS (Y)
[] ADDITION - INCREASE ROOMS/OCCUPANCY/MOBILE HOME SIZE (A or M)
[] COMMERCIAL OR INDUSTRIAL (N)
[] SOIL TEST DEVELOPMENT (P)
[] ADDITION - GARAGE OR RENOVATION/NO MAJOR CHANGES (X)
[] MODIFIED /ALTERNATIVE/ OR RESIDENCE > 4 BEDROOMS (Z)
[] REPAIR TO SYSTEM (R)

RESIDENTIAL PROPERTY (Type Building, check one):
[] SINGLE MOBILE HOME (S) [] HOUSE (H) [] MULTIPLE FAMILY (U)
[] DOUBLE WIDE (D) [] MODULAR HOME (M) [] OTHER _____ (O)

NUMBER BEDROOMS: NUMBER OCCUPANTS:

SYSTEM CLASSIFICATION:

COMMERCIAL/INDUSTRIAL PROPERTY:
Type Business HMA Facilities # Employees 4 Per Shift 1st
Industrial Wastes (Y/N) N
Underground Storage Tanks On Property (Y/N) N Type _____

WATER SUPPLY (check one):
[] Community (C) [] Shared Well (S)
[] Municipal (M) [] Other 'spring' (O)
[] Private Well (P)

FUTURE ADDITIONS - ALL PLANNED ADDITIONS MUST BE ENTERED (check all that apply):
[] Swimming Pool [] Jacuzzi [] Stable/Barn [] Workshop [] None
[] Garage [] Storage Building [] Deck/Patio [] Bedrooms [] Other

The undersigned, owner, or legal agent for the owner, of the property described above as the "JOB LOCATION" has read the foregoing application, acknowledges that the contents of same are true, and authorizes agents of the MECKLENBURG COUNTY HEALTH DEPARTMENT to enter onto the property for the purpose of processing this request.

Signed: James L Boggs Date: 4-20-93

NOTICE:

The undersigned, an authorized agent of the MECKLENBURG COUNTY HEALTH DEPARTMENT, certifies that the Department has approved the the Request for the Job Location contained in this document. This approval is granted in accordance with the provisions of Laws And Rules For Sanitary Sewage Collection, Treatment And Disposal in effect at the time of issuance of the permit and is subject to the following provisions:

...No work shall be conducted on the septic tank system until an installation, Construction, Alteration and/or Repair approval is granted by this Department.

...This permit is not transferable.

...

[] IMPROVEMENT PERMIT - VALID 60 MONTHS FROM ISSUANCE
[] MOBILE HOME EXCHANGE APPROVAL - VALID 6 MONTHS FROM ISSUANCE
[] ADDITION/RENOVATION APPROVAL - VALID 1 YEAR FROM ISSUANCE

Environmentalist Date

Director or Authorized Section Head Date

WWATER : 122791


PROPOSED PLOT PLAN

HEALTH DEPARTMENT
ENVIRONMENTAL HEALTH DIVISION
700 NORTH TRYON STREET
CHARLOTTE, NC 28202
PHONE (704) 336-5102

FILE: 977B/1849A

TC: 193-241-07 PO

Draw in and name all roads adjoining the property. Draw in and accurately dimension the lot concerned. Accurately indicate property boundaries, proposed and/or existing structures and driveways, underground utilities, and wells and springs within 100 feet of the proposed building or drainfield.

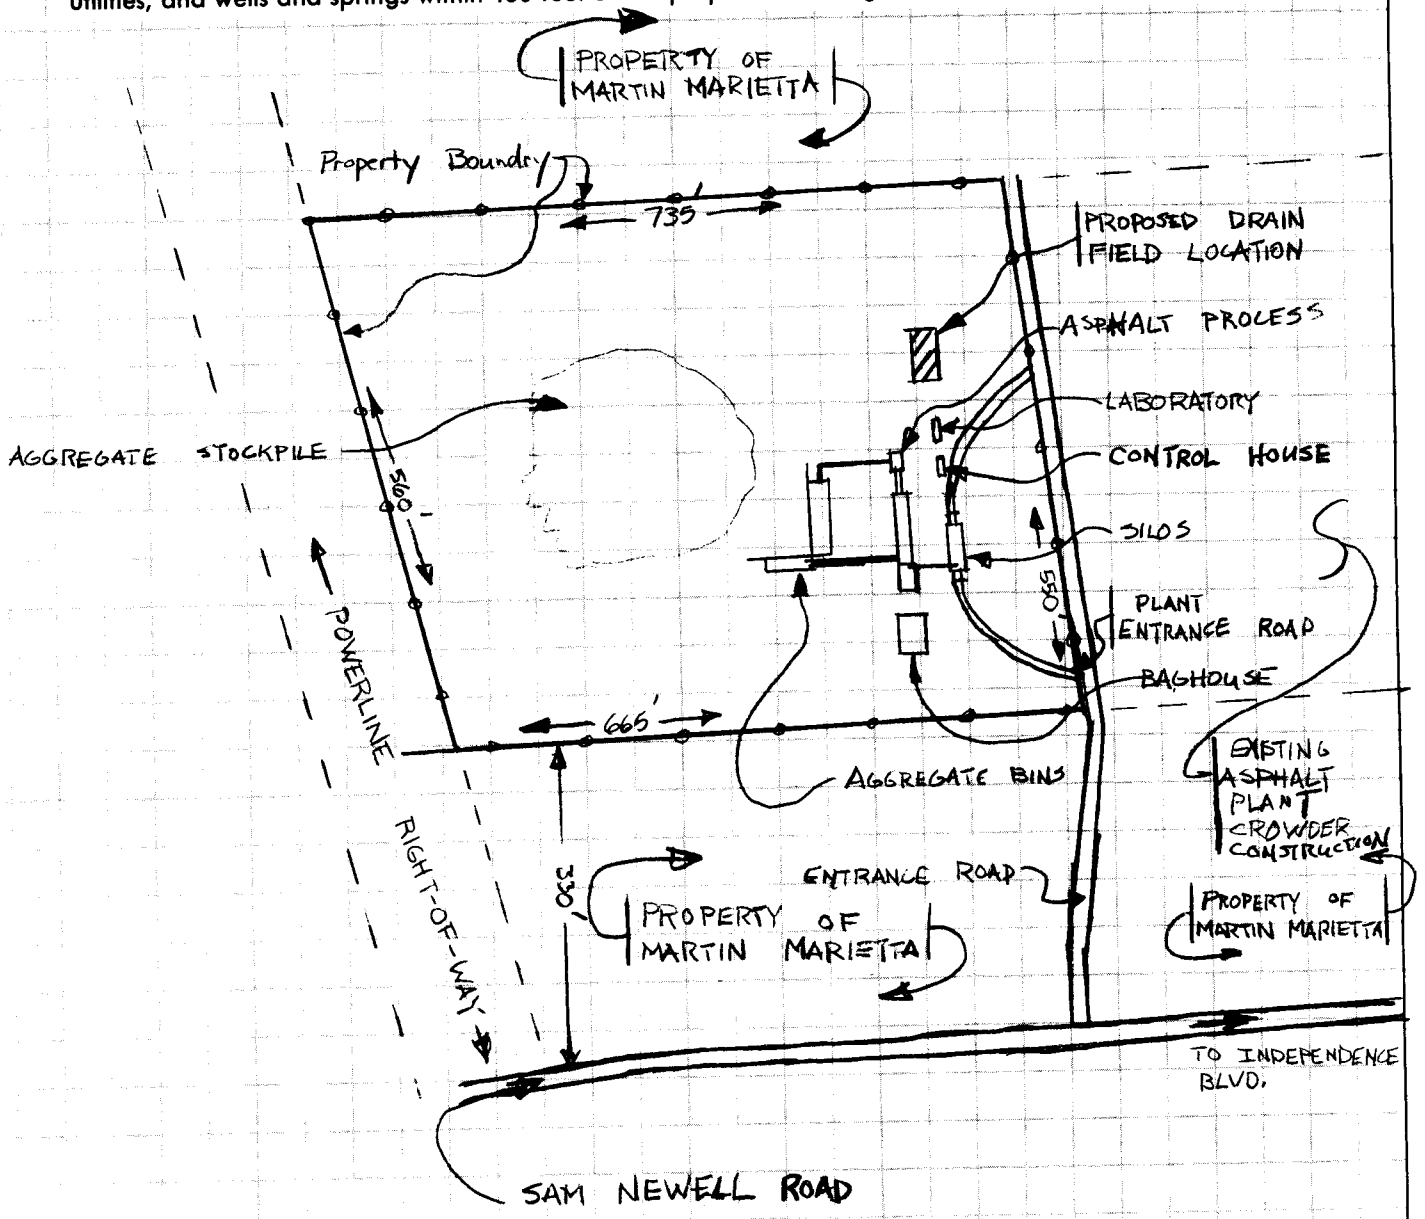

SCALE 1" = 200'

APPROVAL DATE _____

White - Health Department's Copy Canary - Environmentalist's Copy Pink - Owner's Copy

PROPOSED PLOT PLAN


HEALTH DEPARTMENT
ENVIRONMENTAL HEALTH DIVISION
700 NORTH TRYON STREET
CHARLOTTE, NC 28202
PHONE (704) 336-5102

FILE: 977B/8849A 1150.00 4-20-B

TC: 193-241-2078-B

977B/8849A

Draw in and name all roads adjoining the property. Draw in and accurately dimension the lot concerned. Accurately indicate property boundaries, proposed and/or existing structures and driveways, underground utilities, and wells and springs within 100 feet of the proposed building or drainfield.

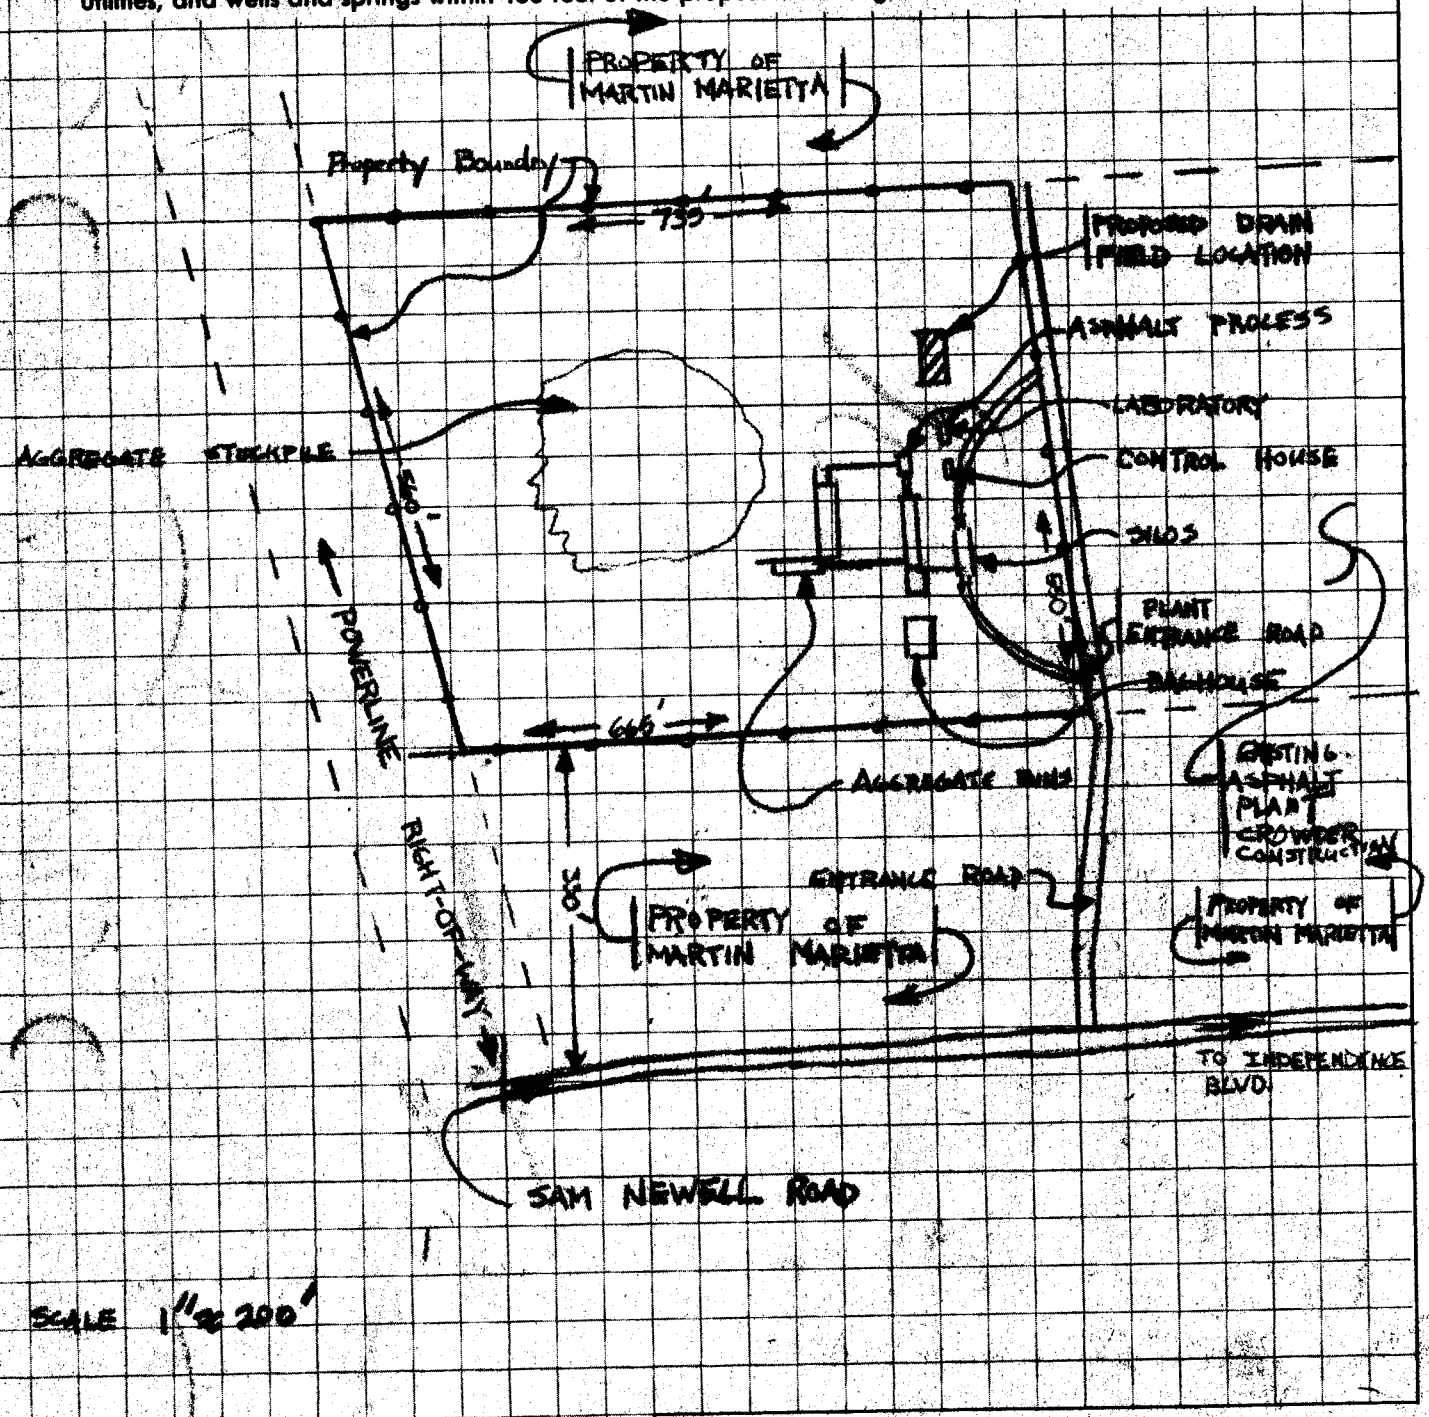


SCALE 1" = 200'

APPROVAL DATE _____

White - Health Department's Copy Canary - Environmentalist's Copy Pink - Owner's Copy

File 9728 / 8549A

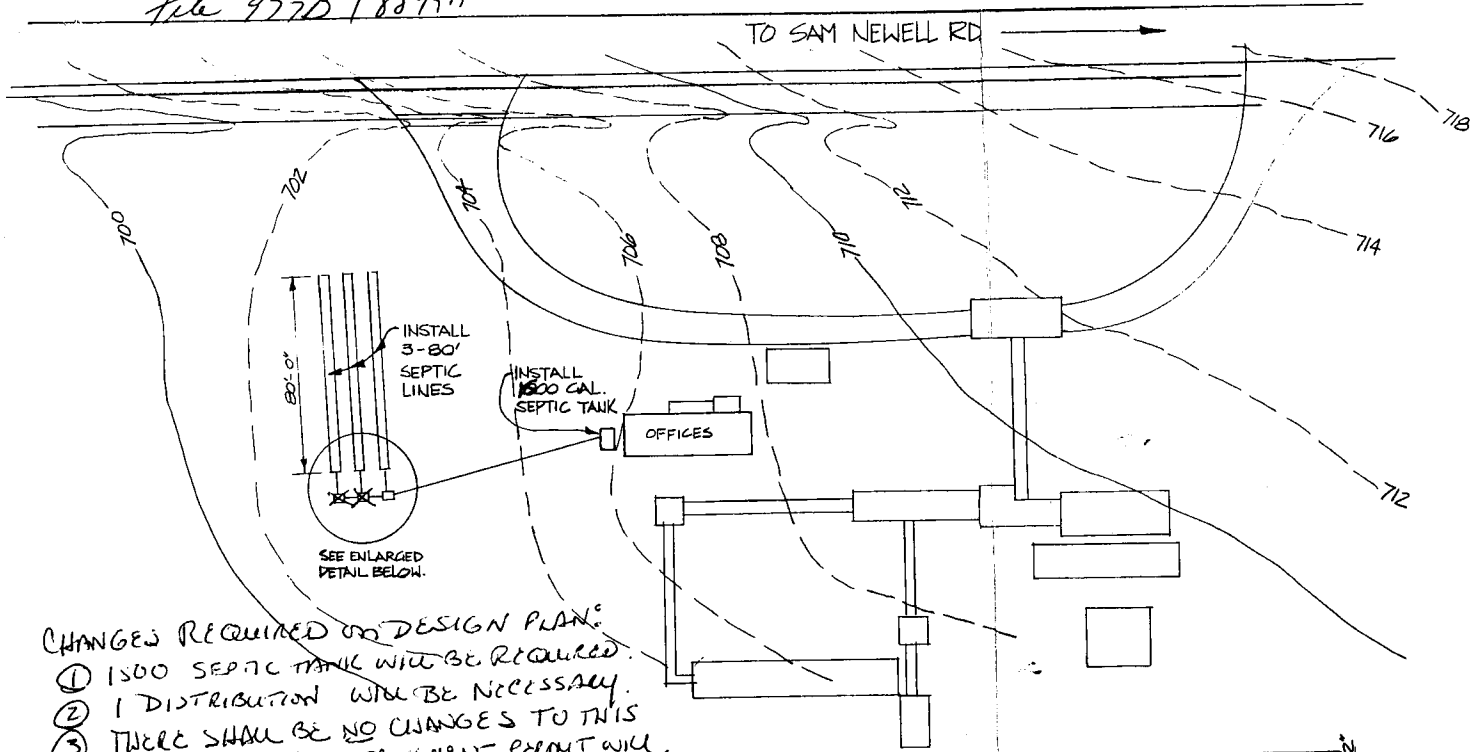

GENERAL NOTES


1. Lay distribution pipes along trenches level.
2. Overfill all trenches to allow for settlement of the trenches in the future.
3. All backfilled soils shall be compacted to 95% Standard Proctor.
4. Schedule 40 and 80 PVC pipe shall be solvent weld, Type 1, Grade 1 conforming to ASTM D1784 and D1785. Fittings shall conform to ASTM D2466.
5. Septic tank and distribution boxes shall be precast concrete boxes laid level.
6. SDR 26, Sewer pipe shall be solvent weld, Grade 1, conforming to ASTM D3034


CHANGES REQUIRED ON DESIGN PLANS

1. 1500 SEPTIC TANK WILL BE REQUIRED.
2. 1 DISTRIBUTION WILL BE NECESSARY.
3. THERE SHALL BE NO CHANGES TO THIS PERMIT OR THE IMPROVEMENT PERMIT WILL BE VOID.


T. Newell, R.S. 5/19/93


Anthony Farmer

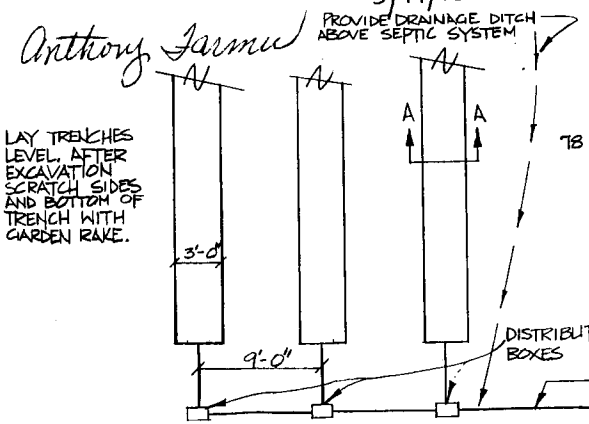

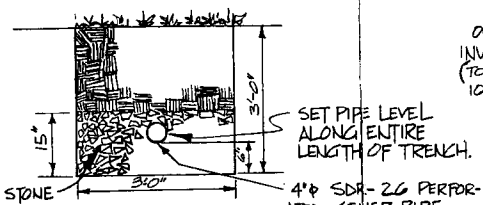

SECTION A-A
N.T.S.

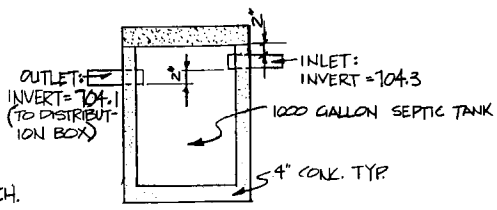

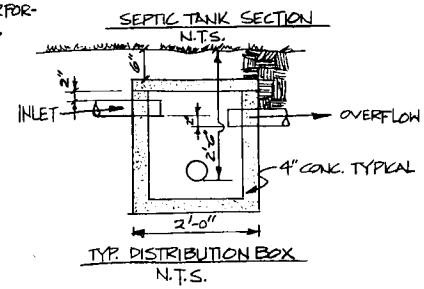

TYP. DISTRIBUTION BOX
N.T.S.

NORTH CAROLINA PROFESSIONAL ENGINEER GREGORY E. WALDEN 18583 5/10/93

SEPTIC SYSTEM
REA CONSTRUCTION COMPANY

YOUNG ENGINEERING, INC.
P.O. BOX 560863
CHARLOTTE, N.C. 28256

PROJECT MANAGER: GEW	DATE: 05-07-93
DRAWN BY: EGW	SCALE: 1"=50'-0"
CHECKED BY: DTY	PAGE: 1